


D:\CAD PROJECTS\235 NORTHERN STAR RESOURCES LTD\23517 KCGM GROWTH PROJECT\03 DELIVERABLES\VE\F24 - AIR & WATER SERVICES\2000-F24-BLK-IC-10501.DWG 16SEP25 4:04PM HOTSEAT104

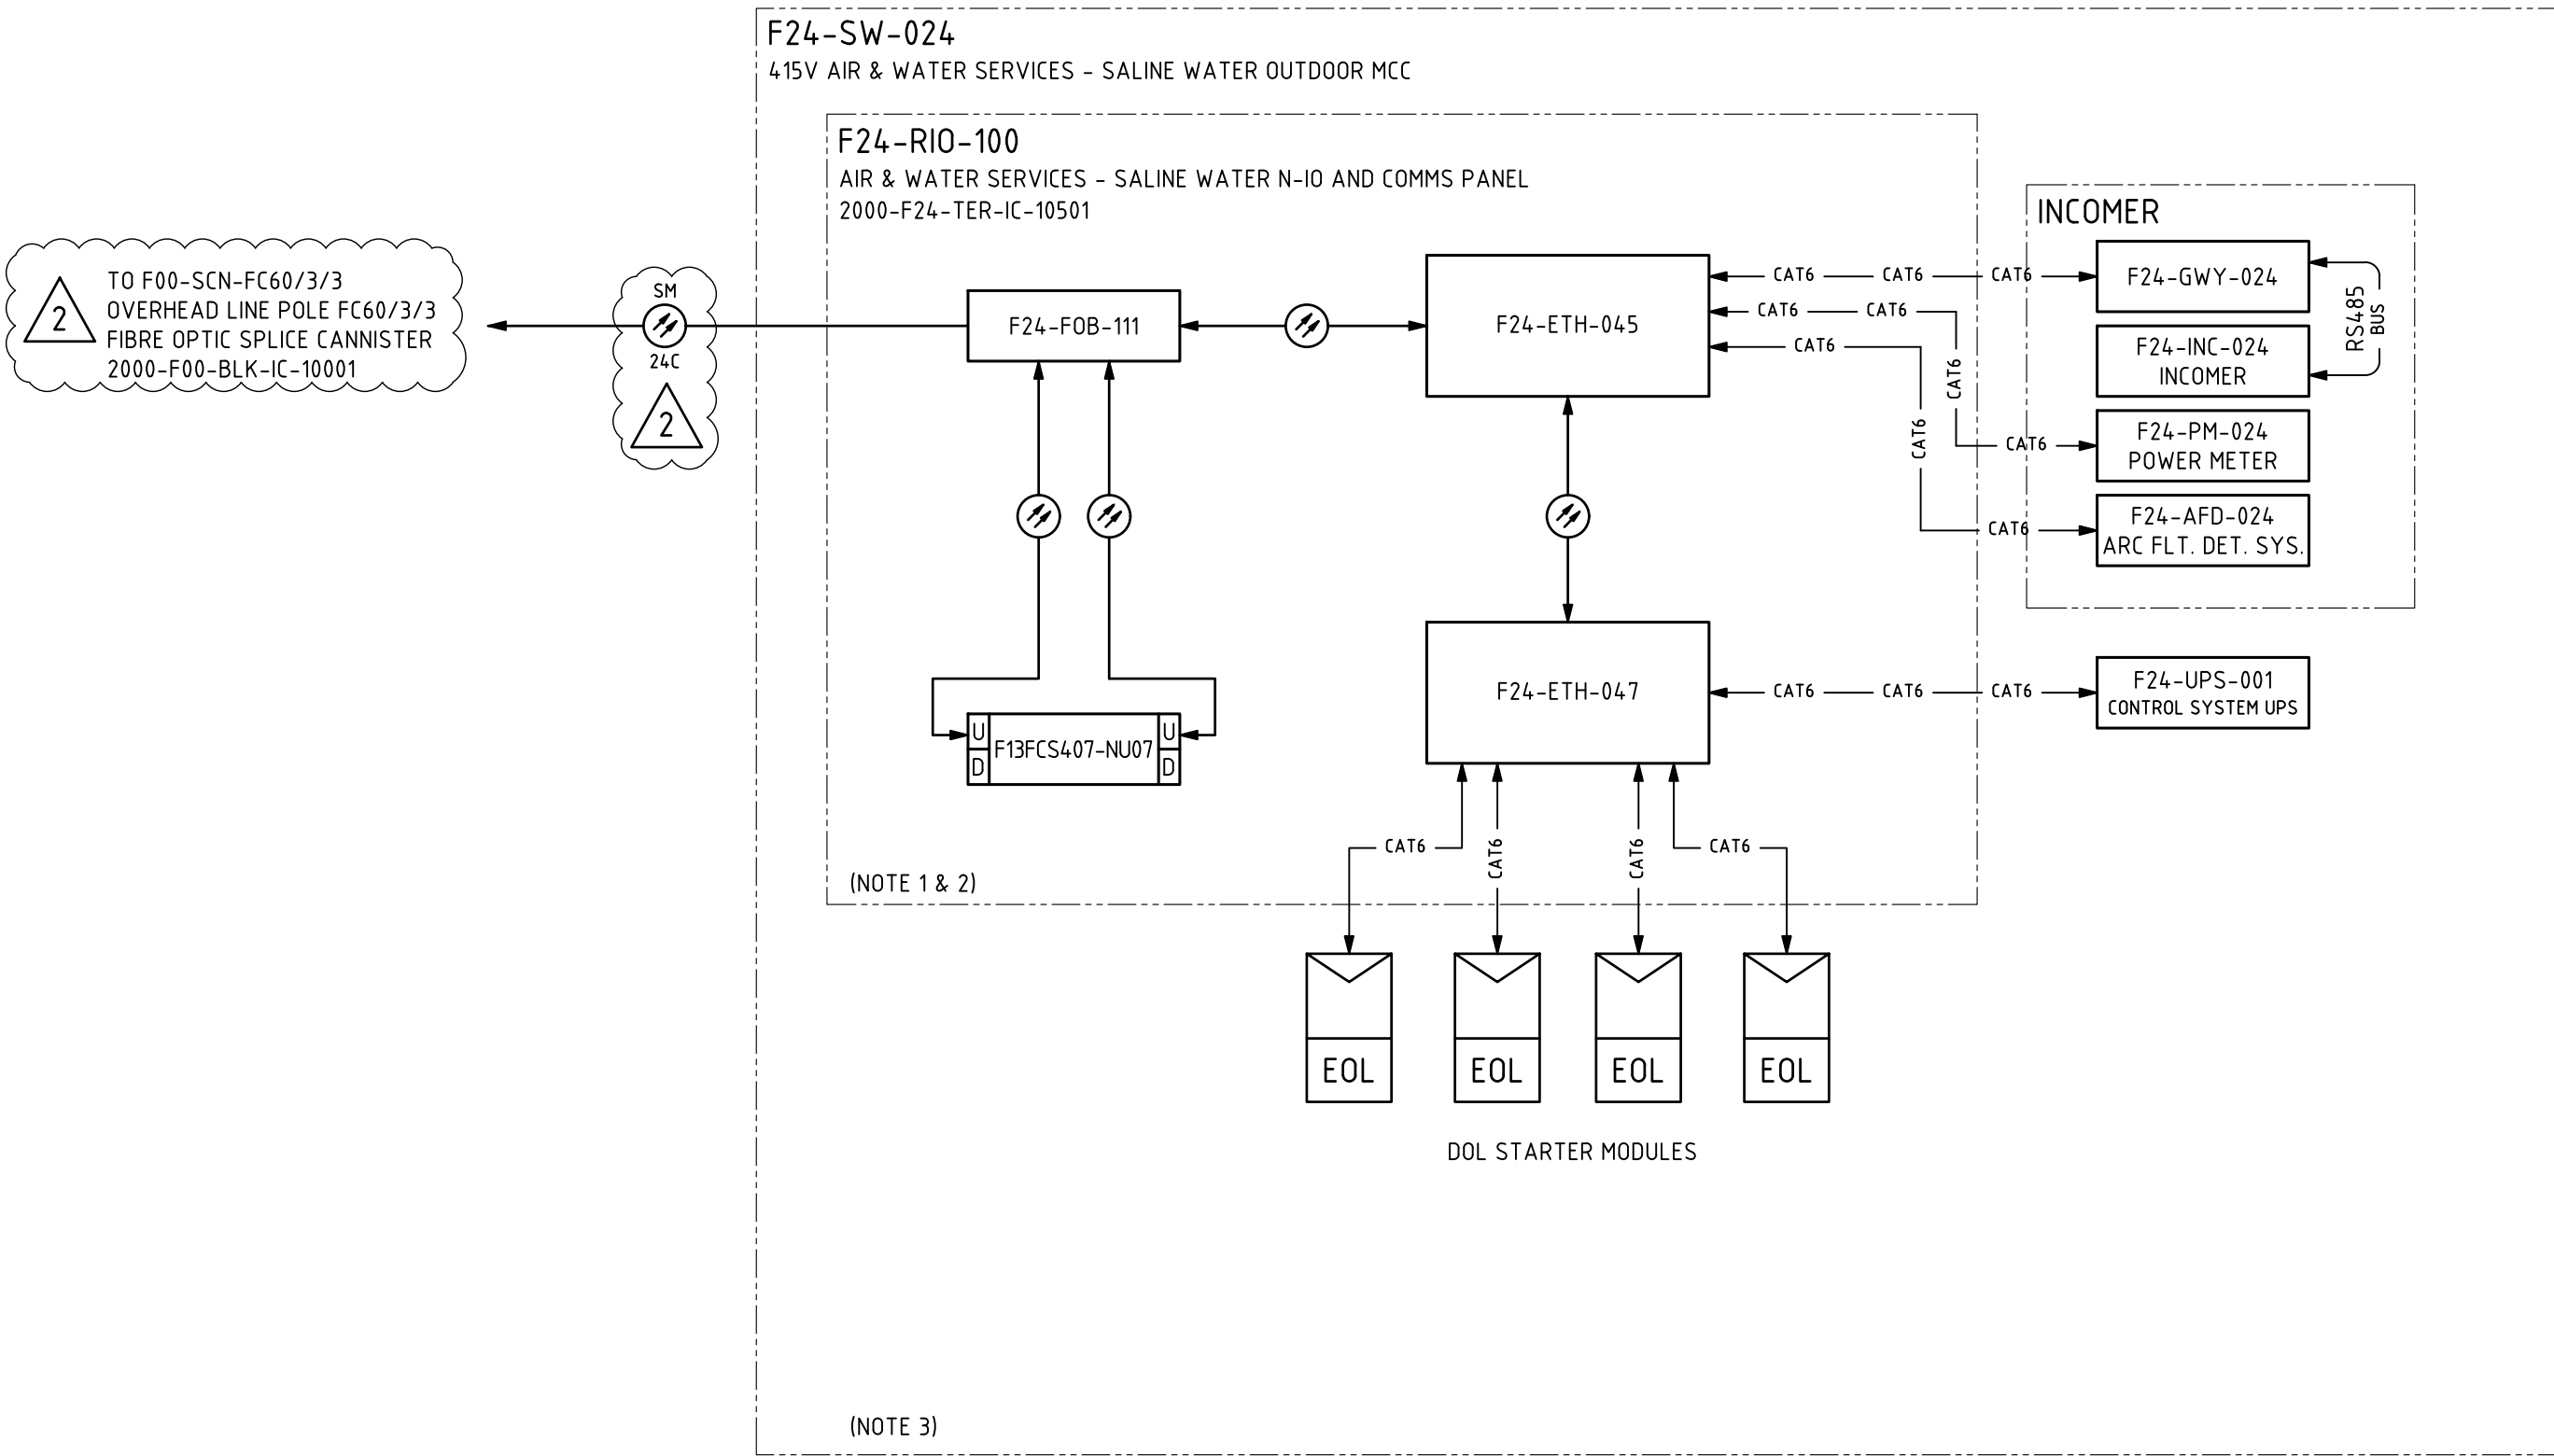

NOTES

- FOR INTERNAL FIBRE OPTIC, CAT6 PATCH LEAD EQUIPMENT CONNECTION DETAILS REFER TO SPECIFIC TERMINATION DIAGRAMS.
- REFER TO SPECIFIC COMMUNICATIONS TERMINATION DRAWINGS FOR EXTERNAL EQUIPMENT CONNECTION DETAIL.
- RIO PANEL, MCC & SWITCHBOARD HARDWARE/INTERCONNECTIONS (E.G. NIO NODE) & INTER-FOBOT PATCHING NOT SHOWN FOR CLARITY. REFER TO SPECIFIC COMMUNICATIONS TERMINATION DRGS FOR DETAIL.

LEGEND

FOB	FIBRE OPTIC BREAK OUT TRAY
ETH	ETHERNET SWITCH HIRSCHMANN = DCS NETWORKS CISCO = ALL OTHER NETWORKS
FCS	YOKOGAWA FIELD CONTROL UNIT
xxxFCS4xxx-NUxx	YOKOGAWA NODE INTERFACE UNIT (DUAL OPTICAL ESB PORTS; U = UPLINK, D = DOWNLINK) TAG RELATED TO PARENT FCS
GWY	COMMUNICATIONS GATEWAY
MC	FIBRE TO CAT6 MEDIA CONVERTER
xxx	EQUIPMENT OR VENDOR PACKAGE PANELS AS NOTED WITHIN BLOCK.
EOL	MCC MODULE DOL INTELLIGENT ELECTRONIC DEVICE/OVERLOAD
UPS	UNINTERRUPTIBLE POWER SUPPLY
VSD	VARIABLE SPEED DRIVE (WALL MOUNTED)
MC	MULTI CORE FIBRE OPTIC CABLE OR DUPLEX PATCH LEAD
CAT6	CAT6 ETHERNET CABLE CONNECTION

AS CONSTRUCTED

CHANGE: ☐ NO CHANGE: ☒

SIGNATURE: *George Forrest*
NAME: GEORGE FORREST
DATE: 2025/12/06

ENGINEER SIGN OFF

SIGNATURE: *Sanam Gurung*
NAME: SANAM GURUNG
DATE: 2025/12/06

DRG No.	REFERENCES	REV	DATE	DESCRIPTION	DRAW	CHECK	DESIGN	TECH APP	PROJ APP
2000-F24-TER-IC-10501	F24-SW-024 MCC N-IO AND COMMS PANEL TERMINATION DIAGRAM SHEET 1	2	08SEP25	FAT REDLINES INCORPORATED					
2000-F00-BLK-IC-10001	OVERALL SITEWIDE COMMUNICATIONS BLOCK DIAGRAM	1	03FEB25	CORE SIZE UPDATED.					
2000-F00-BLK-IC-10011	OVERALL SITEWIDE NETWORK ARCHITECTURE BLOCK DIAGRAM SHEET 1 (TO SHEET 5 -10015)	0	12NOV24	APPROVED FOR CONSTRUCTION					
2000-F00-DRG-EL-10001	GENERAL NOTES AND STANDARD DRAWINGS INDEX								



INFORMATION AND REPRESENTATIONS ON THIS DRAWING ARE THE INTELLECTUAL PROPERTY OF PRIMERO UNLESS SPECIFICALLY IDENTIFIED OTHERWISE. ALL RIGHTS INCLUDING USE RESERVED

PROJECT:	NORTHERN STAR RESOURCES LTD KCGM GROWTH PROJECT
TITLE:	AIR & WATER SERVICES - SALINE WATER F24-SW-024 AND REMOTE IO COMMUNICATIONS BLOCK DIAGRAM
SHEET	A1
SCALE	NONE
DRG No.	2000-F24-BLK-IC-10501
REVISION	2RL1