


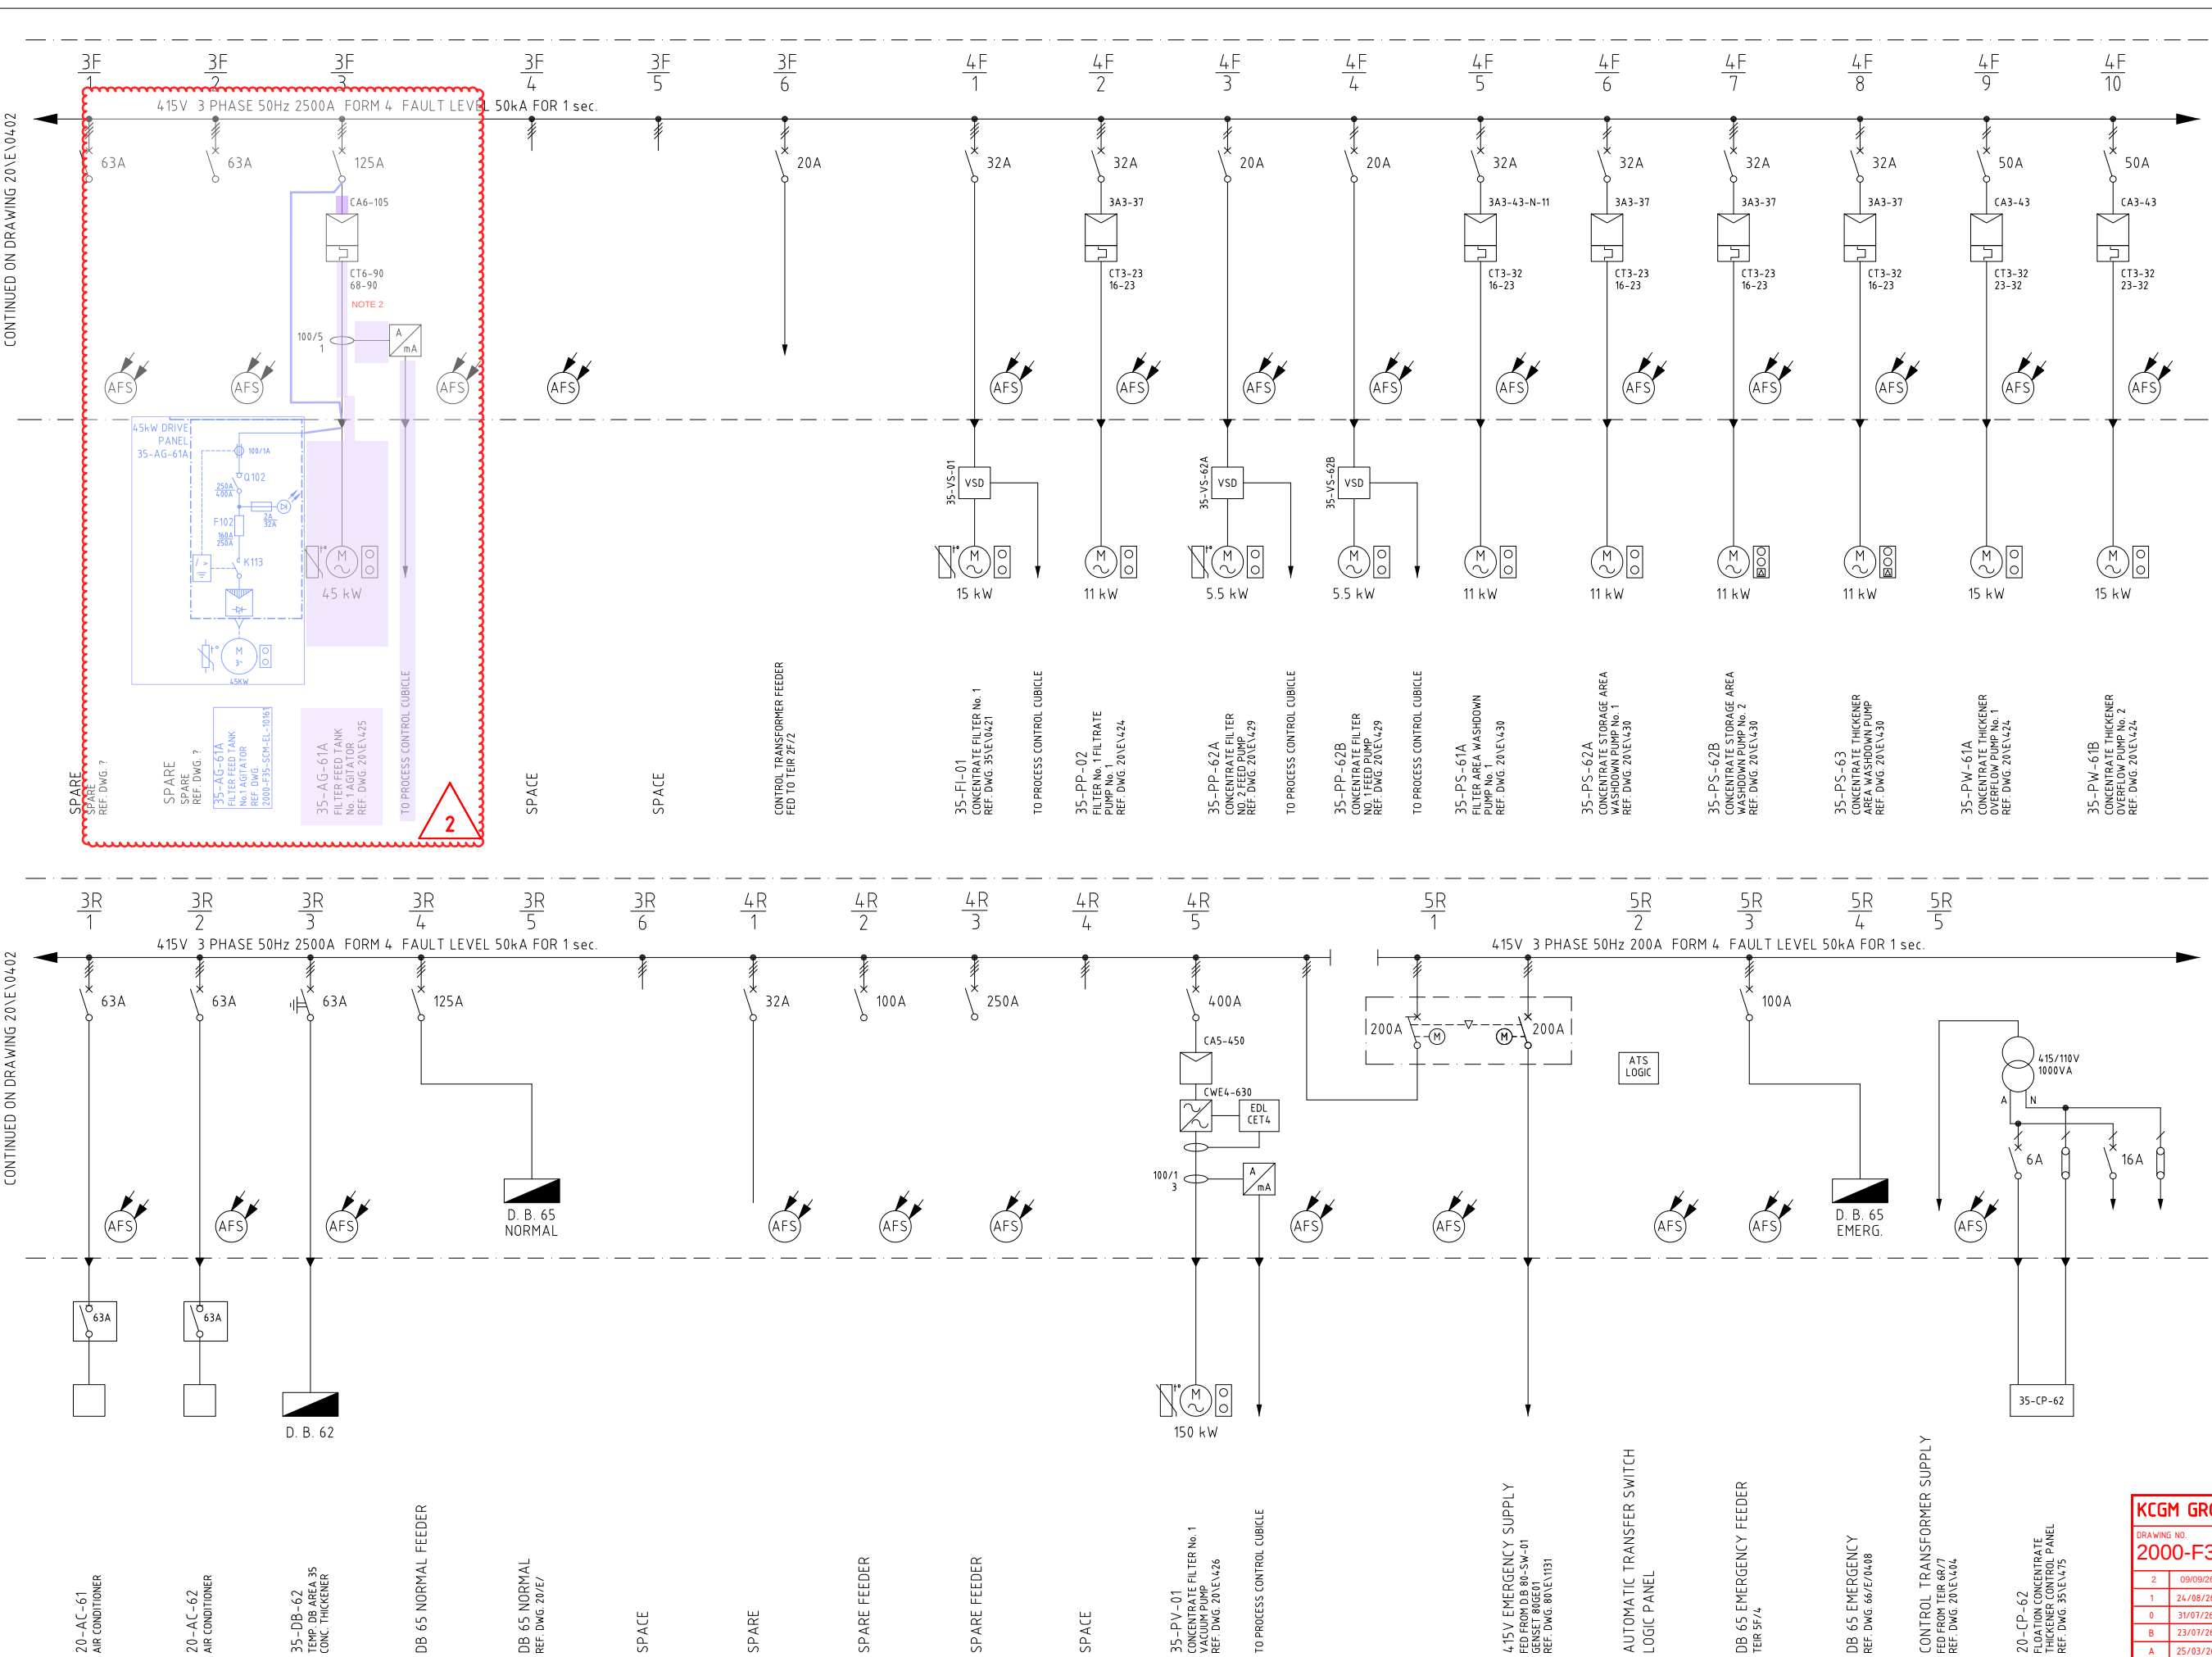

LEGEND

LOCATION

SUB STATION 35
20-SW-62

NOTES

1. ALL AFS (ARC FLASH SENSORS) ARE CONNECTED TO THE ARC FLASH RELAY VIA I/O UNITS

2. EXISTING CONTACTOR, OVERLOAD, CT, AMMETER CIRCUIT, AND ASSOCIATED CONTROL WIRING TO BE DISCONNECTED AND RETAINED IN BUCKET.

LEGEND

EXISTING

NON-EXISTENT

STAGE 1 - NEW

STAGE 1 - REMOVE

STAGE 1 - DECOMMISSIONED (OTHERS)

STAGE 2 - NEW

STAGE 2 - REMOVE

STAGE 2 - DECOMMISSIONED (OTHERS)

12	14/11/17	ARC FLASH SENSORS INSTALLED	RH	JMR	JMR	6	3/95	REVISED AS NOTED	AH	JAM			SCALE	NTS		FIMISTON PLANT	SIZE	DRAWING NUMBER	REV
11	31/03/16	35F101 INFO UPDATED	WL			5	11/94	REVISED AS NOTED		JAM			DRAWN		1994	FIMISTON RECYCLE CRUSHING	A1	20\0403	14
10	22/02/07	35PP62B VSD REPLACEMENT, AS BUILT FEB 2007				4	10/94	REVISED AS NOTED		JAM			DESIGNED		1994	SUBSTATION No 35 415V MCC 20-SW-62			
9	14/04/05	GENERAL REVISION				3	9/94	20-PP-61A,B ADDED		JAM			CHECKED		1994	SINGLE LINE DIAGRAM SHEET 2			
8	10/12/98	AS BUILT & REDRAWN TO KCGM STANDARDS	CV			14	16/08/19	2019 S.L.D. UPDATE PROJECT "AS BUILT"		RH			APPROVED	MRD/JM	03/07/14				
7	8/97	CONSOLIDATION PROJECT	FW			13	19/06/19	2019 S.L.D. UPDATE PROJECT "AS BUILT"		RH			PROJ.APP	MINPROC	1994				
MK	DATE	REVISION	BY	CKD	APP	MK	DATE	REVISION	BY	CKD	APP		REFERENCE DRAWINGS		DWG NO.	PROJ. FILE #	KALGOORLIE CONSOLIDATED GOLD MINES PTY. LTD. ABN 009 377 619 003		