


D:\CAD PROJECTS\2351 NORTHERN STAR RESOURCES LTD\23517 KCGM GROWTH PROJECT\03 DELIVERABLES\EL\F12 - PRIMARY CRUSHING\2000-F12-SLD-EL-1021.DWG 13AUG25 11:52AM HOT SEAT 04

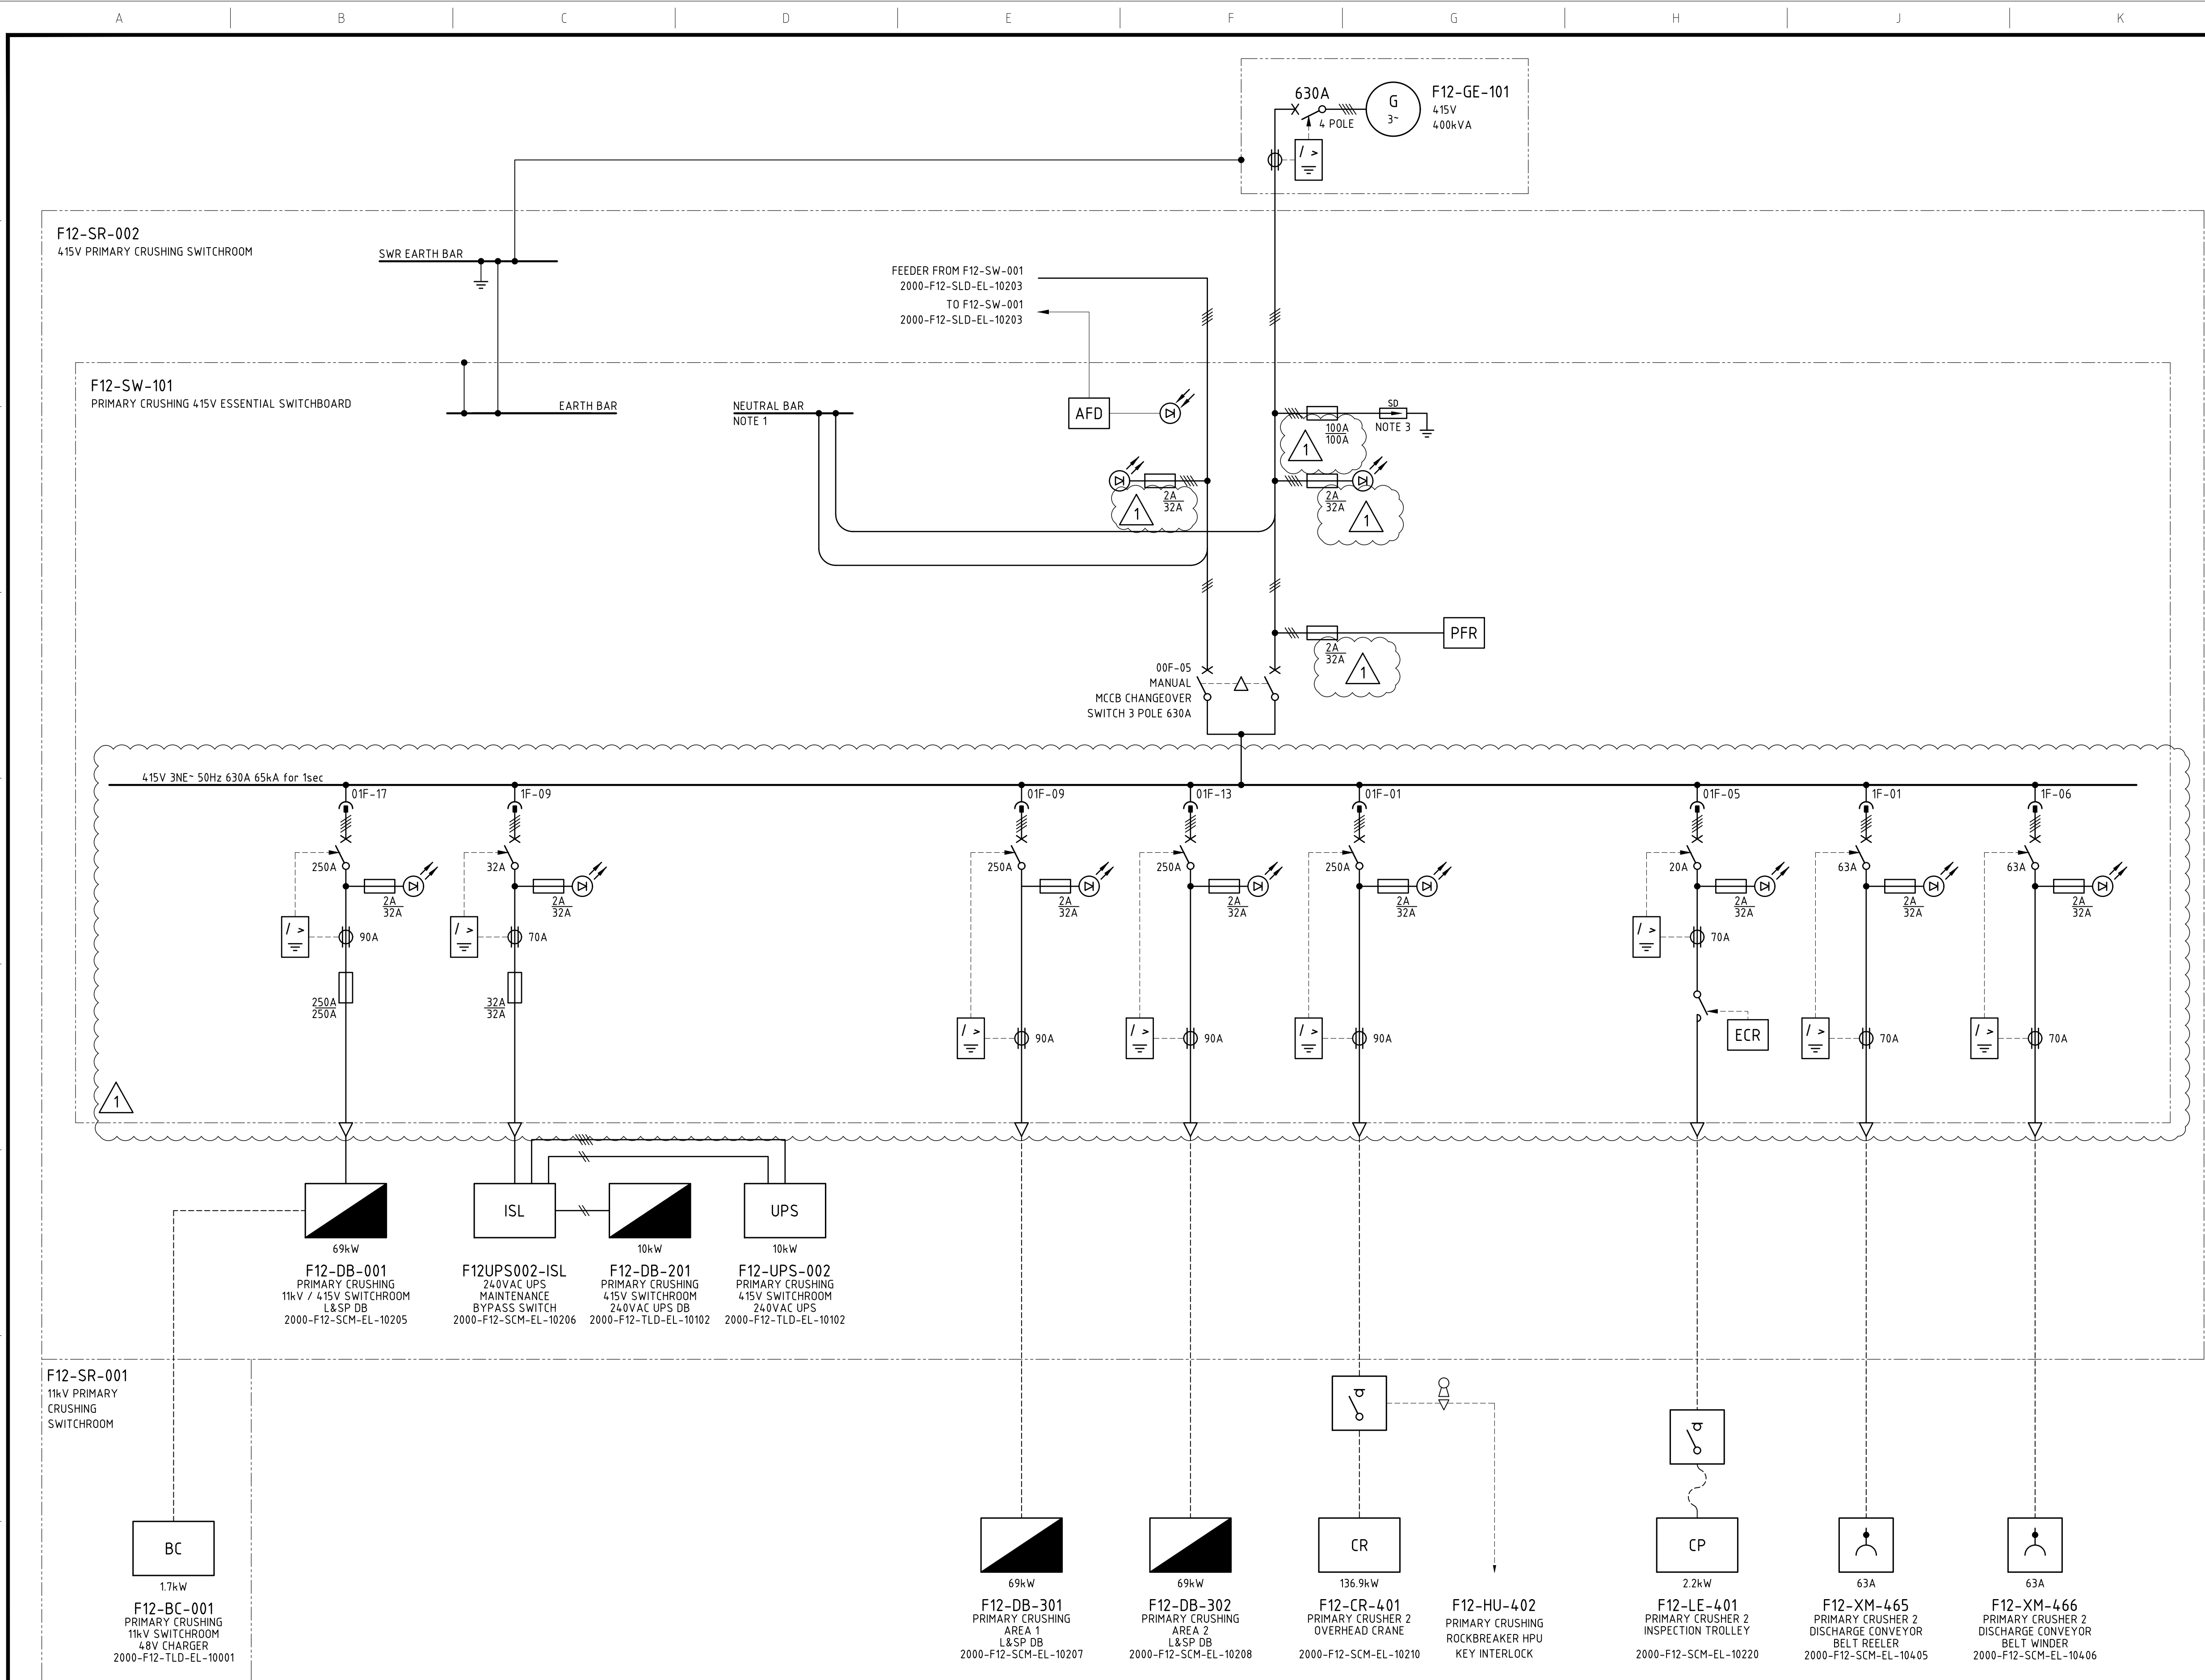

- ### NOTES
- EARTH-NEUTRAL LINK INSTALLED IN UPSTREAM F12-SW-001 INCOMER TIER. SIGNAGE SHALL BE PLACED ON F12-SW-101 SWITCHBOARD AND ON GENERATOR READING "M.E.N. LINK LOCATED IN F12-SW-001 INCOMER TIER"
 - SWITCHBOARD SHALL BE EXTENSIBLE AND BE PROVIDED WITH THE FACILITY TO EXTEND THE MAIN BUSBAR AND APPEND ADDITIONAL TIERS AT ONE END WITHOUT MAJOR STRUCTURAL DISASSEMBLY.
 - SURGE DIVERTERS SHALL PROVIDE FEEDBACK TO DCS VIA VOLT-FREE CONTACTS. SURGE DIVERTER FUSES SHALL BE SIZED BY VENDOR TO SUIT DUTY.
 - MINIATURE CIRCUIT BREAKERS SHALL BE SIZED AND RATED TO SUIT ACB AND INCOMER REQUIREMENTS.
 - CIRCUIT BREAKER TO BE SUBSTITUTED FOR FUSED-SWITCH WHERE REQUIRED BY EQUIPMENT MANUFACTURERS GUIDELINES.

- ### LEGEND
- PFR PHASE FAILURE RELAY
 - EARTH LEAKAGE RELAY
 - ST TRIP SET POINT
CB SIZE
 - AFD ARC FLASH DETECTION
 - ECR EARTH CONTINUITY RELAY
 - 63A 3 PHASE SOCKET OUTLET
 - KEY-OPERATED INTERLOCK

Approved	☒
Approved as Noted	☐
Not Approved	☐
For Information Only	☐
Signed	Date
	04/09/2025
ACCEPTANCE DOES NOT RELIEVE THE SUPPLIER / CONTRACTOR OF ITS RESPONSIBILITY OR LIABILITIES UNDER THE PURCHASE ORDER / CONTRACT	

DRG No.	REFERENCES	REV	DATE	DESCRIPTION	DRAW	CHECK	DESIGN	TECH APP	PROJ APP
2000-F12-SCM-EL-10203	F12-SW-001 415V MCC ARC FLASH SYSTEM SCHEMATIC DIAGRAM								
2000-F12-SCM-EL-10202	F12-SW-001 415V MCC 24VDC DISTRIBUTION SCHEMATIC DIAGRAM								
2000-F12-SCM-EL-10233	F12-SW-101 415V ESSENTIAL SWITCHBOARD INCOMER SCHEMATIC DIAGRAM								
2000-F12-DRG-EL-10001	F12-SR-002 415V SWITCHROOM ELECTRICAL EQUIPMENT LAYOUT								
2000-F12-BLK-IC-10001	F12-SR-002 415V SWITCHROOM AND REMOTE I/O COMMUNICATIONS BLOCK DIAGRAM								
2000-F12-SLD-EL-10201	F12-SW-001 415V MCC SINGLE LINE DIAGRAM SHEET 1								
2000-F00-SLD-EL-10002	F00-SW-010 33kV SWITCHBOARD SINGLE LINE DIAGRAM SHEET 1 OF 5	1	18JUL25	FAT REDLINES INCORPORATED					
2000-F00-STD-EL-10001	GENERAL NOTES AND STANDARD DRAWINGS INDEX	0	29AUG24	APPROVED FOR CONSTRUCTION					



INFORMATION AND REPRESENTATIONS ON THIS DRAWING ARE THE INTELLECTUAL PROPERTY OF PRIMERO UNLESS SPECIFICALLY IDENTIFIED OTHERWISE. ALL RIGHTS INCLUDING USE RESERVED

PROJECT:	NORTHERN STAR RESOURCES LTD KCGM GROWTH PROJECT		
TITLE:	PRIMARY CRUSHING F12-SW-101 415V ESSENTIAL SWITCHBOARD SINGLE LINE DIAGRAM		
SHEET	SCALE	DRG No.	REVISION
A1	NONE	2000-F12-SLD-EL-10211	1