


DISTRIBUTION BOARD NO. 62

240V 1PHASE+N 50Hz 250A
FAULT LEVEL 20kA FOR 0.3 sec.
POSITIONED IN SUBSTATION No.60

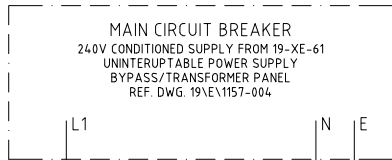

CYCLOCONVERTER ROOM FIRE INDICATION PANEL 19-FPD-61 REF. DWG. 19\E\	16A	R1
GPO IN 19PC61, CABINET AR - 19-COM-01 REF. DWG. 19\E\	16A	R2
TI19874A REF. DWG. 19\E\	10A	R3
TI19875A REF. DWG. 19\E\	10A	R4
CANTRY PROCESS CAMERA REF. DWG. 19\E\	16A	R5
F19-COM-401 BALL CHARGER CCTV CONTROL PANEL REF. DWG. 2000-F19-DRG-EL-10101	10A	R6

R7	16A	240V AC POWER SUPPLY TO CONTROL PANEL 19-CP-58 REF. DWG. 19\E\
R8	16A	240V AC POWER SUPPLY TO DCS CUBICLE 19-PC-61 REF. DWG. 19\E\
R9	10A	SIEMENS ROOM GPO, PG750
R10	16A	GPO EAST FIM SAG
R11	16A	CYCLOCONVERTER COMPUTER 4 WAY GPO
R12	10A	MICROPHONE GPO

1


ELECTRICAL CONTRACTOR TO CONFIRM
AVAILABILITY OF SPARE CIRCUIT. REPLACE
EXISTING MCB WITH 10A RCD MCB AS SHOWN

LEGEND

- CIRCUIT BREAKER
- ISOLATOR
- CIRCUIT BREAKER RCD 30mA

LOCATION

SUB STATION 60
19-DB-62

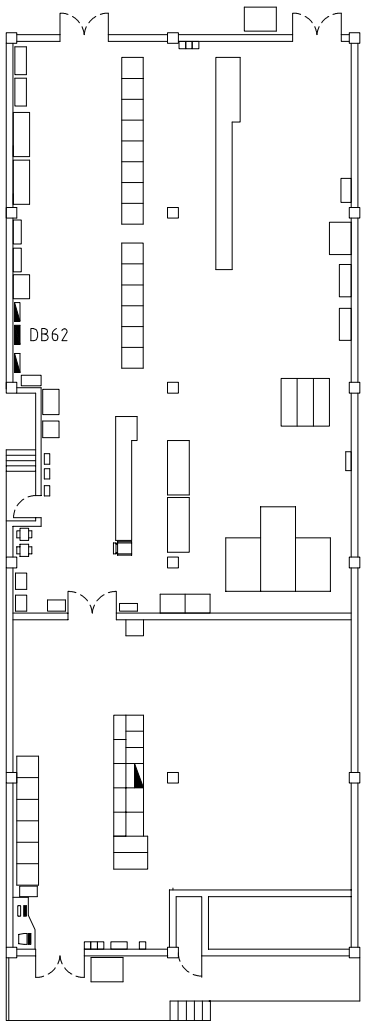

NOTES

PRIMERO
primero.com.au | DESIGN | CONSTRUCT | OPERATE

KCGM GROWTH PROJECT

DRAWING NO.

2000-F19-TLD-EL-10002

REV.: 1

DESIGN APPR.: *JB*

DATE: 09/11/23

								4C	01/10/19	RE-ISSUED FOR CONSTRUCTION	PGI	PDW	DP	SUB STATION No.60 DCS CUBICLE 19-PC-51 AND 19-PC-61 MARSHALLING TERM.	19\ E\ 1167-1168	SCALE	NTS		FIMISTON PLANT MILLING AND CLASSIFICATION 240V INSTRUMENT DISTRIBUTION BOARD No.62 POWER SCHEMATIC	A1	19\ E\ 1160-002	6
								4B	25/02/19	ISSUED FOR CONSTRUCTION	RH	DC	DC	SUB STATION No.60 MCC 19-SW-61, 63 CABLE ZONE TERMINATIONS	19\ E\ 1163-1164	DRAWN	G.SOFIELD	10/10/97				
								4A	20/02/19	IFR - SIEMENS UPGRADE PROJECT	RH	DC	DC	SUB STATION No.60 POWER SCHEMATICS	19\ E\ 1160	DESIGNED	G.SOFIELD	10/10/97				
								3	23-4-04	AS BUILT APRIL 2004	BJ	DB		SUB STATION No.60 MCC 19-SW-51, 61, 62, 63 SINGLE LINE DIAGRAMS	19\ E\ 1155-1159	CHECKED	G.SOFIELD	10/10/97				
6	25/03/22	SUBSTATION LAYOUT UPDATED	RH	RH	RH	2	11/97	FIMISTON SAG LOAD CELL	CV					SUB STATION No.60 MCC 19-SW-51, 61, 62, 63 DRIVE PANEL LAYOUT	19\ E\ 1150-1153	APPROVED	A.BRADY	10/10/97	KALGOORLIE CONSOLIDATED GOLD MINES PTY. LTD. ACN 009 377 619			
5	22/03/22	REVISION 4 SIERIES NOT IMPLEMENTED - ASBUILT	RH	GEC	JMR	1	10/97	'AS BUILT' FIMISTON PLANT 1997 CONTRACT# 700746	G.S	G.S	A.B			SUB STATION No.60 MCC AND GENERAL EQUIPMENT LAYOUT	19\ E\ 1050	PROJ.APP	A.BRADY	10/10/97				
MK	DATE	REVISION	BY	CKD	APP	MK	DATE	REVISION	BY	CKD	APP			REFERENCE DRAWINGS	DWGN NO.	PROJ. FILE #						