


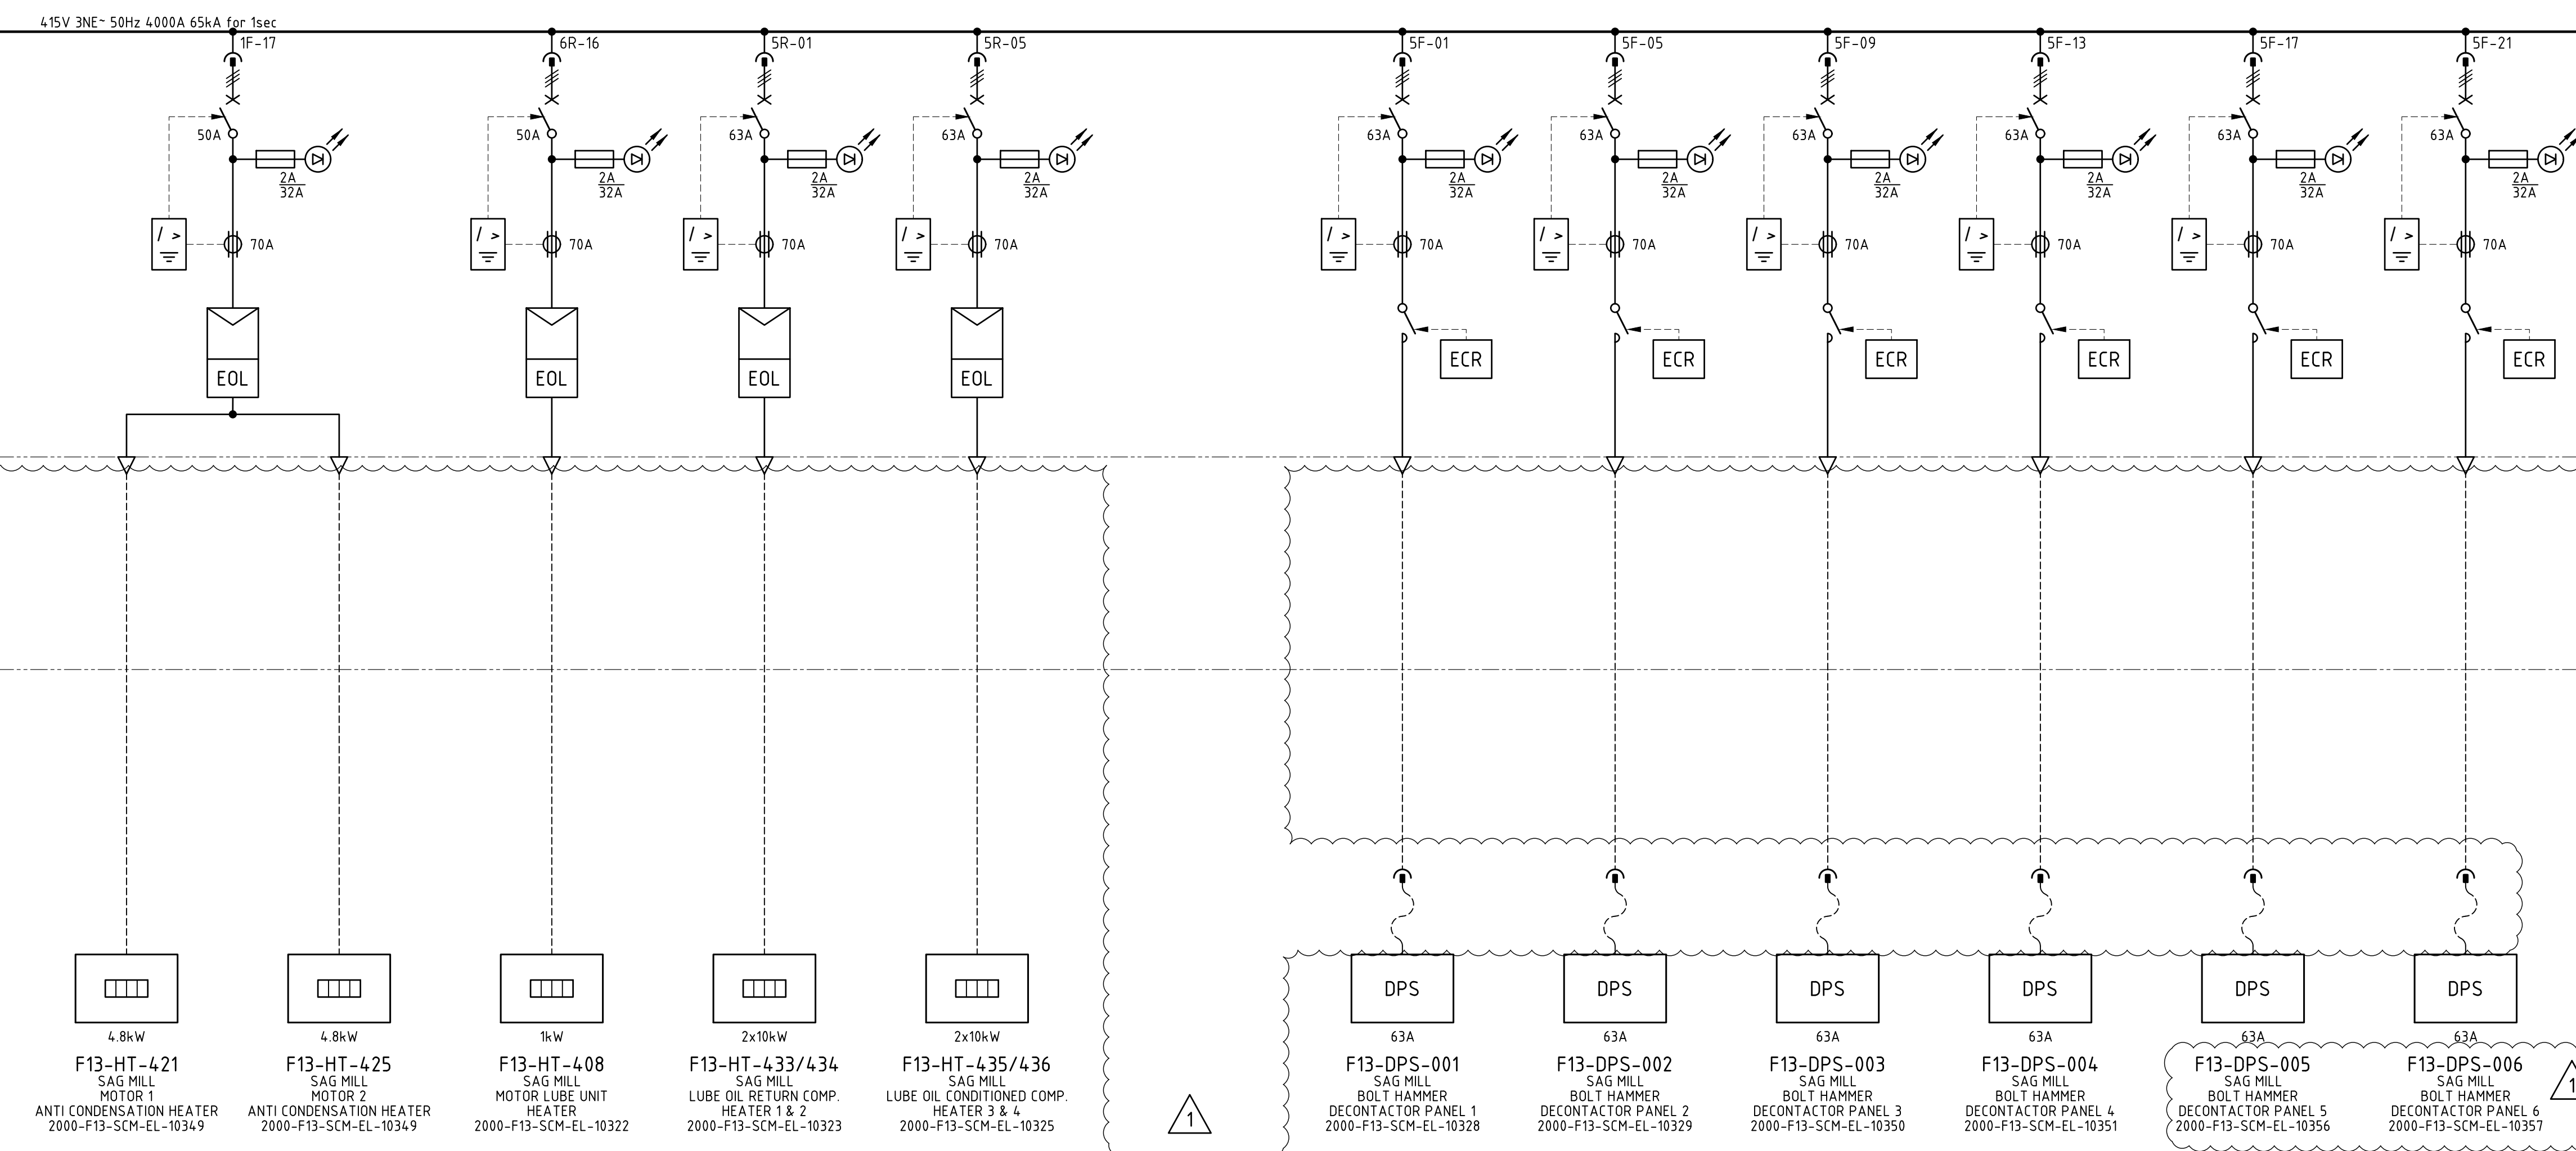

CONTINUED ON SHT 1  
000-F13-SLD-EL-10301

CONTINUED ON SHT 3  
000-E13-SID-EL-10303

[illegible]

**PRIMERO**  
 primero.com.au | DESIGN | CONSTRUCT | OPERATE  
 PRIMERO PROJECT NUMBER: 23517

INFORMATION AND REPRESENTATIONS ON THIS DRAWING ARE THE INTELLECTUAL PROPERTY OF  
PRIMERO UNLESS SPECIFICALLY IDENTIFIED OTHERWISE. ALL RIGHTS INCLUDING USE RESERVED

|          |       |                                                                                           |          |
|----------|-------|-------------------------------------------------------------------------------------------|----------|
| PROJECT: |       | NORTHERN STAR RESOURCES LTD<br>KCGM GROWTH PROJECT                                        |          |
| TITLE:   |       | MILLING & CLASSIFICATION - SAG MILL<br>F13-SW-002 415V MCC<br>SINGLE LINE DIAGRAM SHEET 2 |          |
| SHEET    | SCALE | DRG No.                                                                                   | REVISION |
| A1       | NONE  | 2000-F13-SLD-EL-10302                                                                     | 1        |

## NOTES

1. REFER TO SHEET 1.

## LEGEND

1. REFER TO SHEET 1.



|                                                                                       |                                     |
|---------------------------------------------------------------------------------------|-------------------------------------|
| Approved                                                                              | <input checked="" type="checkbox"/> |
| Approved as Noted                                                                     | <input type="checkbox"/>            |
| Not Approved                                                                          | <input type="checkbox"/>            |
| For Information Only                                                                  | <input type="checkbox"/>            |
| Signed                                                                                | Date                                |
|  | 15/09/2025                          |

ACCEPTANCE DOES NOT RELIEVE THE SUPPLIER / CONTRACTOR OF ITS RESPONSIBILITY OR LIABILITIES UNDER THE PURCHASE ORDER / CONTRACT