


D:\CAD PROJECTS\235 NORTHERN STAR RESOURCES LTD\23517 KCGH GROWTH PROJECT\03 DELIVERABLES\EL\F13 - MILLING & CLASSIFICATION\2000-F13-SLD-EL-10305.DWG 27AUG25 7:51AM HOTSEA104

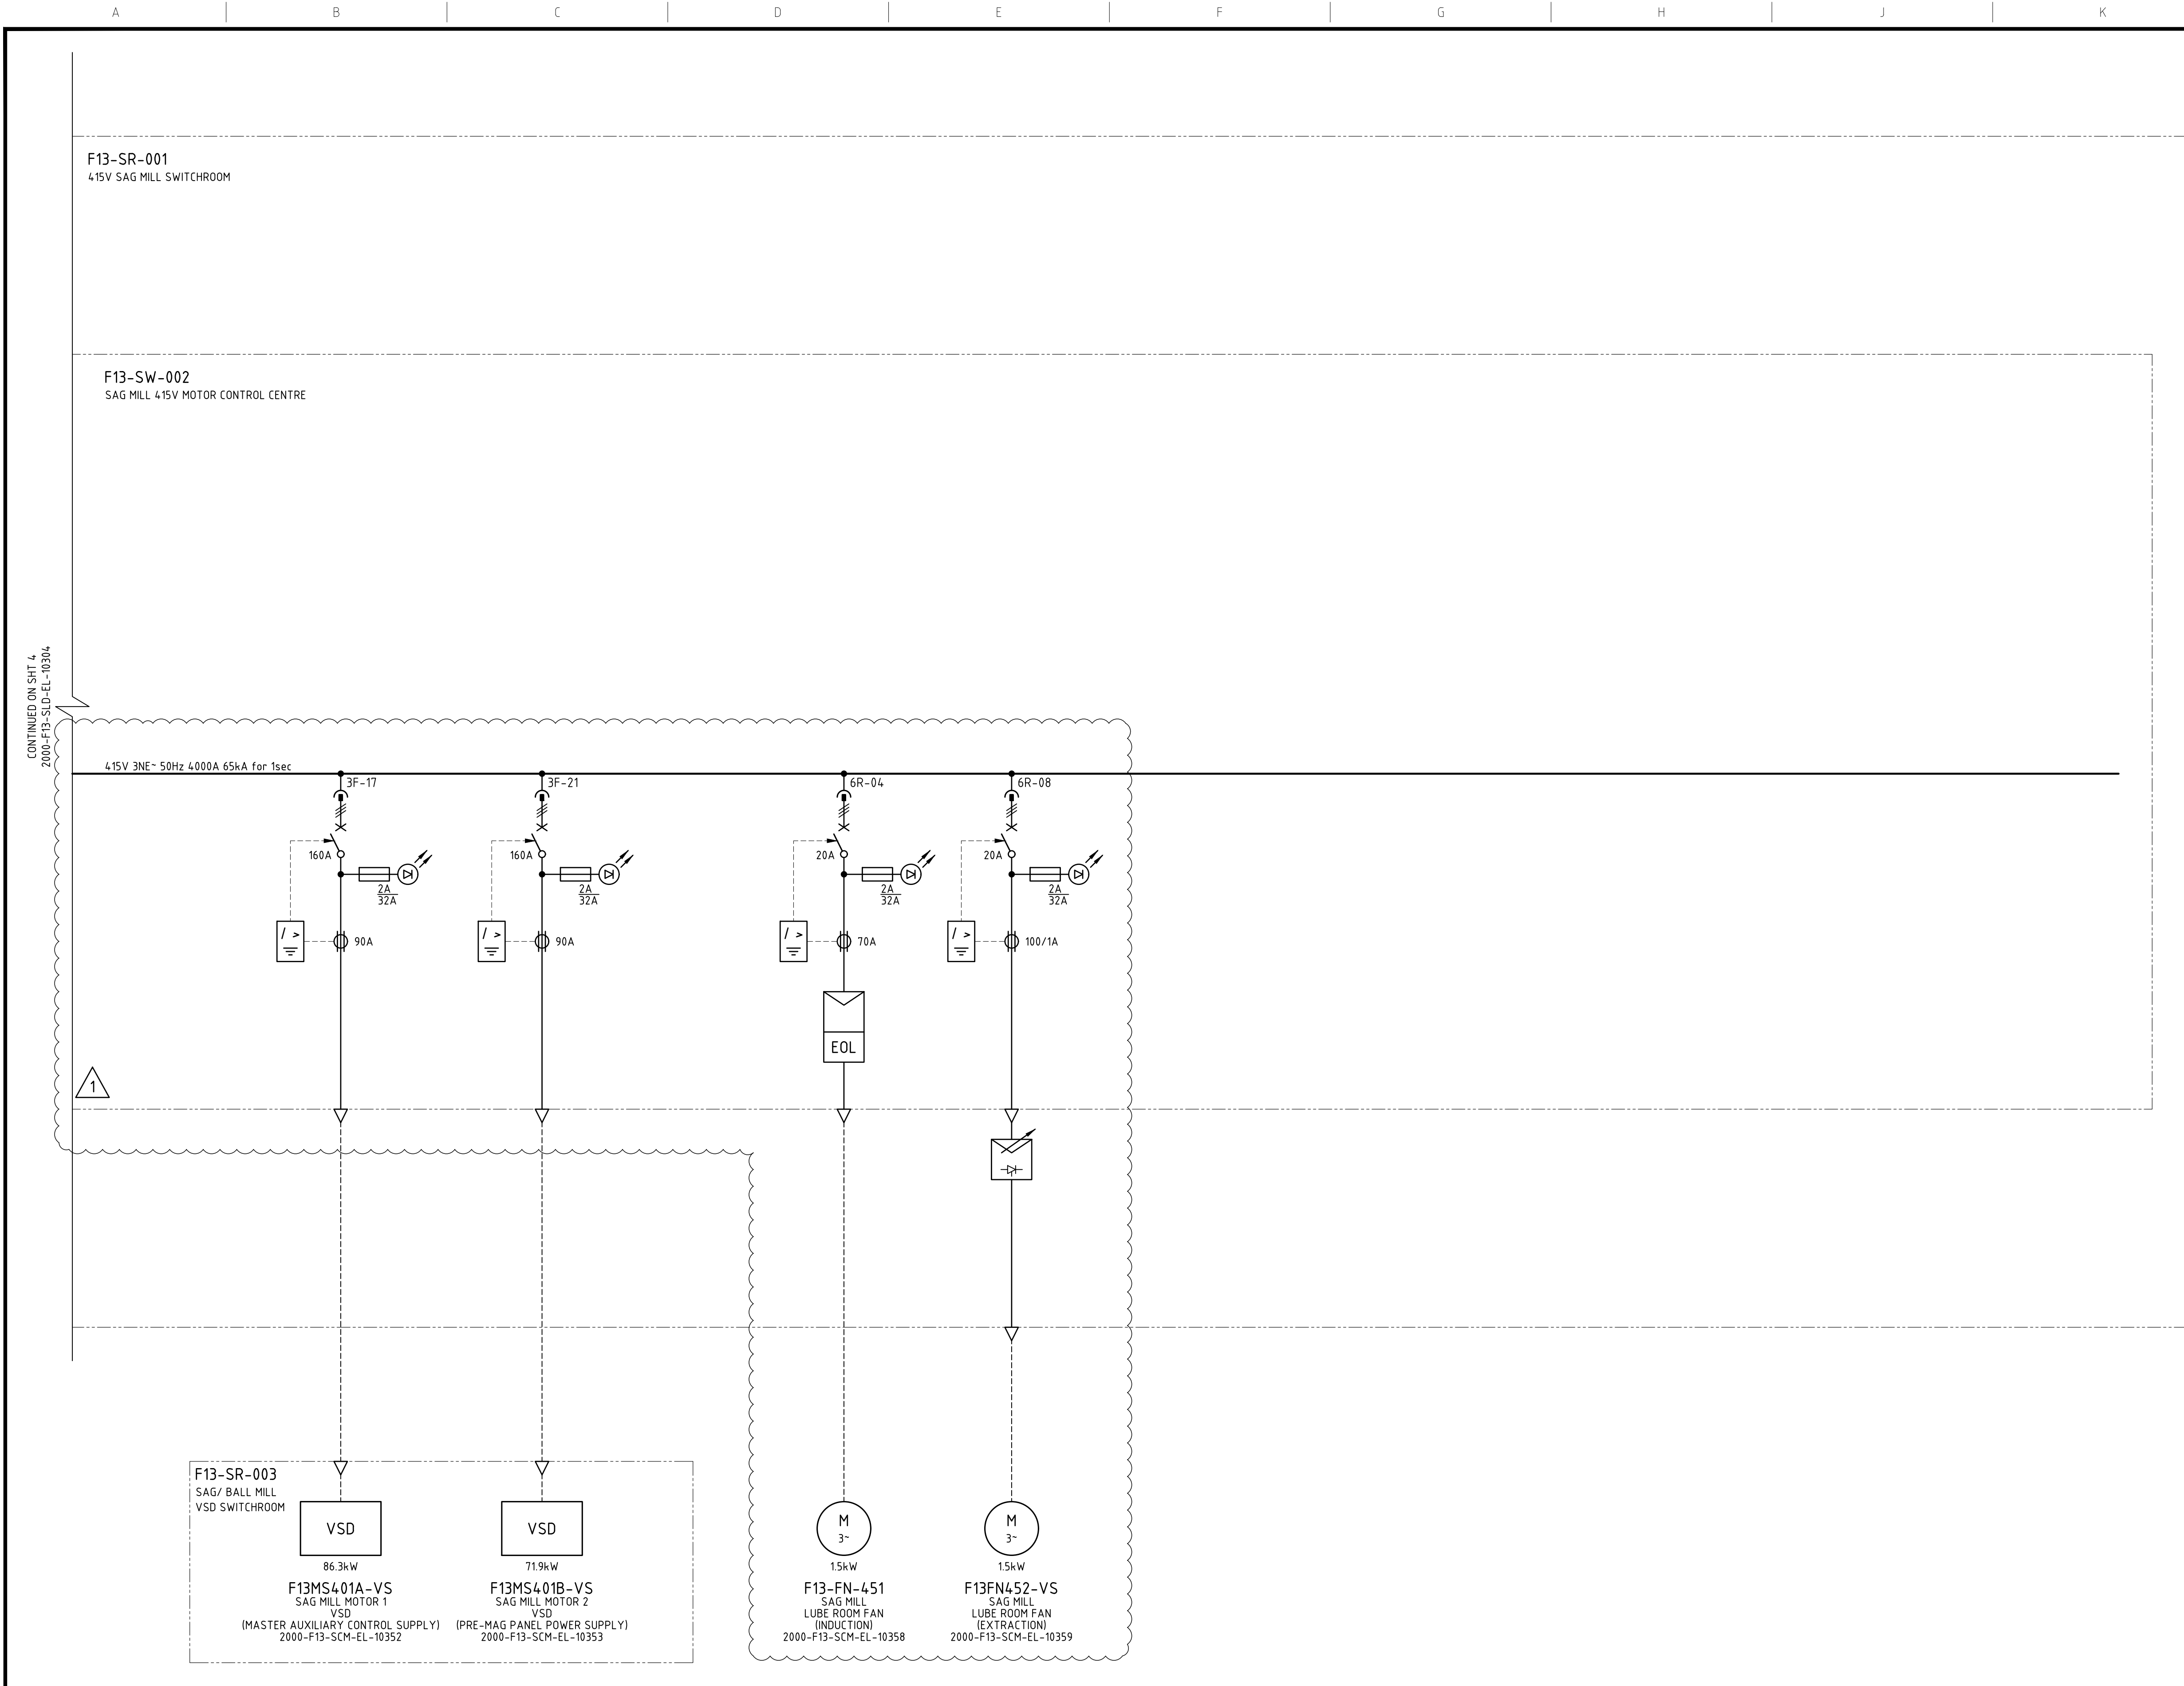

NOTES

1. REFER TO SHEET 1.

LEGEND

1. REFER TO SHEET 1.



Approved ☒

Approved as Noted ☐

Not Approved ☐

For Information Only ☐

Signed  Date 15/09/2025

ACCEPTANCE DOES NOT RELIEVE THE SUPPLIER /
CONTRACTOR OF ITS RESPONSIBILITY OR LIABILITIES
UNDER THE PURCHASE ORDER / CONTRACT

DRG No.	REFERENCES	REV	DATE	DESCRIPTION	DRAW	CHECK	DESIGN	TECH APP	PROJ APP
2000-F13-SCM-EL-10303	F13-SW-002 415V MCC ARC FLASH SYSTEM SCHEMATIC DIAGRAM								
2000-F13-SCM-EL-10302	F13-SW-002 415V MCC 24VDC DISTRIBUTION SCHEMATIC DIAGRAM								
2000-F13-SCM-EL-10301	F13-SW-002 415V MCC INCOMER SCHEMATIC DIAGRAM								
2000-F13-DRG-EL-10101	F13-SR-001 415V SWITCHROOM ELECTRICAL EQUIPMENT LAYOUT								
2000-F13-BLK-IC-10001	F13-SR-001 415V SWITCHROOM AND REMOTE I/O COMMUNICATIONS BLOCK DIAGRAM								
2000-F13-SLD-EL-10301	F13-SW-002 415V MCC SINGLE LINE DIAGRAM SHEET 1								
2000-F00-SLD-EL-10002	F00-SW-010 33kV SWITCHBOARD SINGLE LINE DIAGRAM SHEET 1 OF 5	1	18AUG25	FAT REDLINES INCORPORATED					
2000-F00-STD-EL-10001	GENERAL NOTES AND STANDARD DRAWINGS INDEX	0	30MAY24	APPROVED FOR CONSTRUCTION					



INFORMATION AND REPRESENTATIONS ON THIS DRAWING ARE THE INTELLECTUAL PROPERTY OF
PRIMERO UNLESS SPECIFICALLY IDENTIFIED OTHERWISE. ALL RIGHTS INCLUDING USE RESERVED

PROJECT: NORTHERN STAR RESOURCES LTD KCGM GROWTH PROJECT			
TITLE: MILLING & CLASSIFICATION - SAG MILL F13-SW-002 415V MCC SINGLE LINE DIAGRAM SHEET 5			
SHEET A1	SCALE NONE	DRG No. 2000-F13-SLD-EL-10305	REVISION 1