




NOTES

- | | |
|----|-------------------|
| 1. | REFER TO SHEET 1. |
|----|-------------------|

LEGEND

1. REFER TO SHEET 1.

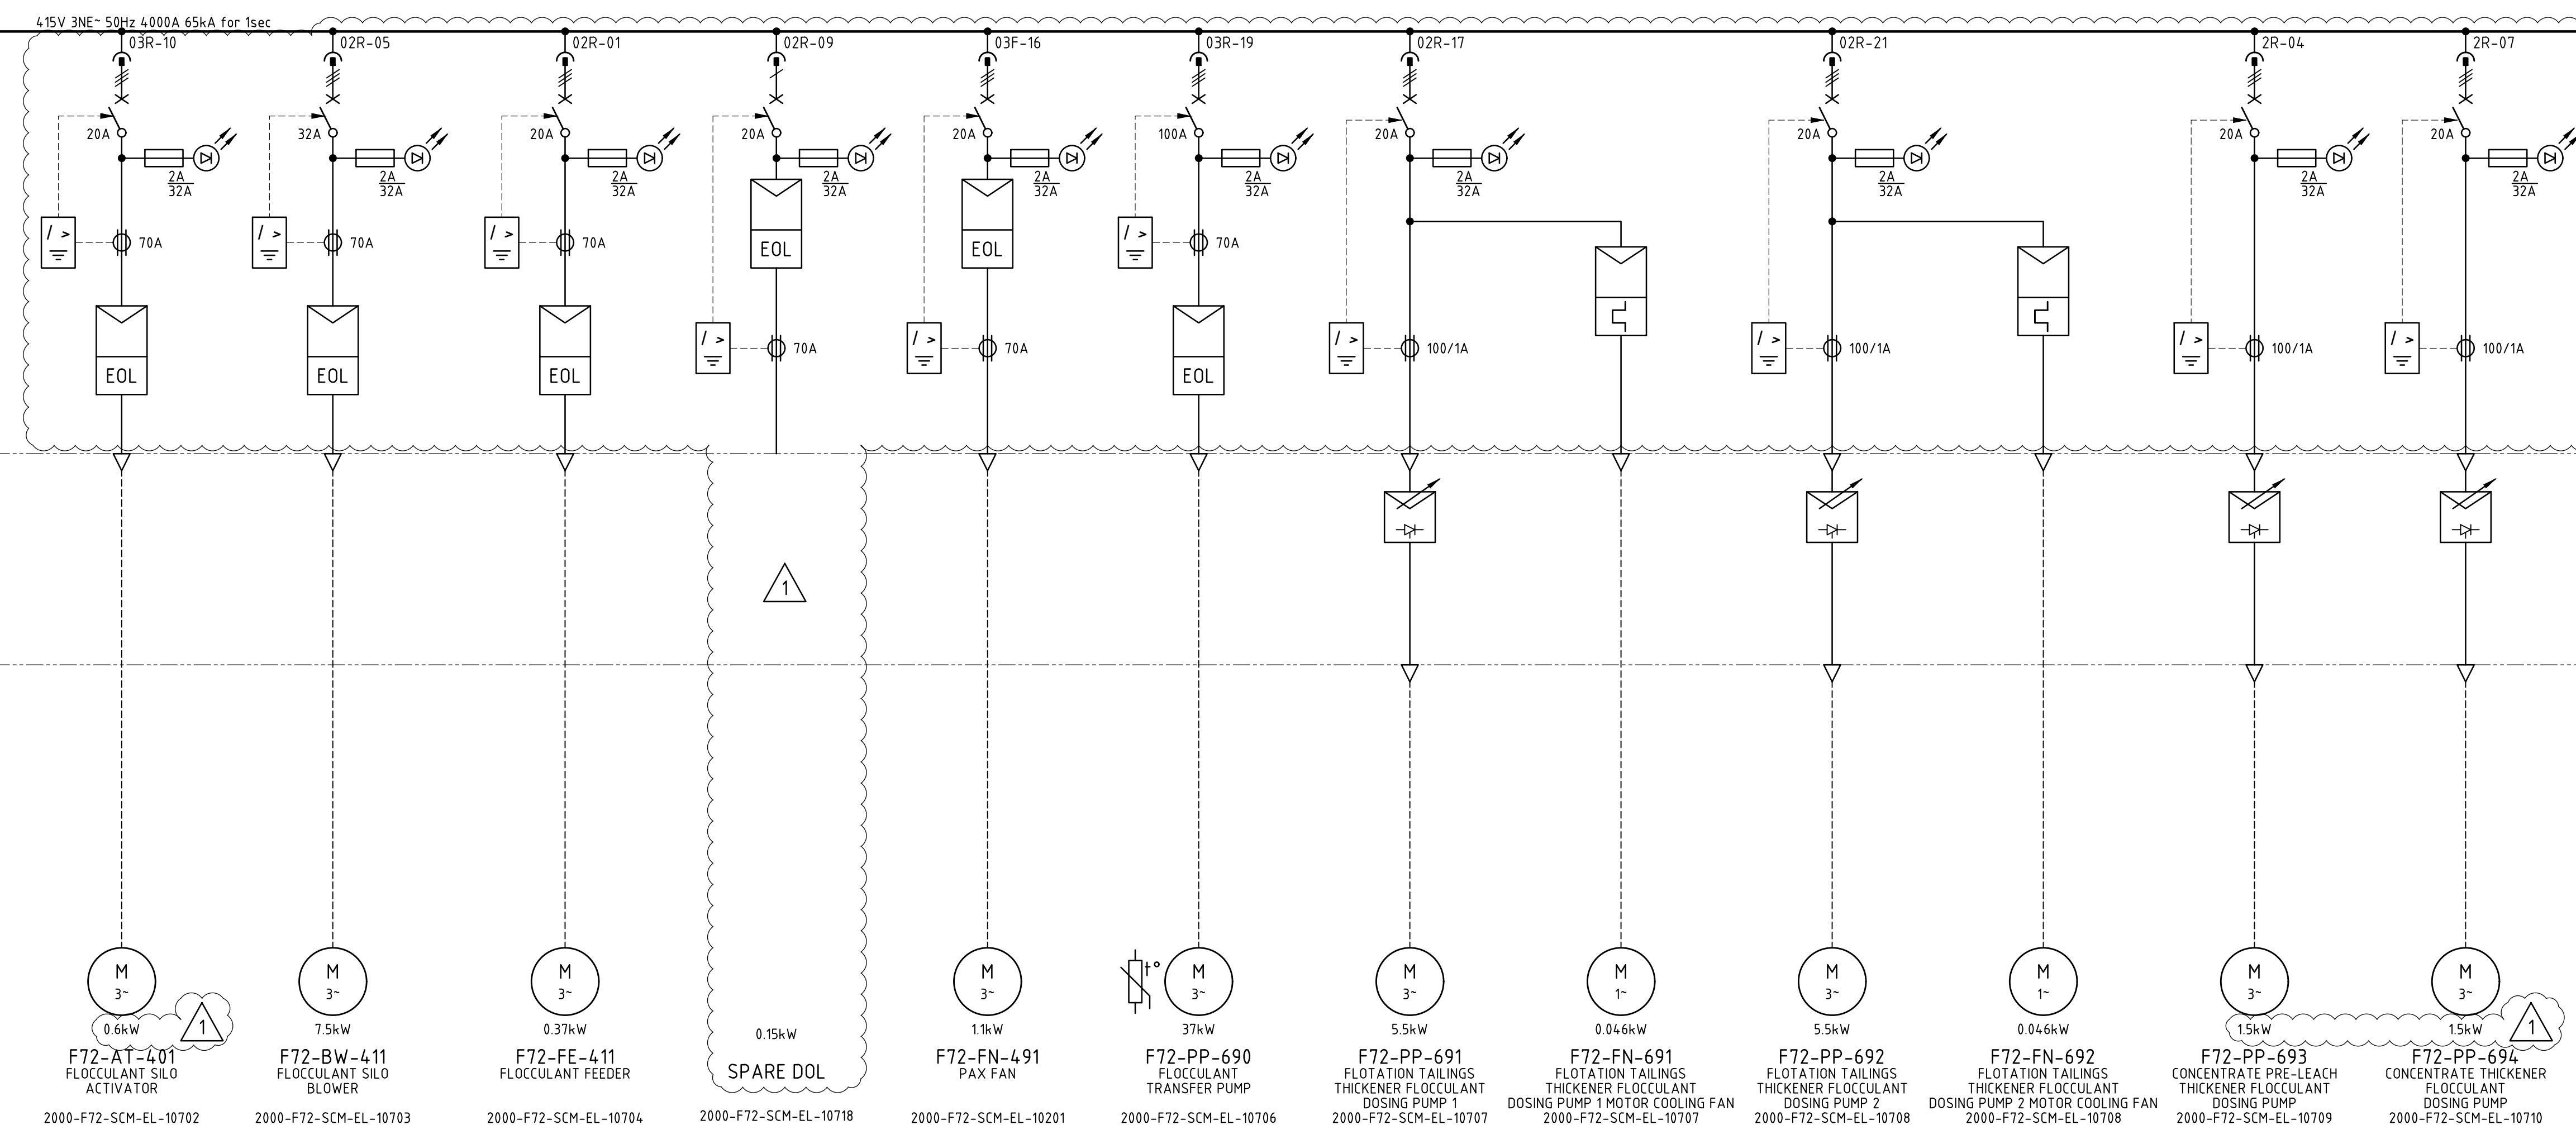

Approved	☒
----------	-------------------------------------

Approved as Noted

Not Approved

For Information Only	
----------------------	--

Signed  Date 24.06.2025

ACCEPTANCE DOES NOT RELIEVE THE SUPPLIER /
CONTRACTOR OF ITS RESPONSIBILITY OR LIABILITIES
UNDER THE PURCHASE ORDER / CONTRACT

[illegible]

PRIMERCO

primero.com.au | DESIGN | CONSTRUCT | OPERATE

PRIMERO PROJECT NUMBER

23517

INFORMATION AND REPRESENTATIONS ON THIS DRAWING ARE THE INTELLECTUAL PROPERTY OF
PRIMERO UNLESS SPECIFICALLY IDENTIFIED OTHERWISE. ALL RIGHTS INCLUDING USE RESERVED

PROJECT: NORTHERN STAR RESOURCES LTD
KCGM GROWTH PROJECT

E	TITLE:	MILLING & CLASSIFICATION
		F13-SW-020 415V MCC
		SINGLE LINE DIAGRAM SHEET 2

SHEET
A1

SCALE
NONE

	DRG No.
--	---------

2000-F13-SLD-EL-10702

REVISION

1