




NOTES

1. REFER TO SHEET 1.

LEGEND

1.	REFER TO SHEET 1.
----	-------------------

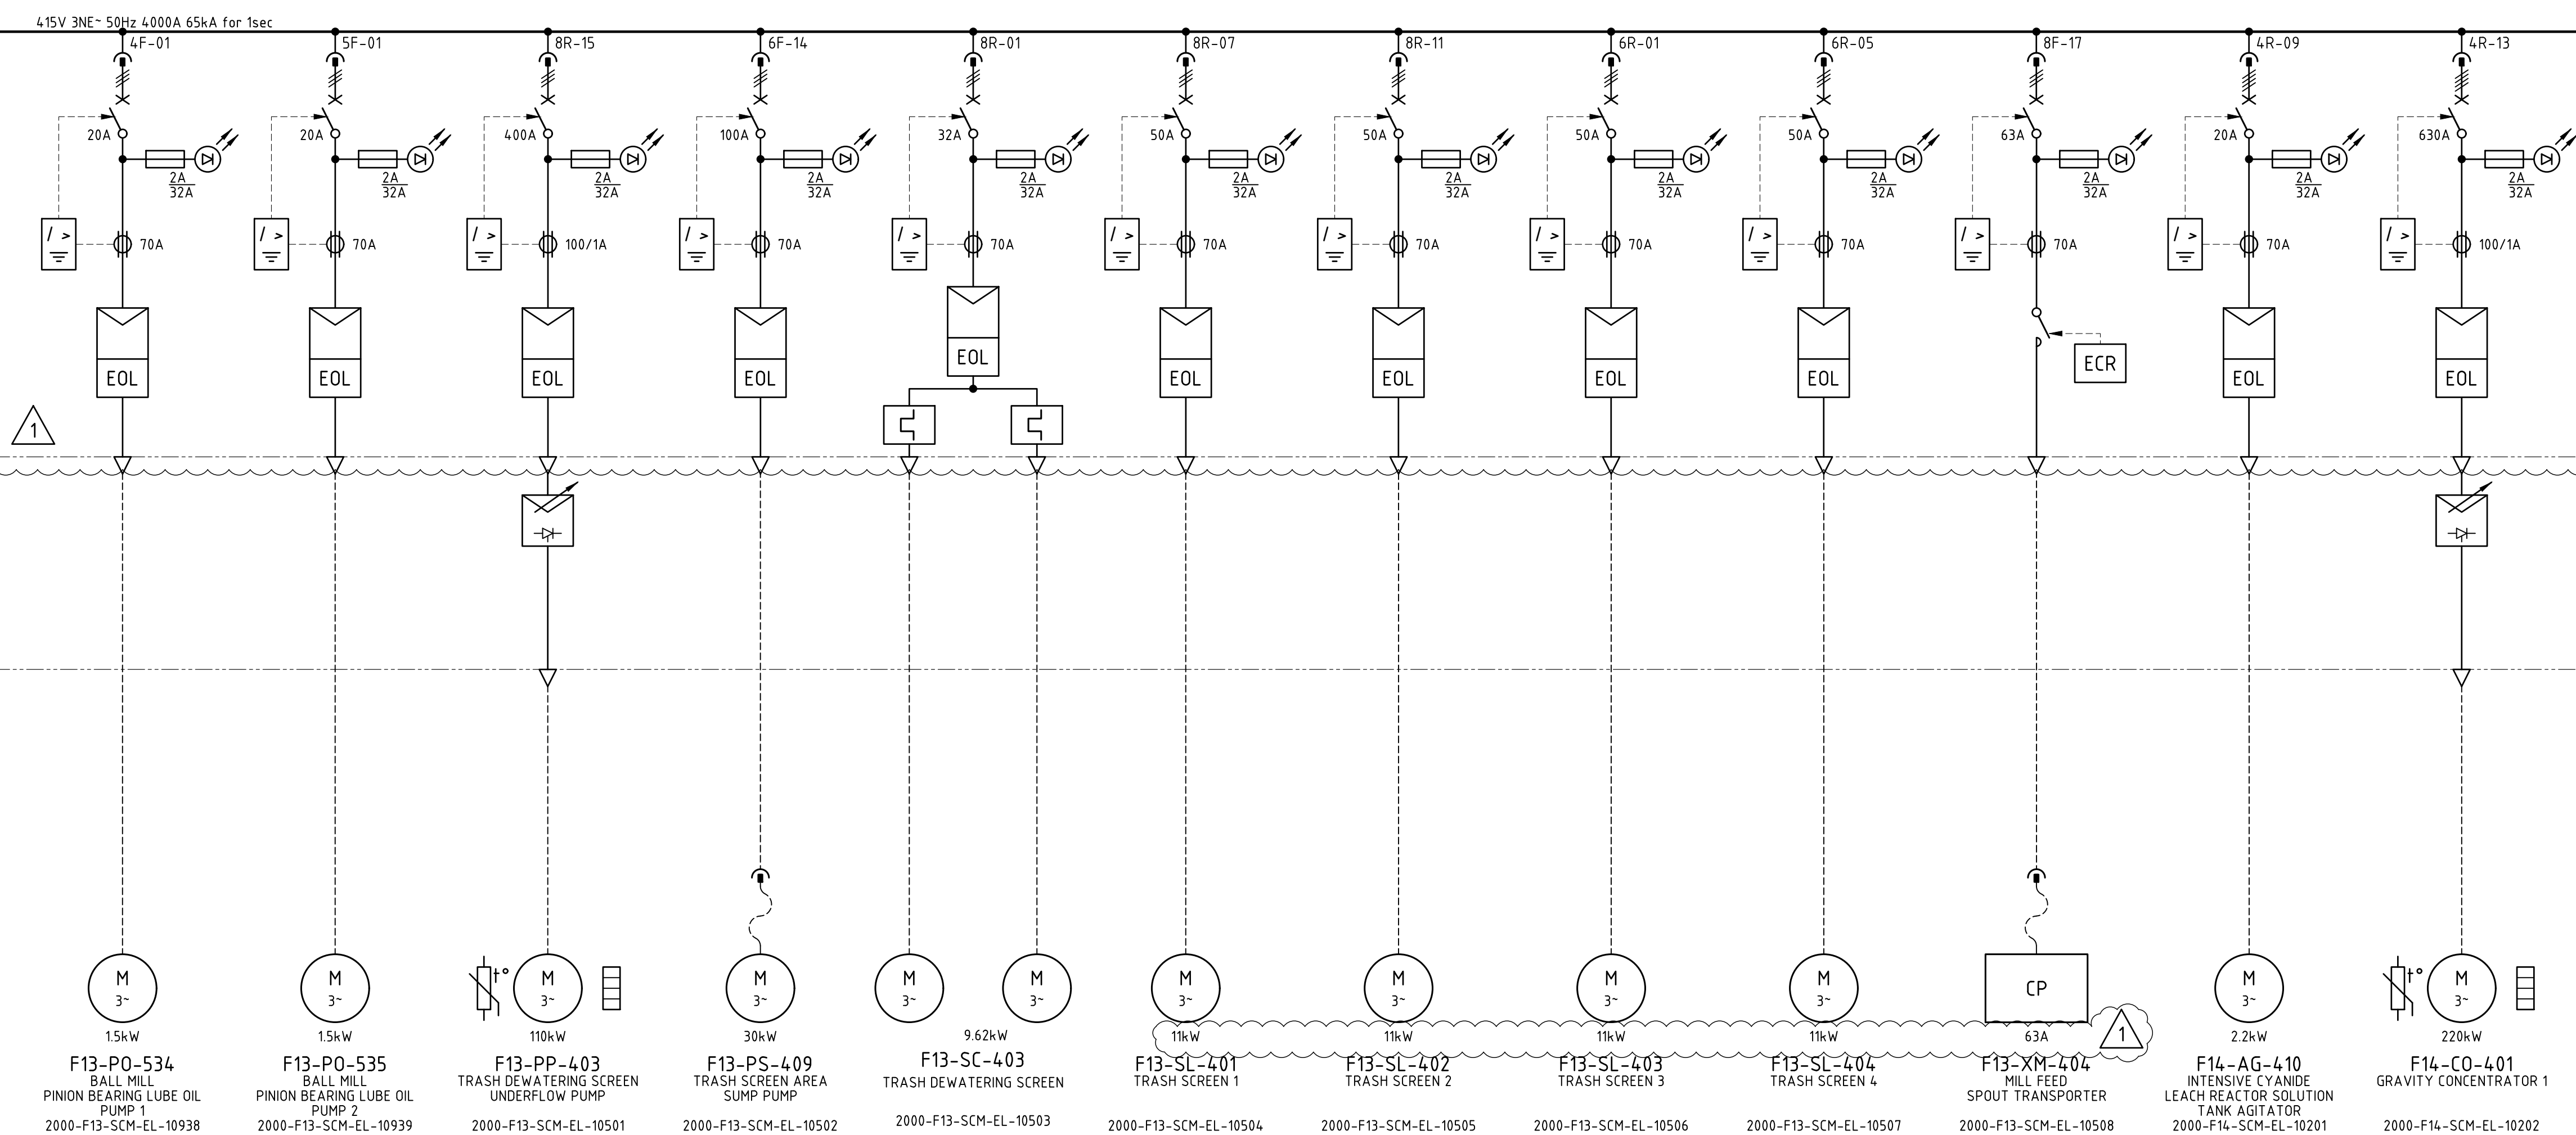

NORTHERN SYDNEY

Approved

Approved as Noted

Not Approved

For Information Only

Signed	Date
	09/10/2025

ACCEPTANCE DOES NOT RELIEVE THE SUPPLIER /
CONTRACTOR OF ITS RESPONSIBILITY OR LIABILITIES
UNDER THE PURCHASE ORDER / CONTRACT

[illegible]

PRIMERO
primero.com.au | DESIGN | CONSTRUCT | OPERATE

PRIMERO PROJECT NUMBER

23517

INFORMATION AND REPRESENTATIONS ON THIS DRAWING ARE THE INTELLECTUAL PROPERTY OF PRIMERO UNLESS SPECIFICALLY IDENTIFIED OTHERWISE. ALL RIGHTS INCLUDING USE RESERVED.

PROJECT: NORTHERN STAR RESOURCES LTD
KCGM GROWTH PROJECT

E	TITLE:	MILLING & CLASSIFICATION - BALL MILL
		F13-SW-003 415V MCC SINGLE LINE DIAGRAM SHEET 4

SHEET
A1

SCALE
NONE

DRG No.	
---------	--

2000-F13-SLD-EL-10904

REVISION