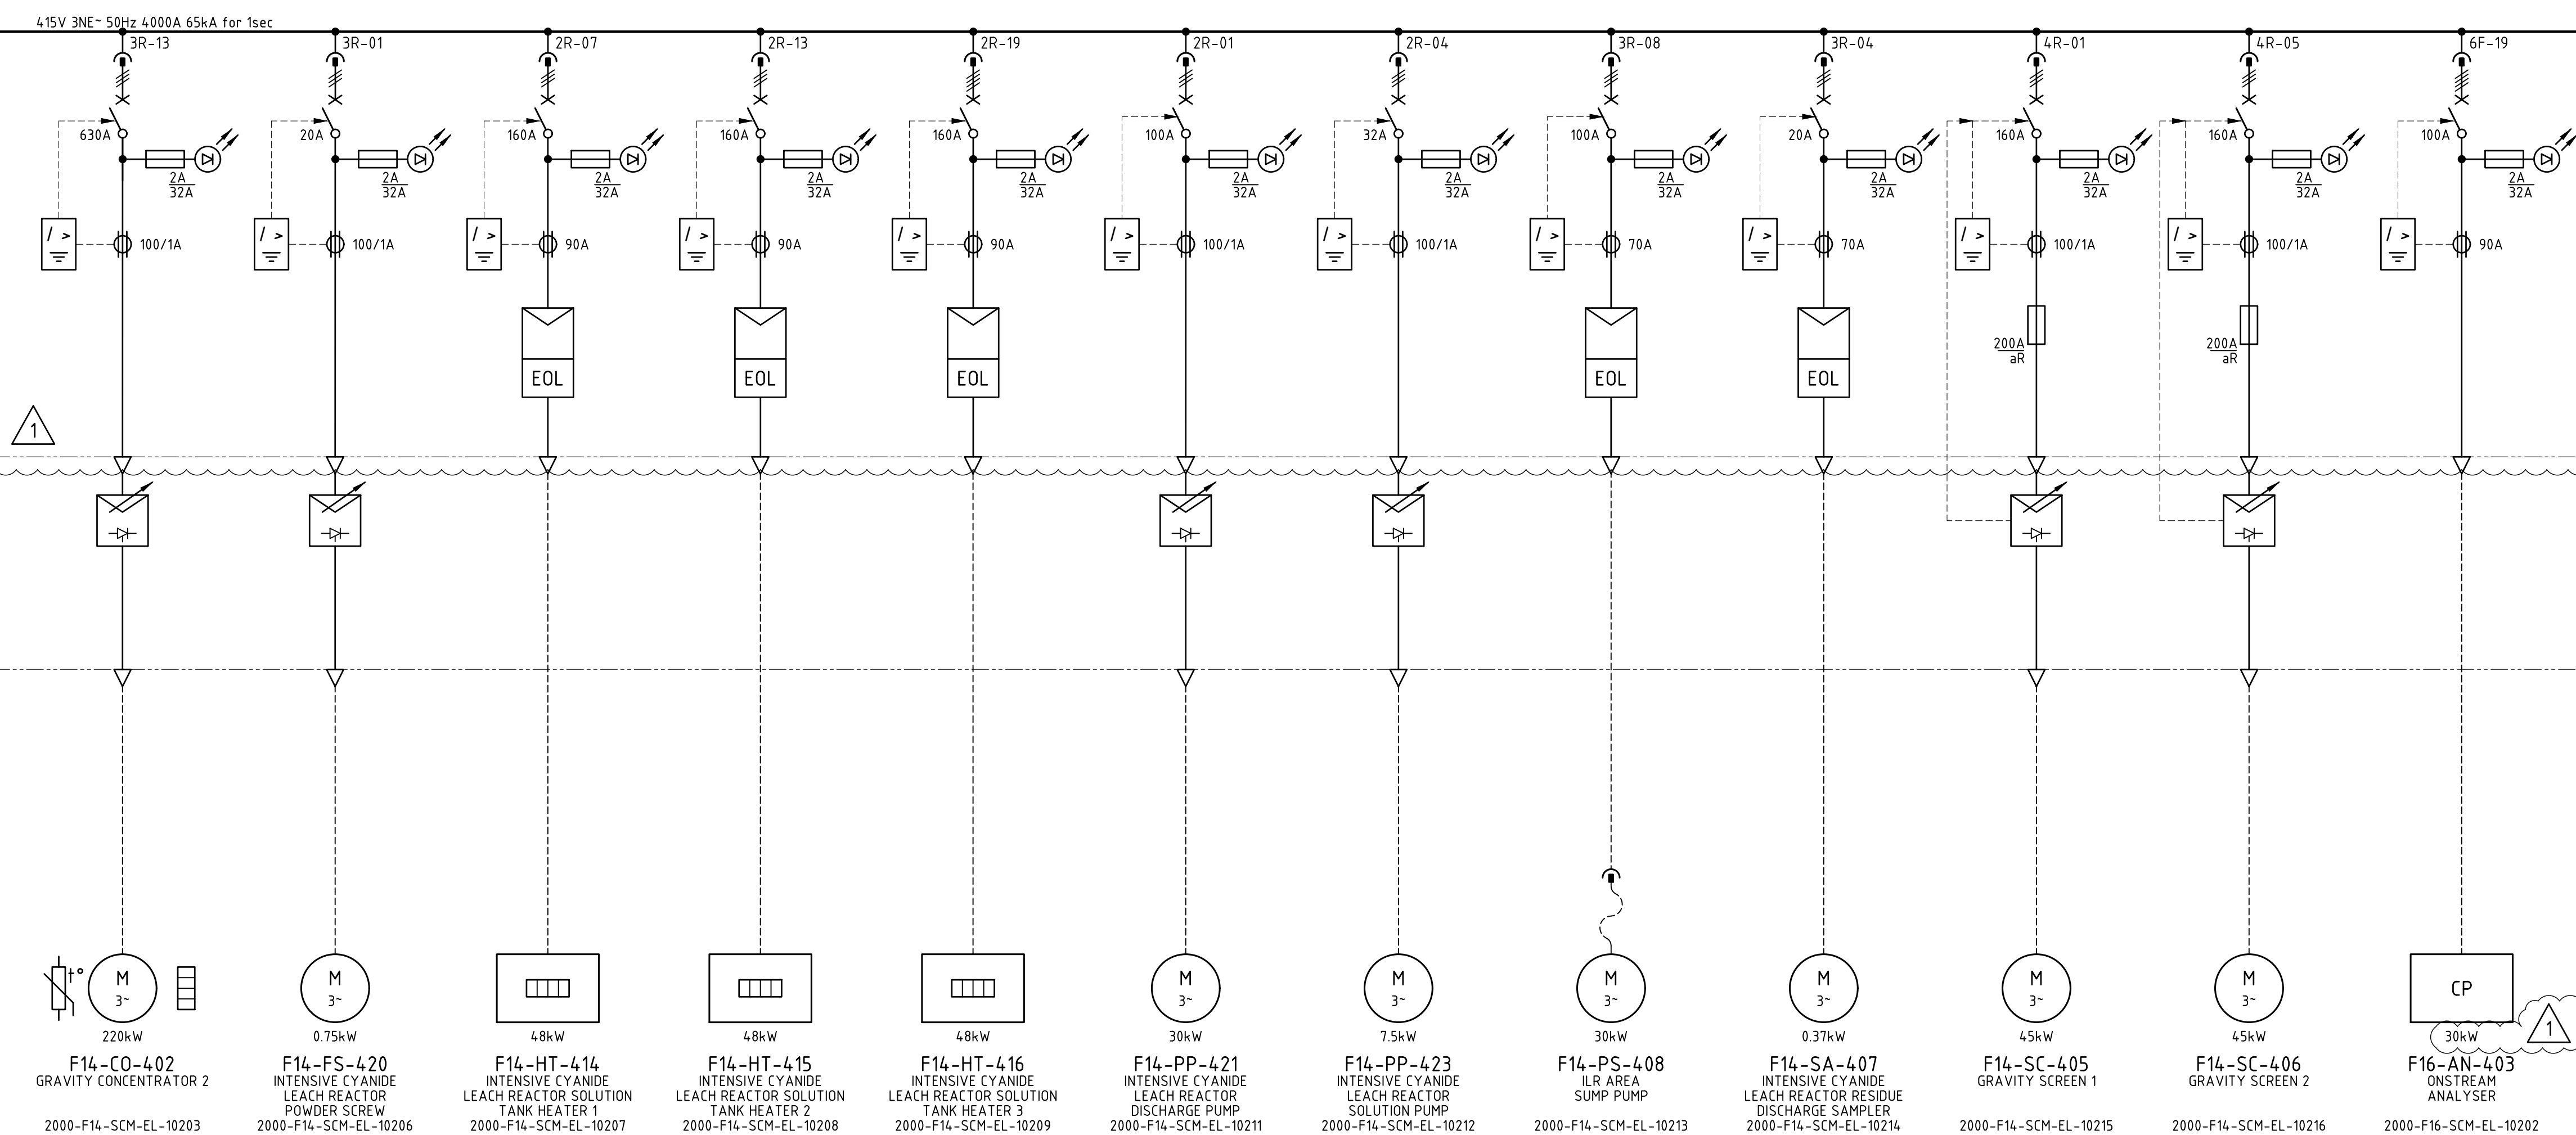
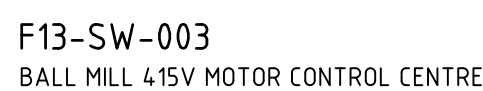


[illegible]

PRIMERO
primero.com.au | DESIGN | CONSTRUCT | OPERATE
PRIMERO PROJECT NUMBER: 23517

INFORMATION AND REPRESENTATIONS ON THIS DRAWING ARE THE INTELLECTUAL PROPERTY OF PRIMERO UNLESS SPECIFICALLY IDENTIFIED OTHERWISE. ALL RIGHTS INCLUDING USE RESERVED

PROJECT: NORTHERN STAR RESOURCES LTD KCGM GROWTH PROJECT		TITLE: MILLING & CLASSIFICATION - BALL MILL F13-SW-003 415V MCC SINGLE LINE DIAGRAM SHEET 5	
SHEET A1	SCALE NONE	DRG No. 2000-F13-SLD-EL-10905	REVISION 1

1. REFER TO SHEET 1

1. REFER TO SHEET 1

	
Approved	☒
Approved as Noted	☐
Not Approved	☐
For Information Only	☐
Signed 	Date 09/10/2025
ACCEPTANCE DOES NOT RELIEVE THE SUPPLIER / CONTRACTOR OF ITS RESPONSIBILITY OR LIABILITIES UNDER THE PURCHASE ORDER / CONTRACT	