


D:\CAD PROJECTS\235 NORTHERN STAR RESOURCES LTD\23517 KCGM GROWTH PROJECT\03 DELIVERABLES\EL\F16 - ROUGHER & SCAVENGER FLOTATION\2000-F16-SLD-EL-10001.DWG 09SEP25 6:50AM HOTSEA104

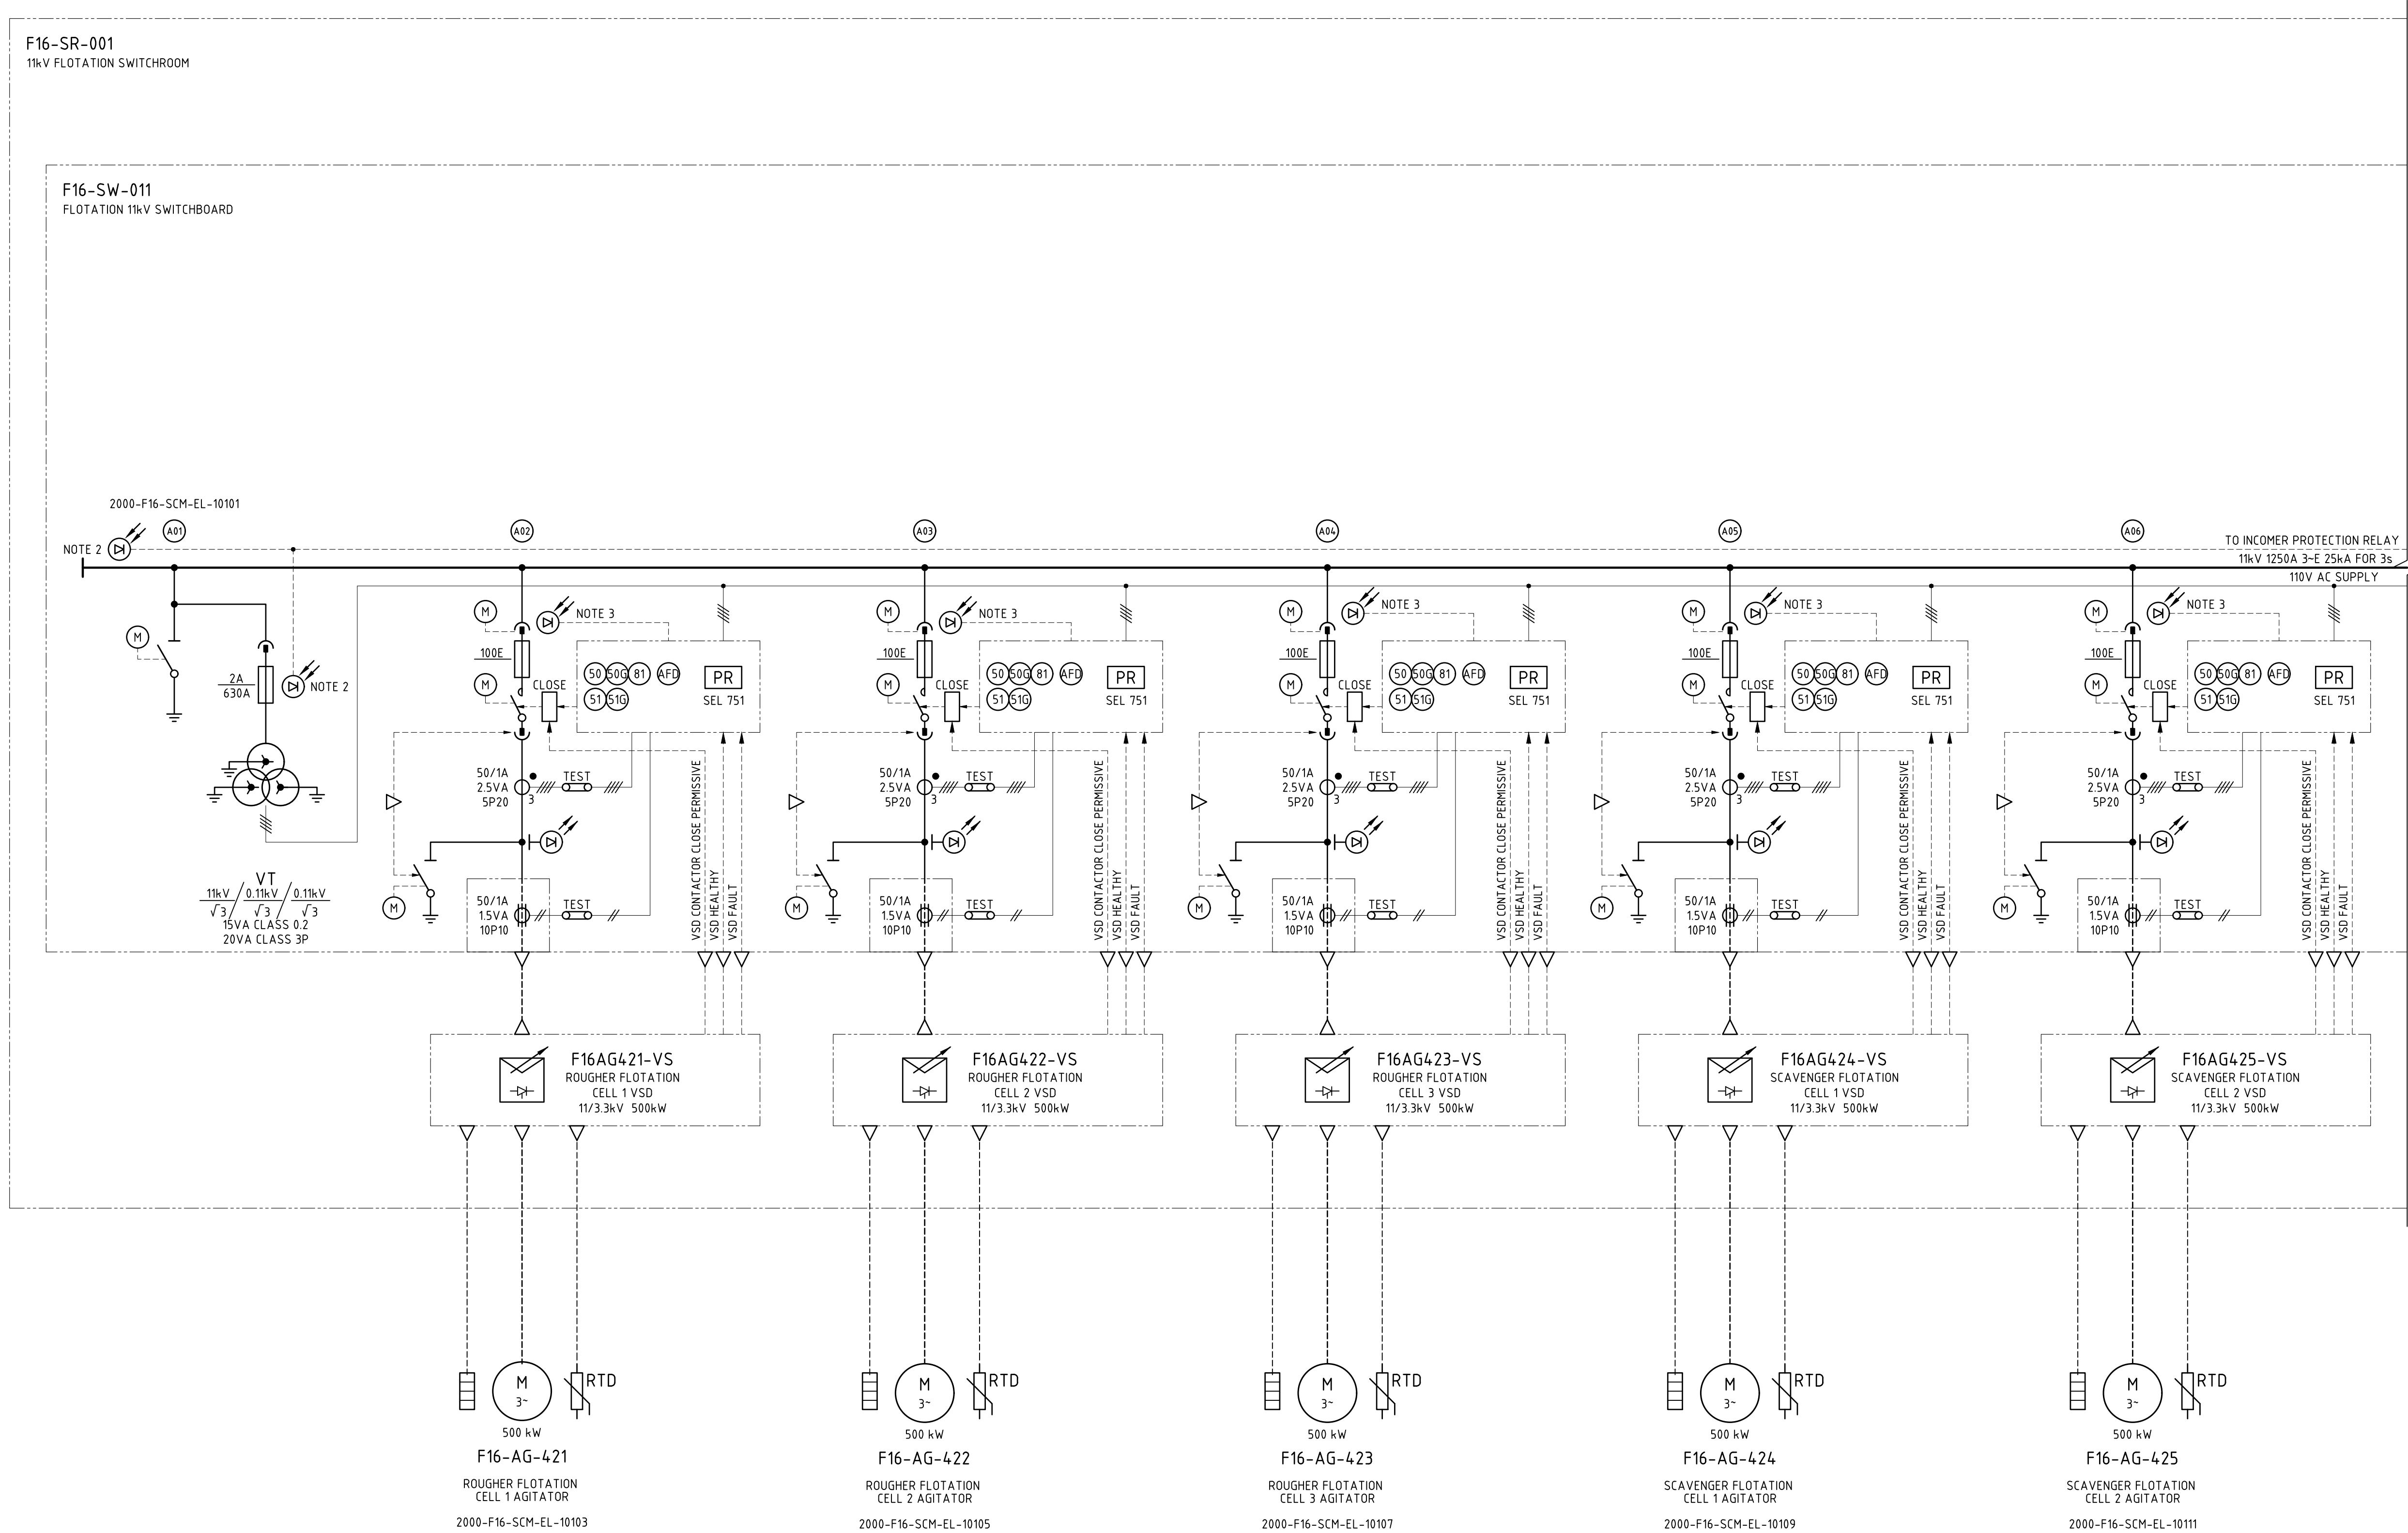

NOTES

- THE SWITCHBOARD SHALL BE EXTENSIBLE ONE END FOR FUTURE EXPANSION AND SUPPLIED WITH ONE SPARE TIER AS SHOWN.
- ARC FLASH IN INCOMER CIRCUIT BREAKER COMPARTMENT IS NOT CURRENT SUPERVISED. TRIPPING OF BUS AND DOWNSTREAM CB/FC COMPARTMENTS IS CURRENT SUPERVISED.
- ARC FLASH POINT DETECTORS SHALL BE PLACED IN THE CABLE ZONE, CIRCUIT BREAKER CHAMBER OR FUSE CONTACTOR CHAMBER AND THE BUSBAR CHAMBER. THE DETECTORS SHALL BE CONNECTED DIRECTLY TO THE PROTECTION RELAY IN EACH PANEL.

Approved ☒

Approved as Noted ☐

Not Approved ☐

For Information Only ☐

Signed Date 23/09/2025

ACCEPTANCE DOES NOT RELIEVE THE SUPPLIER / CONTRACTOR OF ITS RESPONSIBILITY OR LIABILITIES UNDER THE PURCHASE ORDER / CONTRACT

LEGEND

- PR INCOMER / FEEDER PROTECTION RELAY
- PQM POWER QUALITY METER
- AFD ARC FLASH SENSOR (POINT TYPE) NOTES 2 & 3
- CVI CAPACITIVE VOLTAGE INDICATION
- MID MECHANICAL INTERLOCK DEVICE
- E-SHUT SWITCHROOM EMERGENCY SHUTDOWN
- M MOTOR OPERATOR
- UV UNDER VOLTAGE
- IOC INSTANTANEOUS OVER-CURRENT
- IENOC INSTANTANEOUS EARTH/NEUTRAL OVERCURRENT
- TOC TIMED OVER-CURRENT
- TENOC TIMED EARTH/NEUTRAL OVERCURRENT
- OV OVER VOLTAGE
- EF EARTH FAULT
- TT TRANSFORMER TEMPERATURE
- TP/B TRANSFORMER PRESSURE / BUCCHOLZ
- TL/GL TRANSFORMER LIQUID / GAS LEVEL
- F FREQUENCY
- AFD ARC FLASH DETECTION

DRG No.	REFERENCES	REV	DATE	DESCRIPTION	DRAW	CHECK	DESIGN	TECH APP	PROJ APP
2000-F16-DRG-EL-10001	F16-SR-001 11kV FLOTATION SWITCHROOM ELECTRICAL EQUIPMENT LAYOUT								
2000-F16-SLD-EL-10051	F16-SW-011 11kV FLOTATION SWITCHBOARD KEY INTERLOCKING SINGLE LINE DIAGRAM								
2000-F16-SLD-EL-10002	F16-SW-011 11kV FLOTATION SWITCHBOARD SINGLE LINE DIAGRAM SHEET 2 OF 3								
2000-F00-SLD-EL-10001	OVERALL SITEWIDE SINGLE LINE DIAGRAM	1	29AUG25	FAT REDLINES INCORPORATED - NO CHANGE					
2000-F00-STD-EL-10001	GENERAL NOTES AND STANDARD DRAWINGS INDEX	0	22OCT24	APPROVED FOR CONSTRUCTION					

PRIMERO
primero.com.au | DESIGN | CONSTRUCT | OPERATE
PRIMERO PROJECT NUMBER: 23517

PROJECT: NORTHERN STAR RESOURCES LTD
KCGM GROWTH PROJECT

TITLE: ROUGHER & SCAVENGER FLOTATION
F16-SW-011 11kV SWITCHBOARD
SINGLE LINE DIAGRAM SHEET 1

SHEET A1

SCALE NONE

DRG No. 2000-F16-SLD-EL-10001

REVISION 1

INFORMATION AND REPRESENTATIONS ON THIS DRAWING ARE THE INTELLECTUAL PROPERTY OF PRIMERO UNLESS SPECIFICALLY IDENTIFIED OTHERWISE. ALL RIGHTS INCLUDING USE RESERVED