
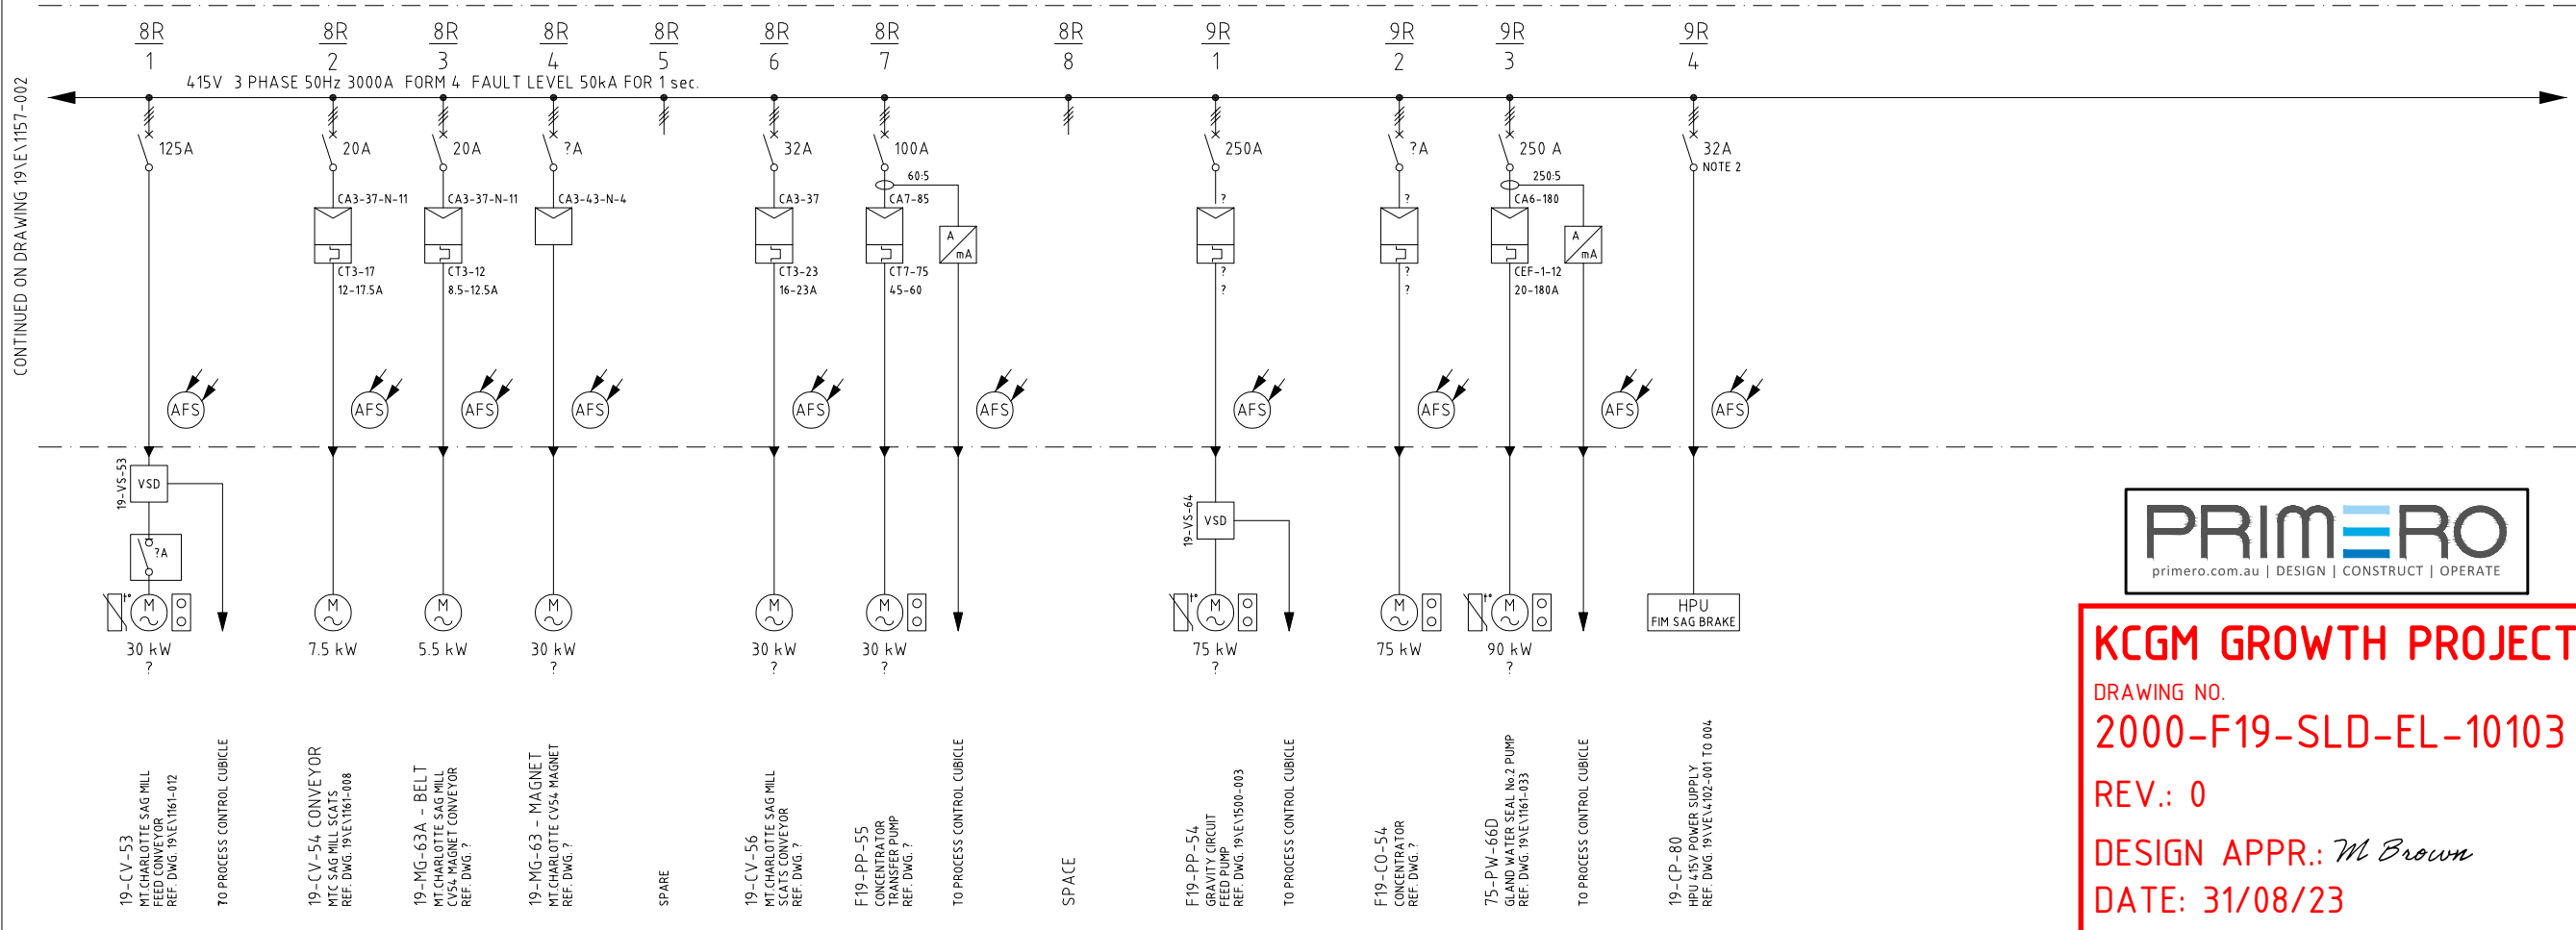


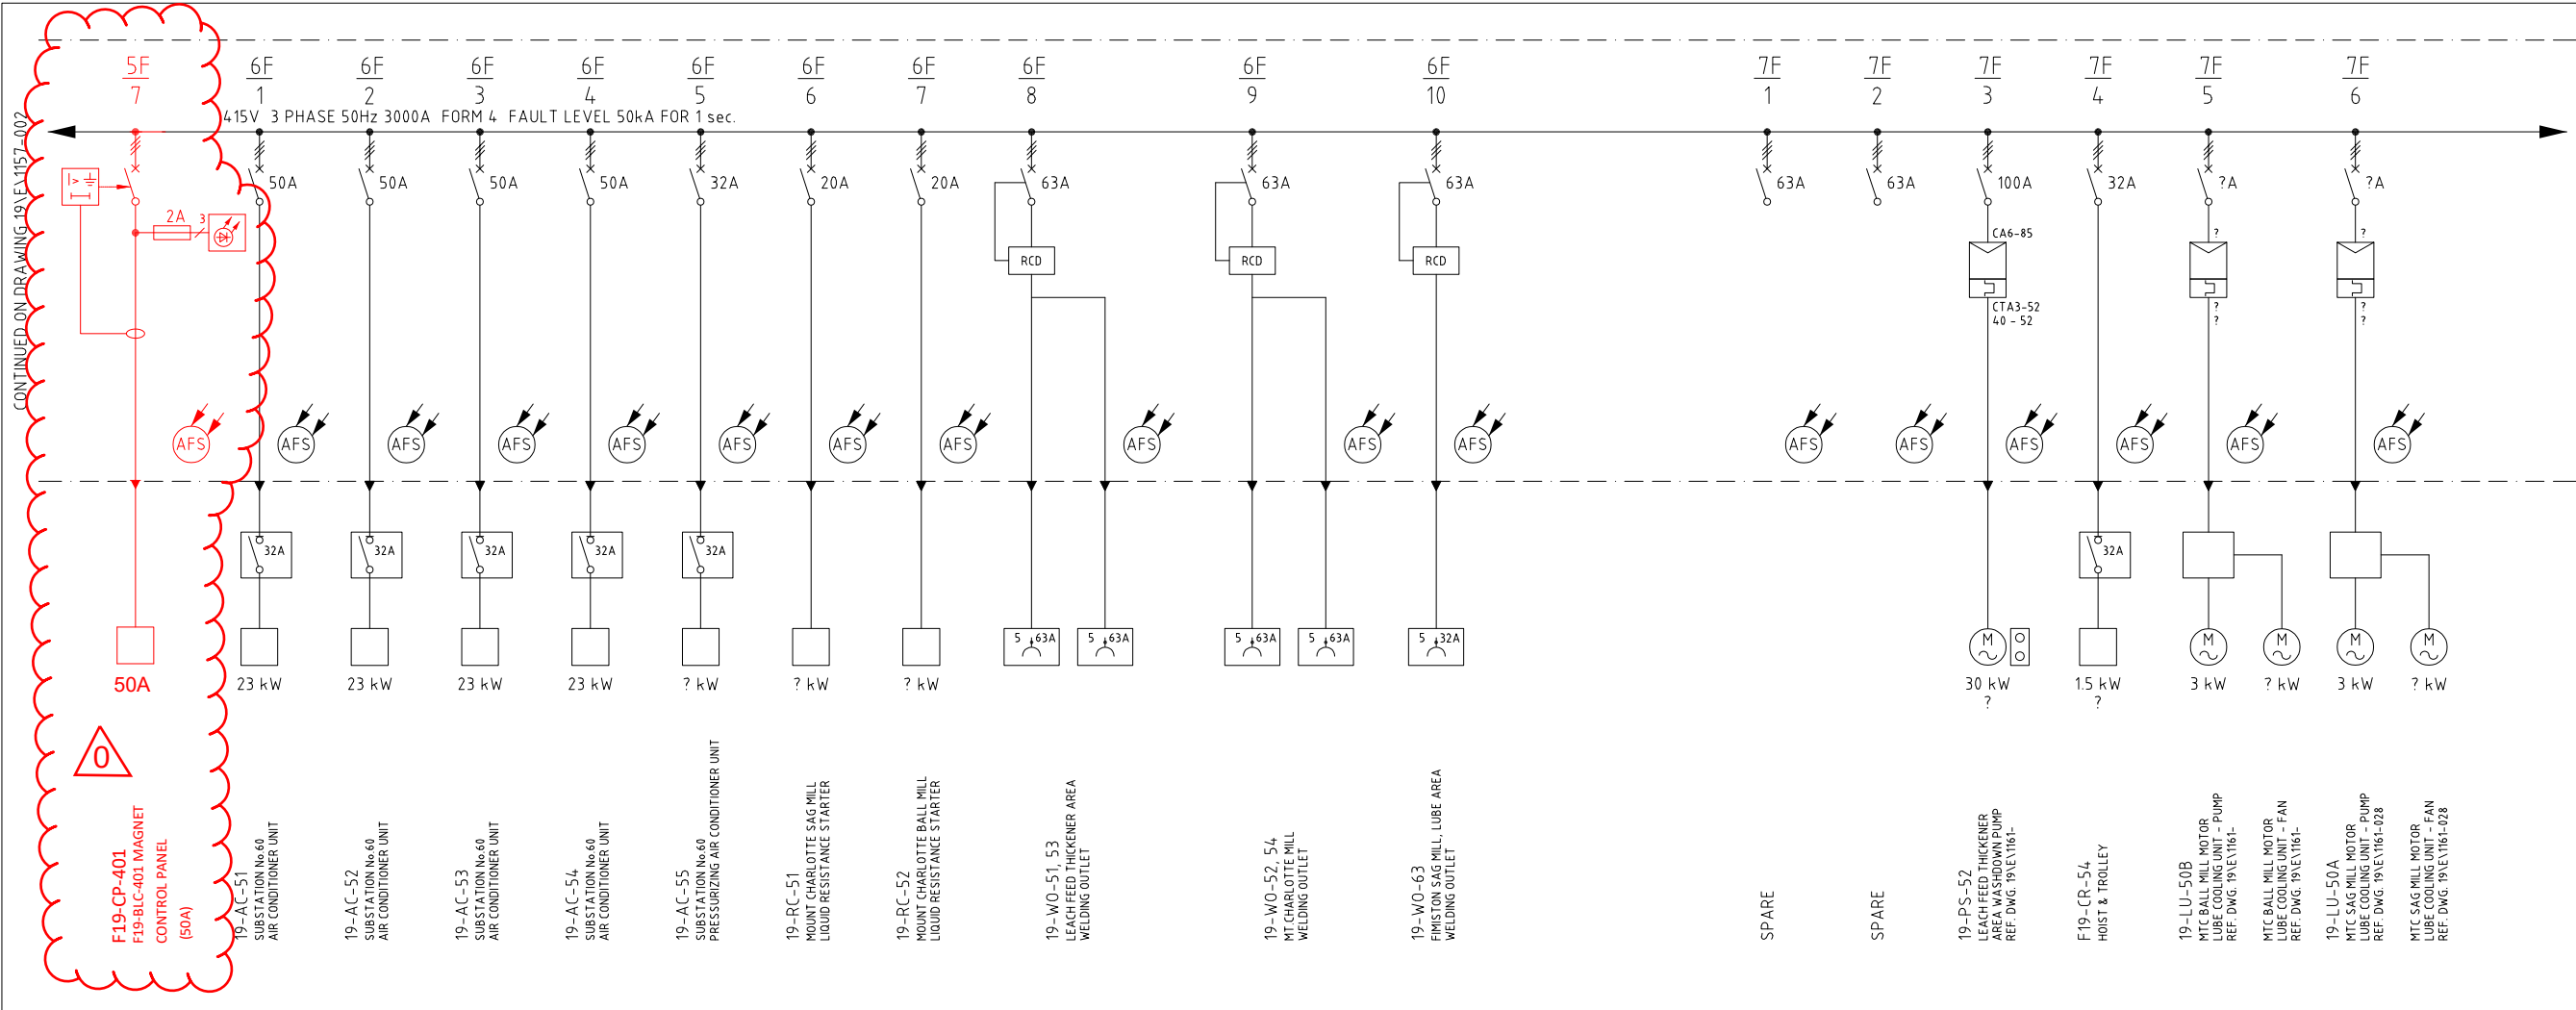

KCGM GROWTH PROJECT

DRAWING NO. **2000-F19-SLD-EL-10103**

REV.: 0


DESIGN APPR.: *M. Brown*

DATE: 31/08/23

LEGEND

LOCATION

SUB STATION 60
19-SW-61

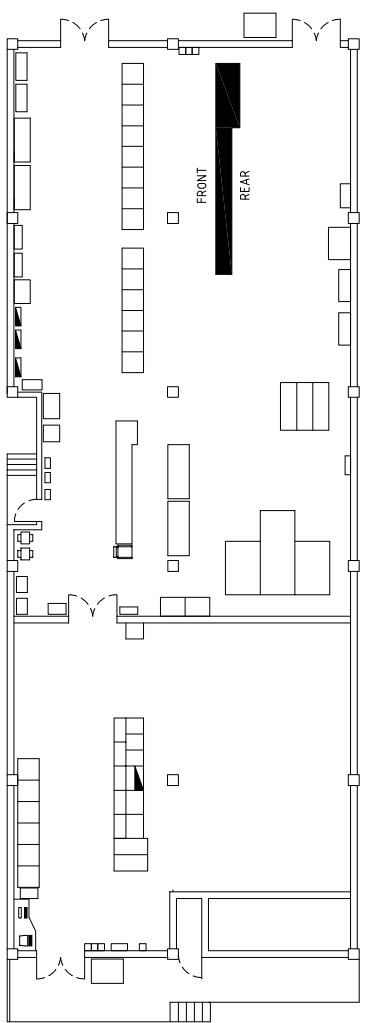

NOTES

- EARTH LEAKAGE CIRCUIT BREAKER SHALL HAVE 300mA SENSITIVITY FOR WELDING OUTLET.
- EARTH CONTINUITY RELAY, SCIENTECHNIC TYPE PCA. WIRED BACK TO THE ARC FLASH RELAY
- ALL AFS (ARC FLASH SENSORS) ARE CONNECTED TO THE ARC FLASH RELAY VIA I/O UNITS

12	12/08/16	19HU51 TIER 7F/6 REMOVED	RH	ETS	PH	16A	11/03/19	2019 S.L.D. UPDATE PROJECT 'AS BUILT' - FIELD REVIEW	RH	RH	EB			SCALE				
11	12/12/13	WELDING OUTLET INSTALLED	RH	PH	15	08/11/17	ARC FLASH SENSORS INSTALLED		RH	JMR	JMR	SUBSTATION No.60 DCS CUBICLE 19-PC-51 MARSHALLING TERMINATIONS	19\EL1167	DRAWN	G.SOFIELD	10/10/97	FIMSTON PLANT	
10	29/03/12	MTC SAG & BALL HUMIDIFIER AS BUILT MARCH 2012	RH	CJ	CJ	14	11/11/16	BRAKE INSTALLED AS BUILT	RH	CJ		SUBSTATION No.60 MCC 19-SW-61 CABLE ZONE TERMINATIONS	19\EL1163	DESIGNED	G.SOFIELD	10/10/97	MT. CHARLOTTE CCT, MILLING AND CLASSIFICATION	SIZE
9	23/02/11	19-HU-51 MTC SAG & BALL SLIP RINGS HUMIDIFIER ADDED	RH	JC	JC	13C	02/02/16	MOVED 19CP80 FROM TIER 8R-5 TO 9R-4, ISSUED FOR ENGINEERING REVIEW	RH	CJ	AD	SUBSTATION No.60 POWER SCHEMATICS	19\EL1160	CHECKED	G.SOFIELD	10/10/97	SUBSTATION No.60 415V MCC 19-SW-61	DRAWING NUMBER
8	22/07/08	75-PW-66A MADE REDUNDANT & ADDED 75-PW-66D	TW	MS	MS	13B	21/01/16	MOVED 19CP80 FROM TIER 9R-4 TO 8R-5, ISSUED FOR ENGINEERING REVIEW	RH	CJ	AD	SUBSTATION No.60 MCC 19-SW-61 DRIVE PANEL LAYOUT	19\EL1152	APPROVED	A.BRADY	10/10/97	SINGLE LINE DIAGRAM SHEET 3	A1
17	25/03/22	SUBSTATION LAYOUT UPDATED	RH	RH	RH	13A	22/12/15	TIER 9R-4 FIM SAG BRAKE PROJECT, ISSUED FOR ENGINEERING REVIEW	RH	AR	AR	SUBSTATION No.60 MCC AND GENERAL EQUIPMENT LAYOUT	19\EL1050	PROJ.APP	A.BRADY	10/10/97		
MK	DATE	REVISION	BY	CKD	APP	MK	DATE	REVISION	BY	CKD	APP	REFERENCE DRAWINGS	DWG NO.	PROJ. FILE #.			KALGOORLIE CONSOLIDATED GOLD MINES PTY. LTD. ABN 009 377 619 003	REV