


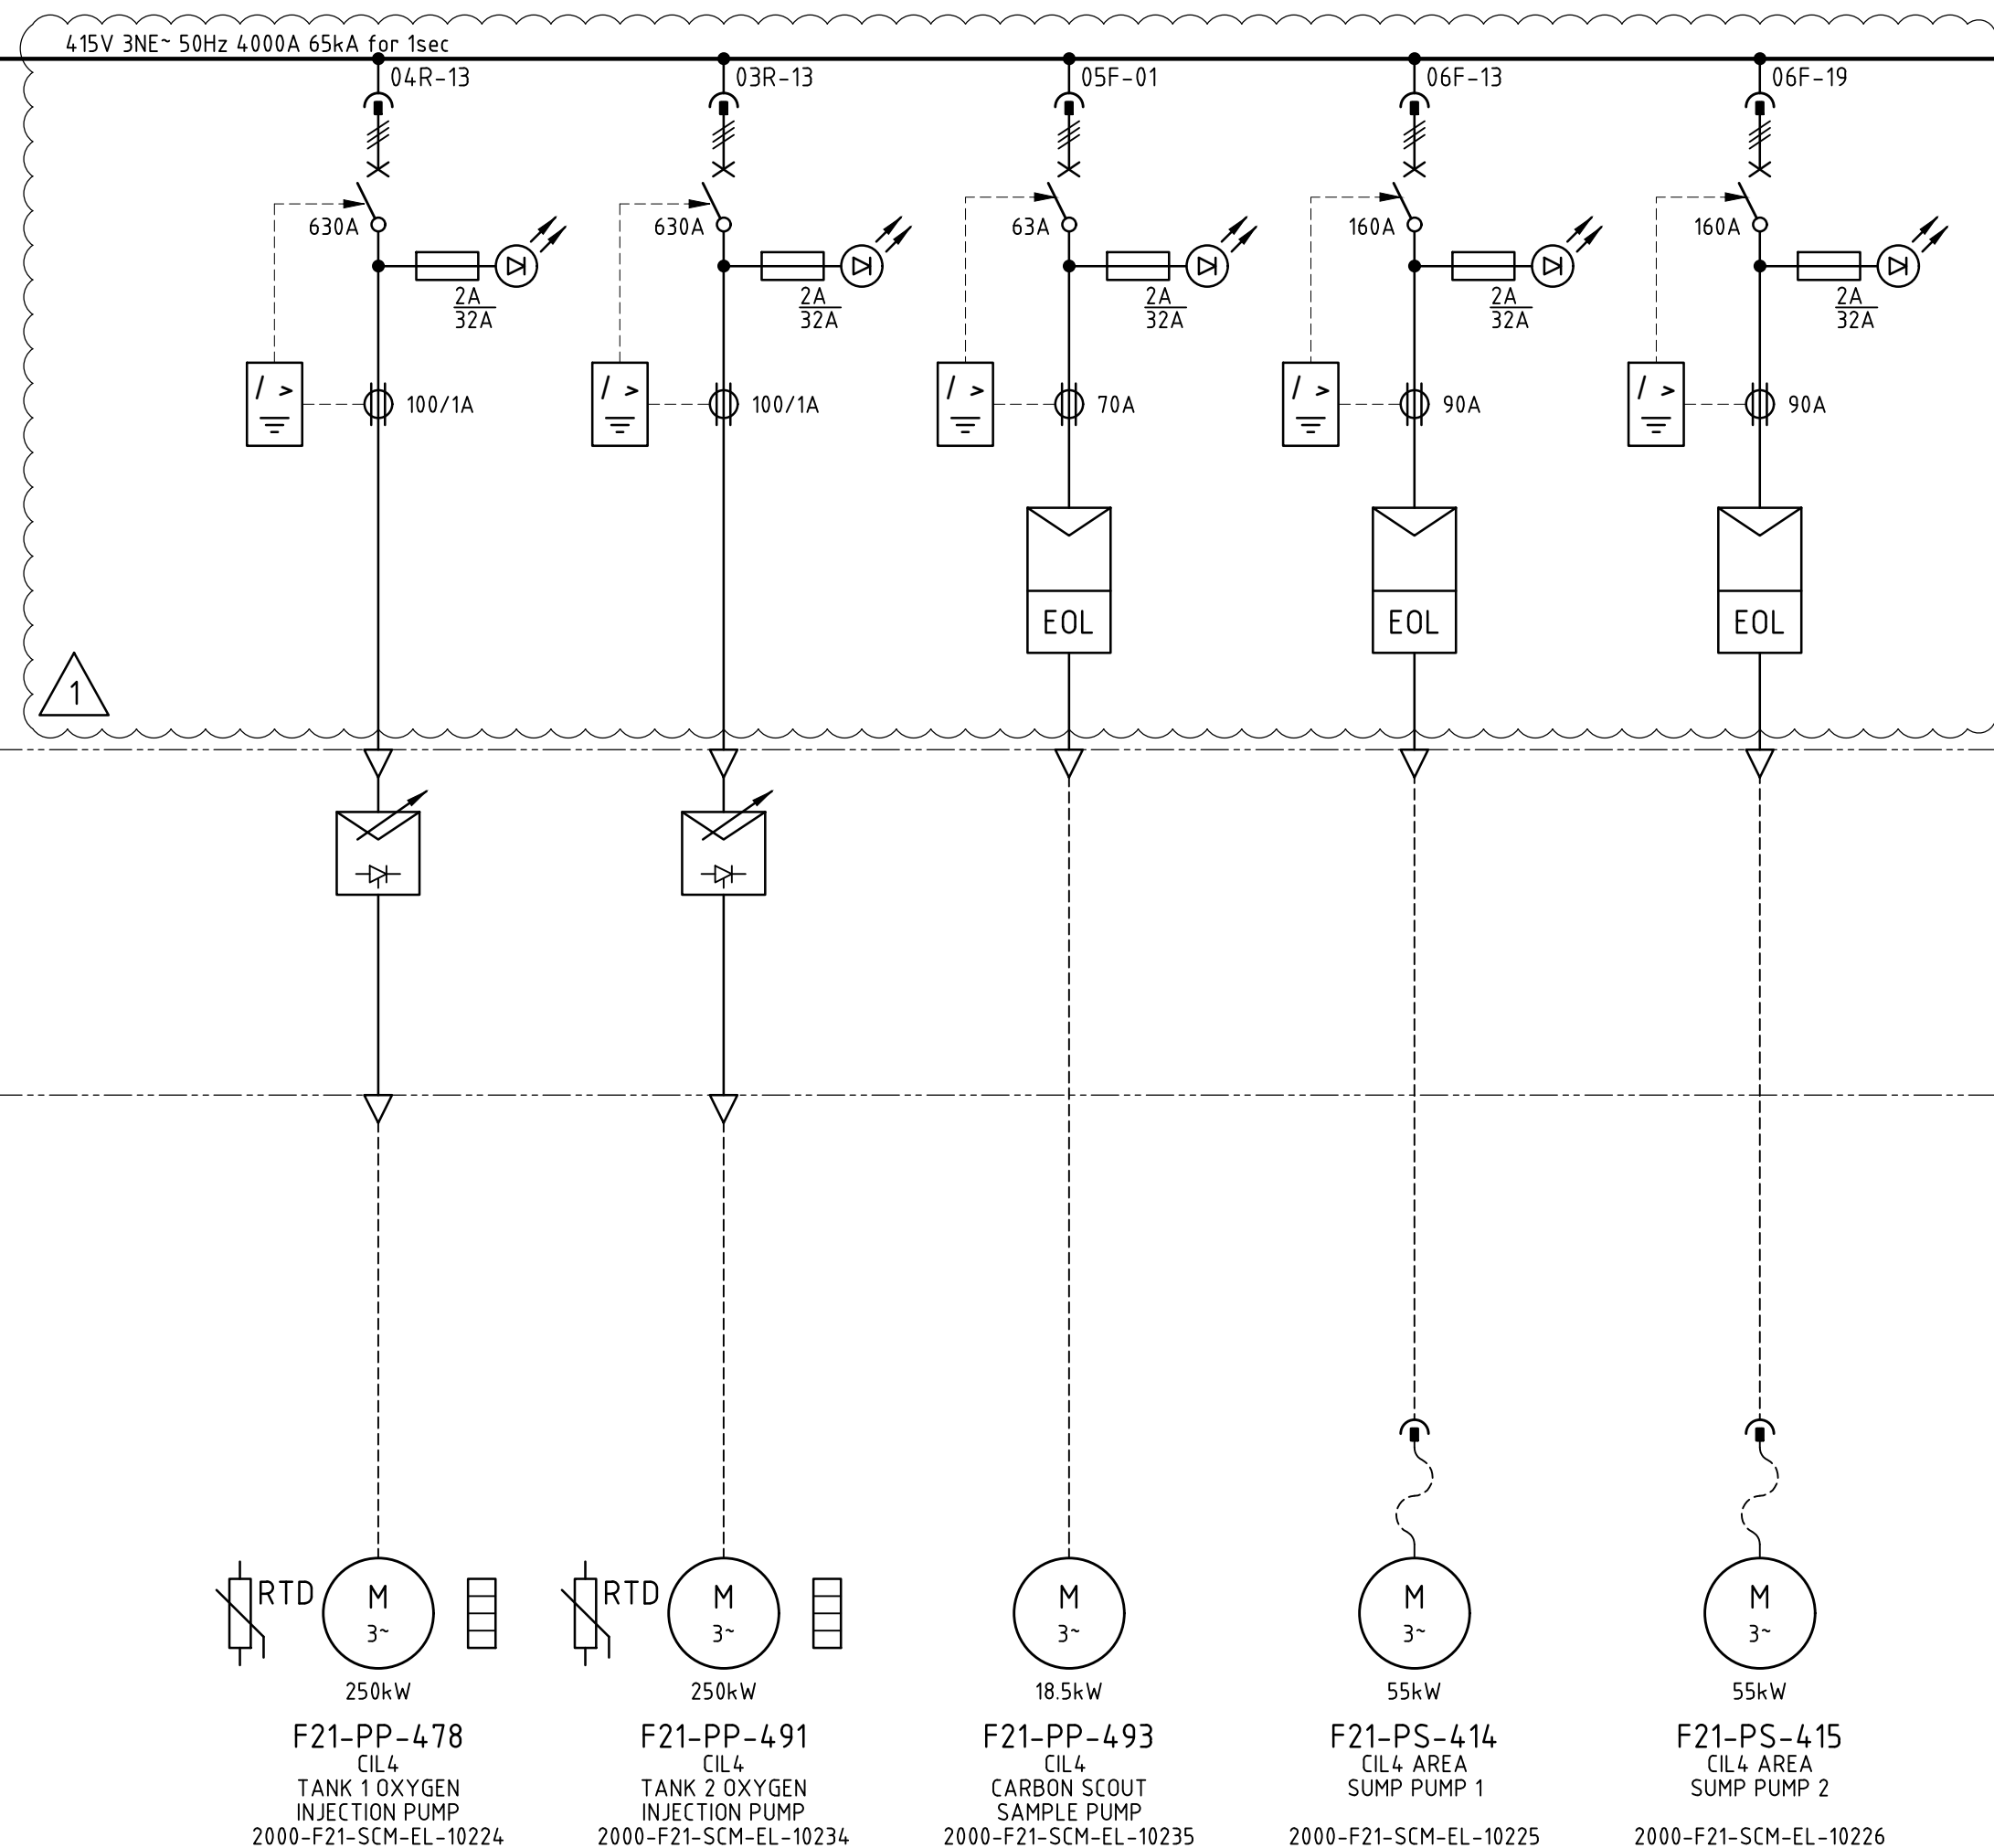

CONTINUED ON SHT 2
0000-F21-SLD-EL-10202

CONTINUED ON SHT 4
0000-E21-SI D-EL-10204

[illegible]

PRIMERO
primero.com.au | DESIGN | CONSTRUCT | OPERATE

PRIMERO PROJECT NUMBER: **23517**

INFORMATION AND REPRESENTATIONS ON THIS DRAWING ARE THE INTELLECTUAL PROPERTY OF PRIMERO UNLESS SPECIFICALLY IDENTIFIED OTHERWISE. ALL RIGHTS INCLUDING USE RESERVED

PROJECT: NORTHERN STAR RESOURCES LTD
KCGM GROWTH PROJECT

TITLE: FLOTATION TAILINGS CIL4
F21-SW-006 415V MCC
SINGLE LINE DIAGRAM SHEET 3

SHEET
A1

SCALE
NONE

DRG No.	
---------	--

2000-F21-SLD-EL-10203

REVISION

REV

NOTES

1. REFER TO SHEET 1.

LEGEND

1. REFER TO SHEET 1.



Approved	☒
----------	-------------------------------------

Approved as Noted	
-------------------	--

Not Approved

For Information Only	
----------------------	--

Signed	Date
	19/11/2025

ACCEPTANCE DOES NOT RELIEVE THE SUPPLIER /
CONTRACTOR OF ITS RESPONSIBILITY OR LIABILITIES
UNDER THE PURCHASE ORDER / CONTRACT