


D:\CAD PROJECTS\235 NORTHERN STAR RESOURCES LTD\23517 KCGM GROWTH PROJECT\03 DELIVERABLES\EL\F22 - CIL4 CARBON TREATMENT & ELUTION\2000-F22-SLD-EL-10261.DWG 18DEC25 12:14:PM HOTSEA104

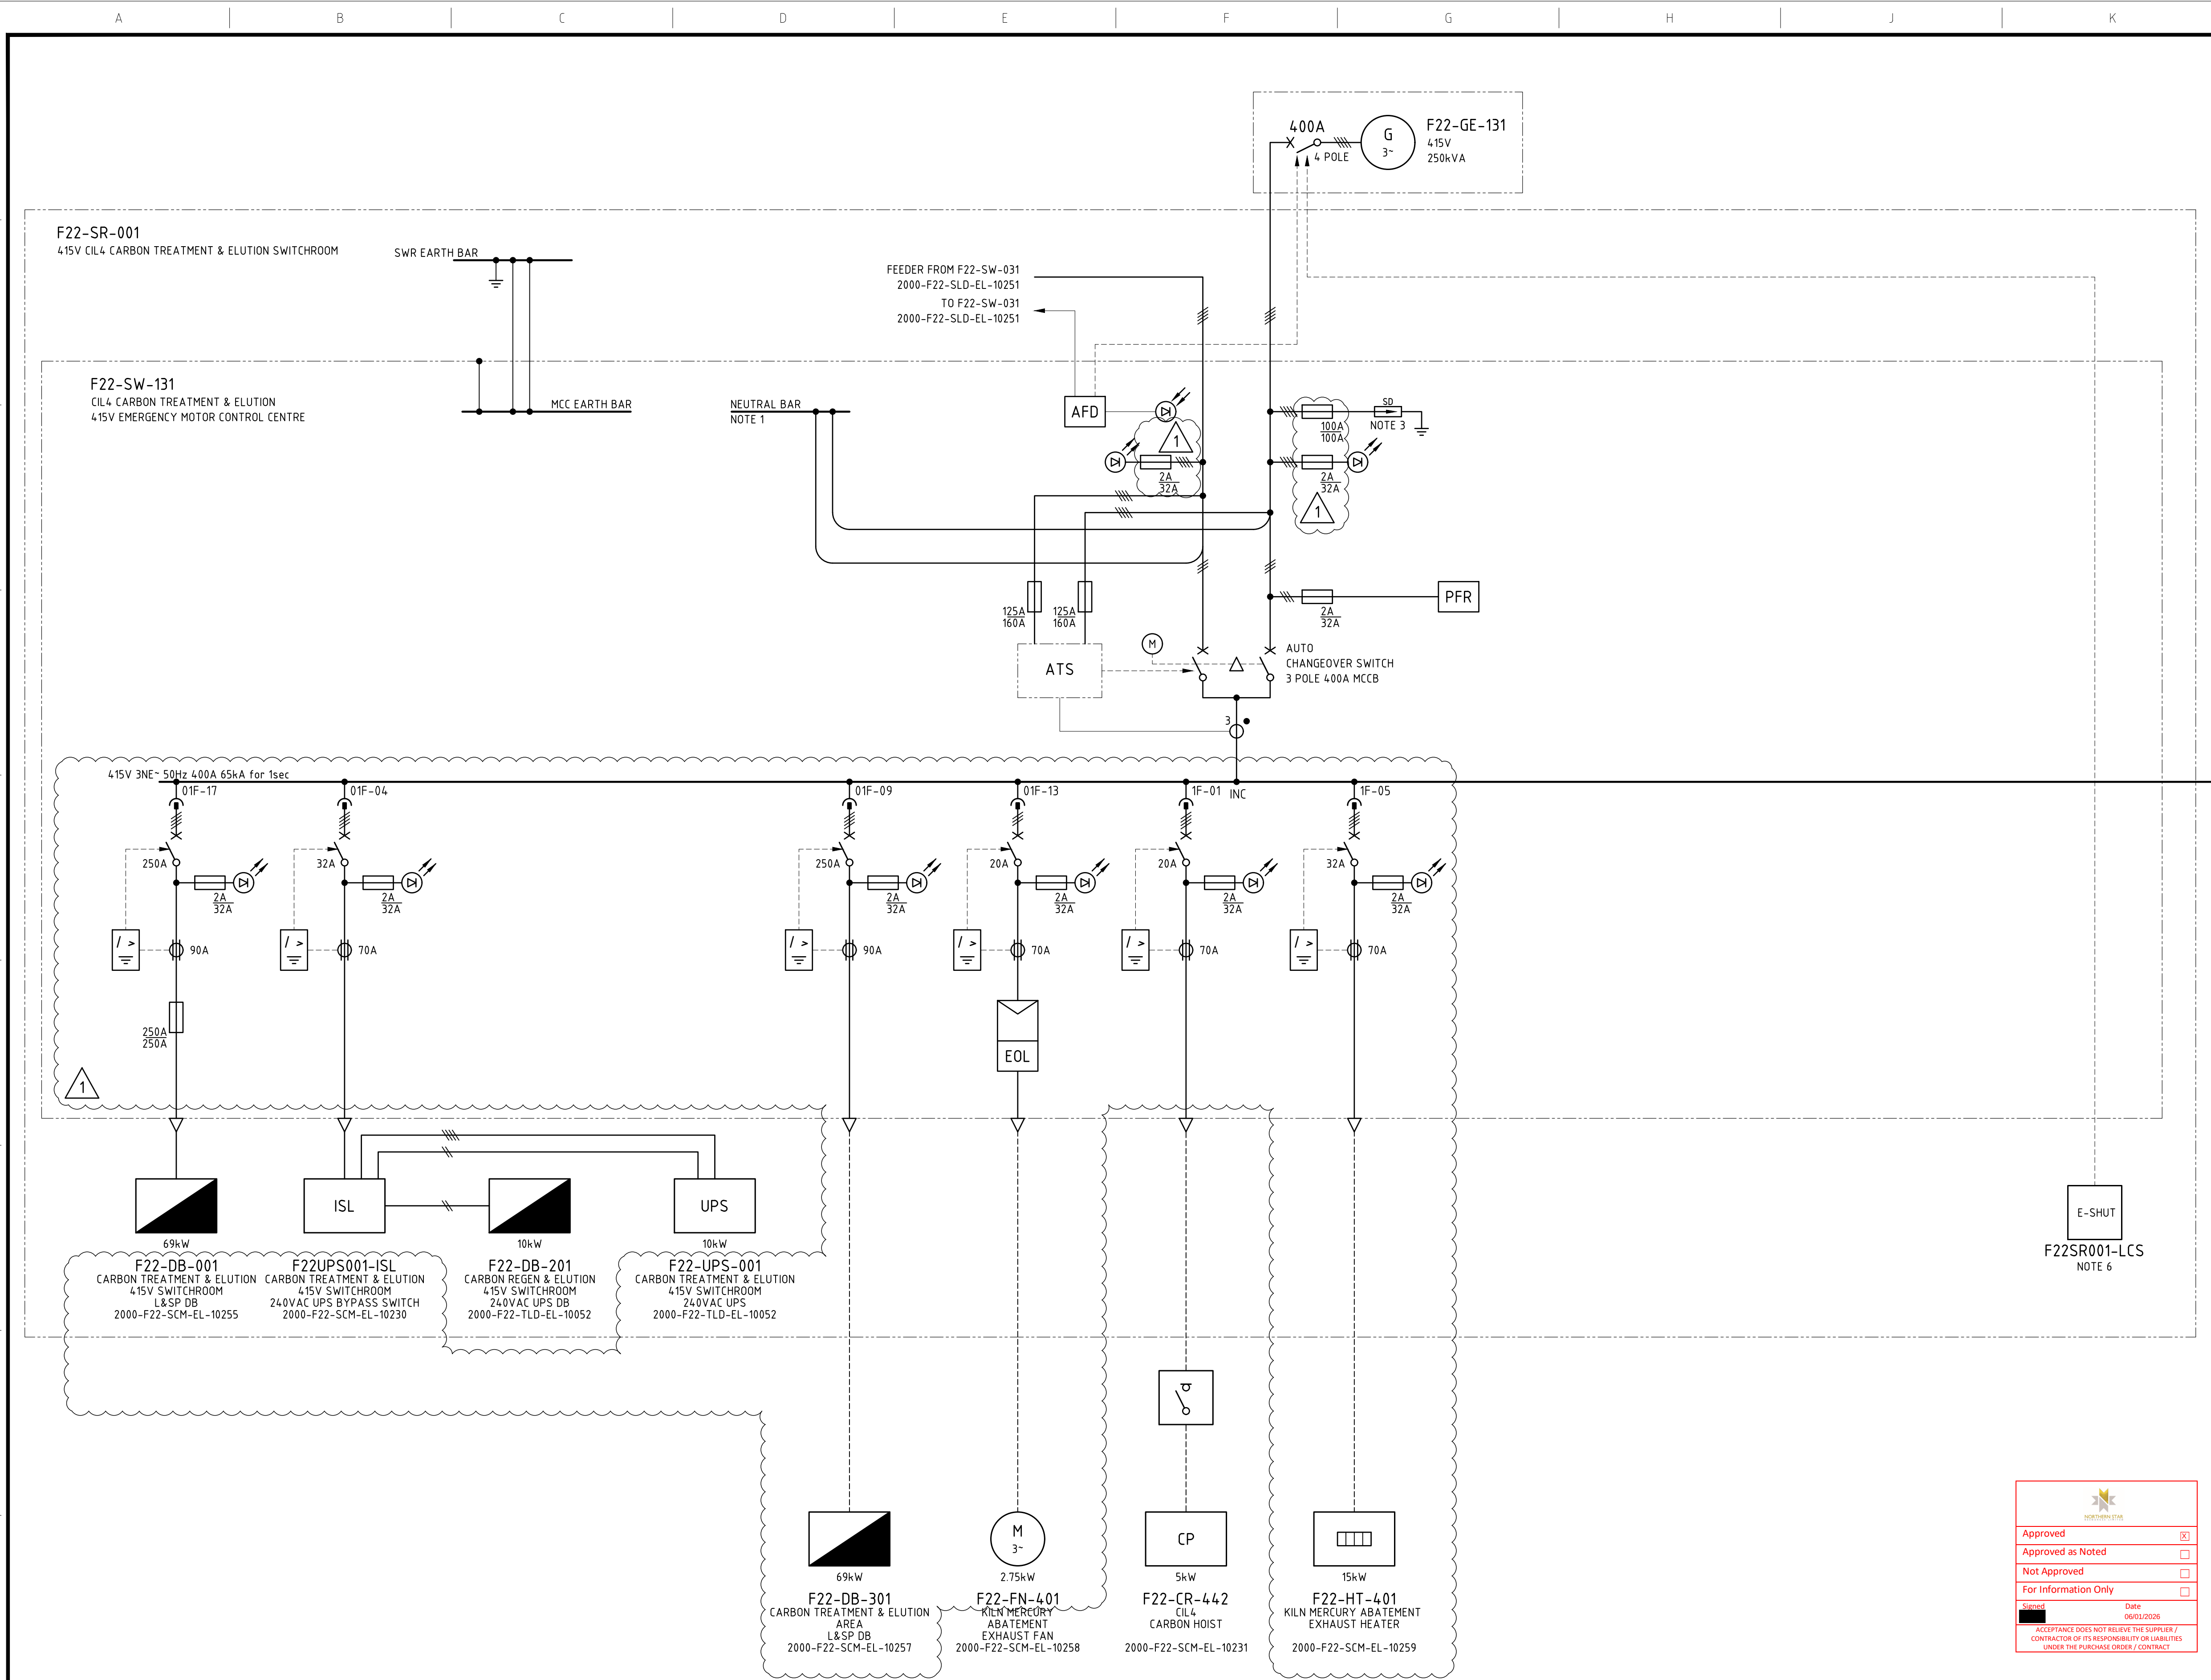

NOTES

- EARTH-NEUTRAL LINK INSTALLED IN UPSTREAM F22-SW-030 INCOMER TIER. SIGNAGE SHALL BE PLACED ON F22-SW-131 SWITCHBOARD AND ON GENERATOR READING "M.E.N. LINK LOCATED IN F22-SW-030 INCOMER TIER"
- SWITCHBOARD SHALL BE EXTENSIBLE AND BE PROVIDED WITH THE FACILITY TO EXTEND THE MAIN BUSBAR AND APPEND ADDITIONAL TIERS AT ONE END WITHOUT MAJOR STRUCTURAL DISASSEMBLY.
- SURGE DIVERTERS SHALL PROVIDE FEEDBACK TO DCS VIA VOLT-FREE CONTACTS. SURGE DIVERTER FUSES SHALL BE SIZED BY VENDOR TO SUIT DUTY.
- MINIATURE CIRCUIT BREAKERS SHALL BE SIZED AND RATED TO SUIT ACB AND INCOMER REQUIREMENTS.
- CIRCUIT BREAKER TO BE SUBSTITUTED FOR FUSED-SWITCH WHERE REQUIRED BY EQUIPMENT MANUFACTURERS GUIDELINES.
- EMERGENCY SHUTDOWN (E-SHUT) PUSH BUTTON WIRED TO SHUNT TRIP NOMINATED CIRCUIT BREAKERS.
- SWITCHBOARD VENDOR SHALL SELECT SWITCHGEAR TO PROVIDE TYPE-2 CO-ORDINATION SUITABLE FOR HIGH EFFICIENCY MOTORS.
- ALL DRIVE I/O VIA COMMS NETWORK TO DCS. FOR COMMUNICATIONS BLOCK DIAGRAM REFER 2000-F22-BLK-IC-10001.

LEGEND

- PFR** PHASE FAILURE RELAY
- ELR** EARTH LEAKAGE RELAY
- ST TRIP SET POINT**
CB SIZE
- AFD** ARC FLASH DETECTION
- ECR** EARTH CONTINUITY RELAY
- E-SHUT** SWITCHROOM EMERGENCY SHUTDOWN
- DM** DIRECT ON-LINE MOTOR STARTER
GENERIC - NOTE 7,8
- EOL** ELECTRONIC OVERLOAD UNIT
NOTE 7,8

NORTHERN STAR	
Approved	☒
Approved as Noted	☐
Not Approved	☐
For Information Only	☐
Signed	Date
	06/01/2026
ACCEPTANCE DOES NOT RELIEVE THE SUPPLIER / CONTRACTOR OF ITS RESPONSIBILITY ON LIABILITIES UNDER THE PURCHASE ORDER / CONTRACT	

DRG No.	REFERENCES	REV	DATE	DESCRIPTION	DRAW	CHECK	DESIGN	TECH APP	PROJ APP
2000-F22-SCM-EL-10254	F22-SW-031 415V MCC ARC FLASH SYSTEM SCHEMATIC DIAGRAM								
2000-F22-SCM-EL-10253	F22-SW-031 415V MCC 24VDC DISTRIBUTION SCHEMATIC DIAGRAM								
2000-F22-SCM-EL-10272	F22-SW-131 415V EMERGENCY MCC INCOMER SCHEMATIC DIAGRAM								
2000-F22-DRG-EL-10101	F22-SR-001 415V SWITCHROOM ELECTRICAL EQUIPMENT LAYOUT								
2000-F22-BLK-IC-10001	F22-SR-001 415V SWITCHROOM AND REMOTE I/O COMMUNICATIONS BLOCK DIAGRAM								
2000-F22-SLD-EL-10251	F22-SW-031 415V MCC SINGLE LINE DIAGRAM SHEET 1	1	24NOV25	FAT REDLINES INCORPORATED					
2000-F00-STD-EL-10001	GENERAL NOTES AND STANDARD DRAWINGS INDEX	0	05NOV24	APPROVED FOR CONSTRUCTION					



INFORMATION AND REPRESENTATIONS ON THIS DRAWING ARE THE INTELLECTUAL PROPERTY OF PRIMERO UNLESS SPECIFICALLY IDENTIFIED OTHERWISE. ALL RIGHTS INCLUDING USE RESERVED

PROJECT:	NORTHERN STAR RESOURCES LTD KCGM GROWTH PROJECT		
TITLE:	CIL4 CARBON TREATMENT & ELUTION F22-SW-131 415V EMERGENCY MCC SINGLE LINE DIAGRAM		
SHEET	SCALE	DRG No.	REVISION
A1	NONE	2000-F22-SLD-EL-10261	1