


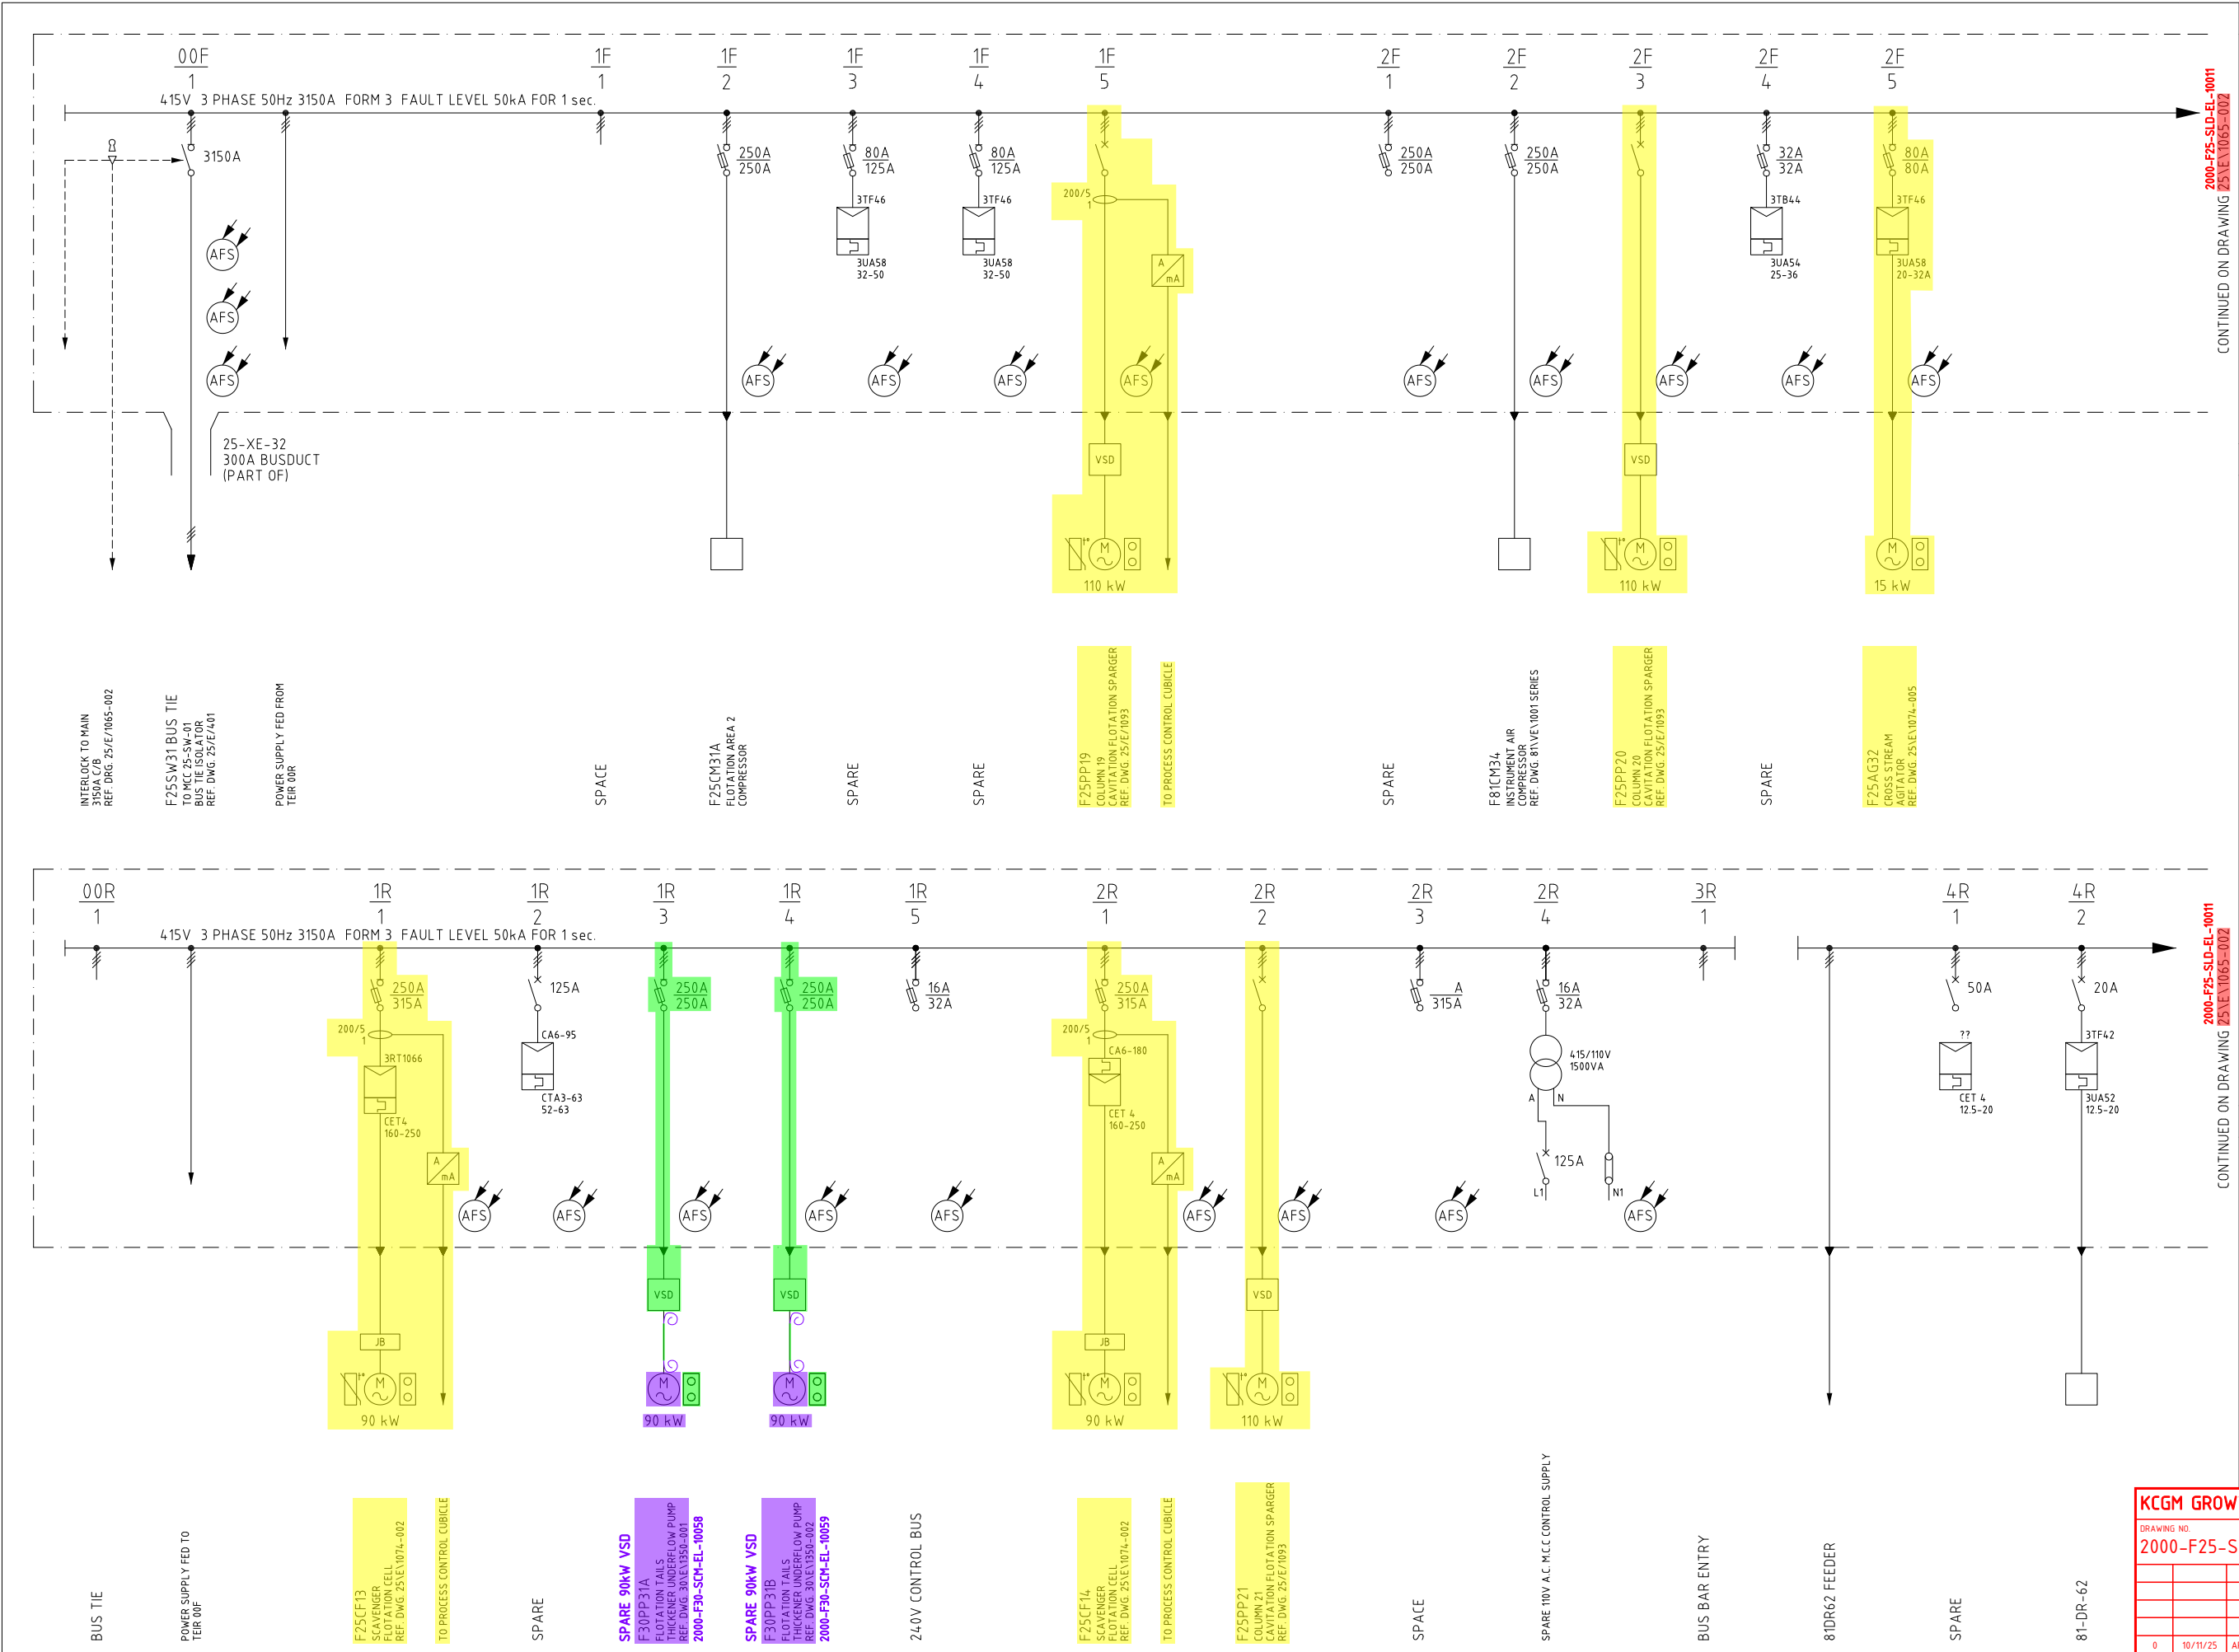

LEGEND

Approved☒


Approved as Noted☐

Not Approved☐

For Information Only☐

Signed **C Laird** Date **20/11/2025**

ACCEPTANCE DOES NOT RELIEVE THE SUPPLIER / CONTRACTOR OF ITS RESPONSIBILITY OR LIABILITIES UNDER THE PURCHASE ORDER / CONTRACT

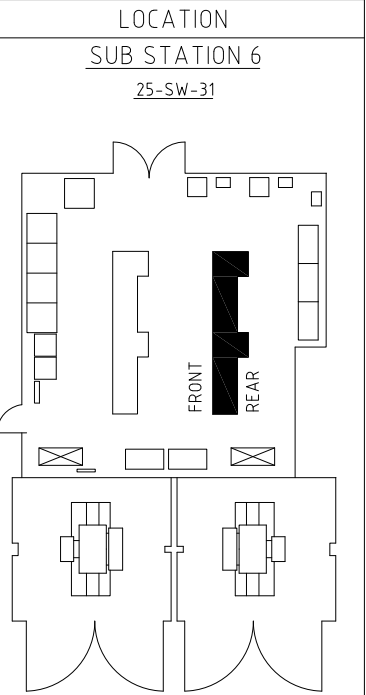

NOTES

1. ALL AFS (ARC FLASH SENSORS) ARE CONNECTED TO THE ARC FLASH RELAY VIA I/O UNITS

LEGEND

EXISTING

NON-EXISTENT

STAGE 1 - NEW

STAGE 1 - REMOVE

STAGE 1 - DECOMMISSIONED (OTHERS)

STAGE 2 - NEW

STAGE 2 - REMOVE

STAGE 2 - DECOMMISSIONED (OTHERS)

KCGM GROWTH PROJECT					
DRAWING NO. 2000-F25-SLD-EL-10010					
REV	DATE	DESCRIPTION	CHECK	TECH	APP
0	10/11/25	APPROVED FOR CONSTRUCTION			DM

12	10/07/18	ARC FLASH SENSORS INSTALLED	RH	JMR	JMR	6	22/05/14	AS BUILT	RH	SK	SK			SCALE	NTS			
11	11/04/16	AS BUILT	SK			5	27/09/12	GENERAL INFORMATION UPDATED						DRAWN		01/10/00		
10	02/09/15	AS BUILT	SK			16	07/11/22	30PP31A & 31B DRAWING NUMBERS UPDATED						DESIGNED	KCGM	01/10/00		
9	30/10/14	FLOTATION COLUMN 19,20 & 21 CAVITATION SPARGER PUMPS INFO UPDATED	SK			15	11/07/22	81CM34 REF. DWG. ADDED						CHECKED	KCGM	01/10/00		
8	21/10/14	25CM31B RELOCATED FROM 2F/1 TO 4F/3 DURING SHUTDOWN	SK			14	08/10/19	2019 S.L.D. UPDATE PROJECT "AS BUILT"						APPROVED	KCGM	01/10/00		
7	08/07/14	FLOTATION COLUMN 19,20 & 21 CAVITATION SPARGER PUMPS INSTALLED	SK			13	08/08/19	2019 S.L.D. UPDATE PROJECT "AS BUILT" - FIELD REVIEW						PROJ.APP	KCGM	01/10/00		
MK	DATE	REVISION	BY	CKD	APP	MK	DATE	REVISION	BY	CKD	APP			REFERENCE DRAWINGS	DWG NO.	PROJ. FILE #.		

FIMISTON PLANT
FLOTATION
SUBSTATION No.6 415V MCC 25SW31
SINGLE LINE DIAGRAM

SIZE A1

DRAWING NUMBER 25\E\1065-001

REV 16

KALGOORLIE CONSOLIDATED GOLD MINES PTY. LTD. ABN 009 377 619 003