


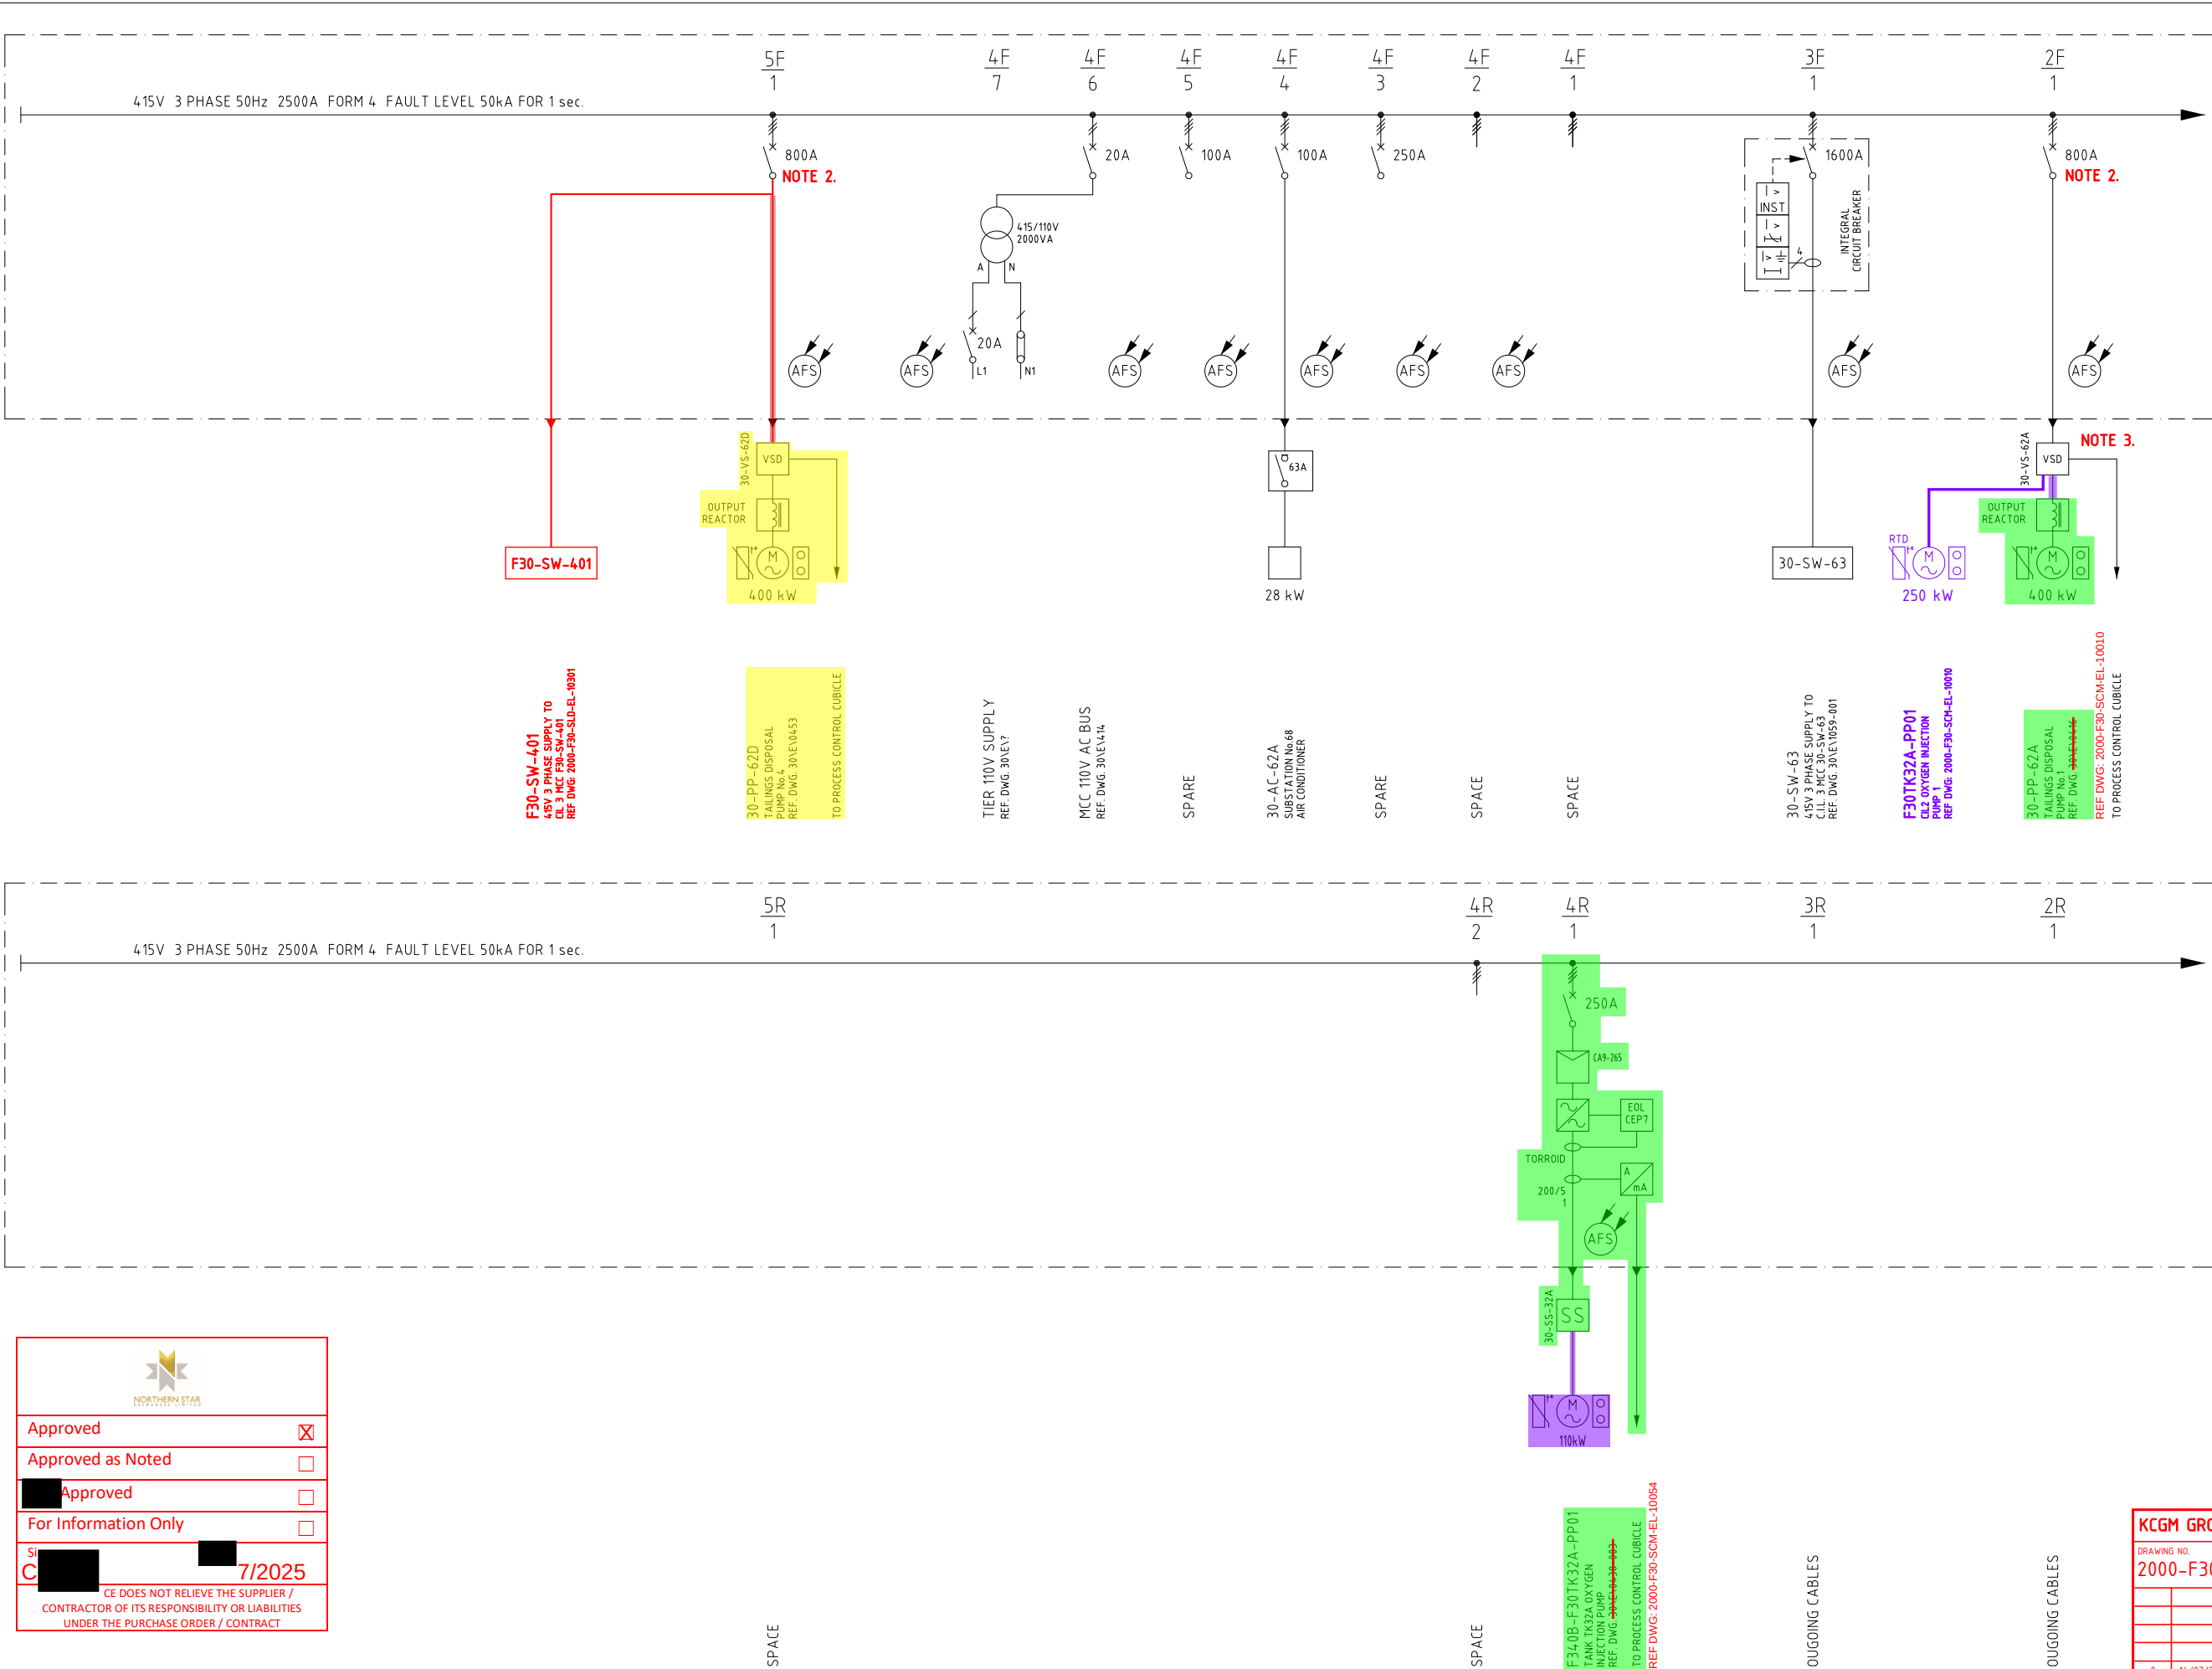

LEGEND

LOCATION

SUB STATION 68
30-SW-62

NOTES

1. ALL AFS (ARC FLASH SENSORS) ARE CONNECTED TO THE ARC FLASH RELAY VIA I/O UNITS

2. MCC FEEDER RE-PURPOSED AS PART OF THE KCGM GROWTH PROJECT.

3. VSD RE-PURPOSED AS PART OF THE KCGM GROWTH PROJECT.

LEGEND

STAGE 1 - NEW

STAGE 1 - REMOVE

STAGE 1 - DECOMMISSIONED (OTHERS)

STAGE 2 - NEW

STAGE 2 - REMOVE

STAGE 2 - DECOMMISSIONED (OTHERS)

Approved

Approved as Noted

Approved

For Information Only

7/2025

CE DOES NOT RELIEVE THE SUPPLIER / CONTRACTOR OF ITS RESPONSIBILITY OR LIABILITIES UNDER THE PURCHASE ORDER / CONTRACT

KCGM GROWTH PROJECT

DRAWING NO.

2000-F30-SLD-EL-10101

REV	DATE	DESCRIPTION	CHECK	TECH APP
0	14/07/25	APPROVED FOR CONSTRUCTION		

9	12/03/21	ISSUED FOR CONSTRUCTION - OXYGEN INJECTION PROJECT	AAM	CV	BH	4B	26/11/13	APPROVED FOR TENDER PURPOSES ONLY	PDW	WJ/TB	SCALE	NTS	FIMISTON PLANT CARBON IN LEACH (C.I.L. 3) SUBSTATION No 68 MCC 30-SW-62 SINGLE LINE DIAGRAM	SIZE A1	DRAWING NUMBER 30\EX1058-001	REV 11
8	16/09/20	2019 S.L.D. UPDATE PROJECT "AS BUILT"	RA	4A	15/10/13	ISSUED FOR INTERNAL REVIEW				DRAWN	09/07/97					
7A	23/08/19	2019 S.L.D. UPDATE PROJECT "AS BUILT" - FIELD REVIEW	RH	4	01/12/06	GENERAL REVISION				DESIGNED	09/07/97					
6	20/03/18	EQUIPMENT ON DRAWING REPOSITIONED & ARC FLASH PROTECTION INSTALLED	JMR	3	21/04/04	30PP62D FEEDER ADDED				CHECKED						
5	22/10/14	SCOPE REVISION. NO CHANGE FROM REV 4.	PI	11	11/03/22	AS BUILT		GB		APPROVED						
4C	03/04/14	ADDED FEED TO 30-SW-62 & NOTES, REINSTATED FEEDERS 5F/1 & 3F/1	BW	WJ/JM	10	12/10/21	RE-ISSUED FOR CONSTRUCTION		CV	JB						
MK	DATE	REVISION	BY	CKD	APP	MK	DATE	REVISION	BY	CKD	APP	REFERENCE DRAWINGS	DWG NO.	PROJ. FILE #.	KALGOORLIE CONSOLIDATED GOLD MINES PTY. LTD. ABN 009 377 619 003	