


BUS ZONE

LEGEND

- EXISTING
- NON-EXISTENT
- STAGE 1 - NEW
- STAGE 1 - REMOVE
- STAGE 1 - DECOMMISSIONED (OTHERS)
- STAGE 2 - NEW
- STAGE 2 - REMOVE
- STAGE 2 - DECOMMISSIONED (OTHERS)

SUB STATION 68
30-SW-63

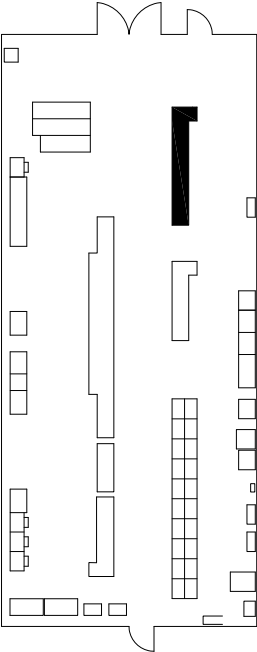

1. 30-FN-62B & 62C START/STOP IS INTERLOCKED WITH TAILINGS PUMPS 30-PP-62B & C RESPECTIVELY
2. ALL AFS (ARC FLASH SENSORS) ARE CONNECTED TO THE ARC FLASH RELAY VIA I/O UNITS
3. 30-SC-62B,C,D,E,F ROTATE THROUGH WHEN MAINTENANCE REQUIRED

D.1. VSD OUTGOING FIELD CABLES CABLES TO BE DISCONNECTED AND MADE SAFE AT BOTH ENDS.

DRAWING NO.
2000-F30-SLD-EL-10103

[illegible]

10	22/10/16	SCOPE REVISION. NO CHANGE FROM REV 7.		DR	PI	JM	6	03/07/06	UPDATE JULY 2006	BJ						SCALE			NTS		FIMISTON PLANT	SIZE	DRAWING NUMBER	REV
9	03/04/16	ADDED CONSTRUCTION NOTES AND BATTERY LIMITS		PW	W/J/JM		5	16/08/04	LEACH, ADSORPTION & THICKENING TAILINGS SAMPLING PROJECT ADDED	SM						DRAWN			09/07/97	A1	30\EX1059-001	13		
8	14/02/16	APPROVED FOR CONSTRUCTION		PI/KE	W/J/TB		4	11/06/99	30-FN-62B & 62C INTERLOCK TO 30-PP-62B & 62C	CV						DESIGNED			09/07/97					
8B	26/11/13	APPROVED FOR TENDER PURPOSES ONLY			W/J/TB		13	14/09/20	2019 S.L.D. UPDATE PROJECT "AS BUILT"	CS						CHECKED			09/07/97					
8A	15/10/13	ADDED INCOMER			W/J/TB		12A	23/08/19	2019 S.L.D. UPDATE PROJECT "AS BUILT"-- FIELD REVIEW	RH						APPROVED			09/07/97					
7	01/12/06	GENERAL REVISION					11	21/03/18	ARC FLASH PROTECTION INSTALLED	JMR						PROJ APP			09/07/97					
MK	DATE	REVISION		BY	CKD	APP	MK	DATE	REVISION	BY	CKD	APP				REFERENCE DRAWINGS			DWG NO.	PROJ FILE #	KALGOORLIE CONSOLIDATED GOLD MINES PTY. LTD. ABN 009 377 619 003			