


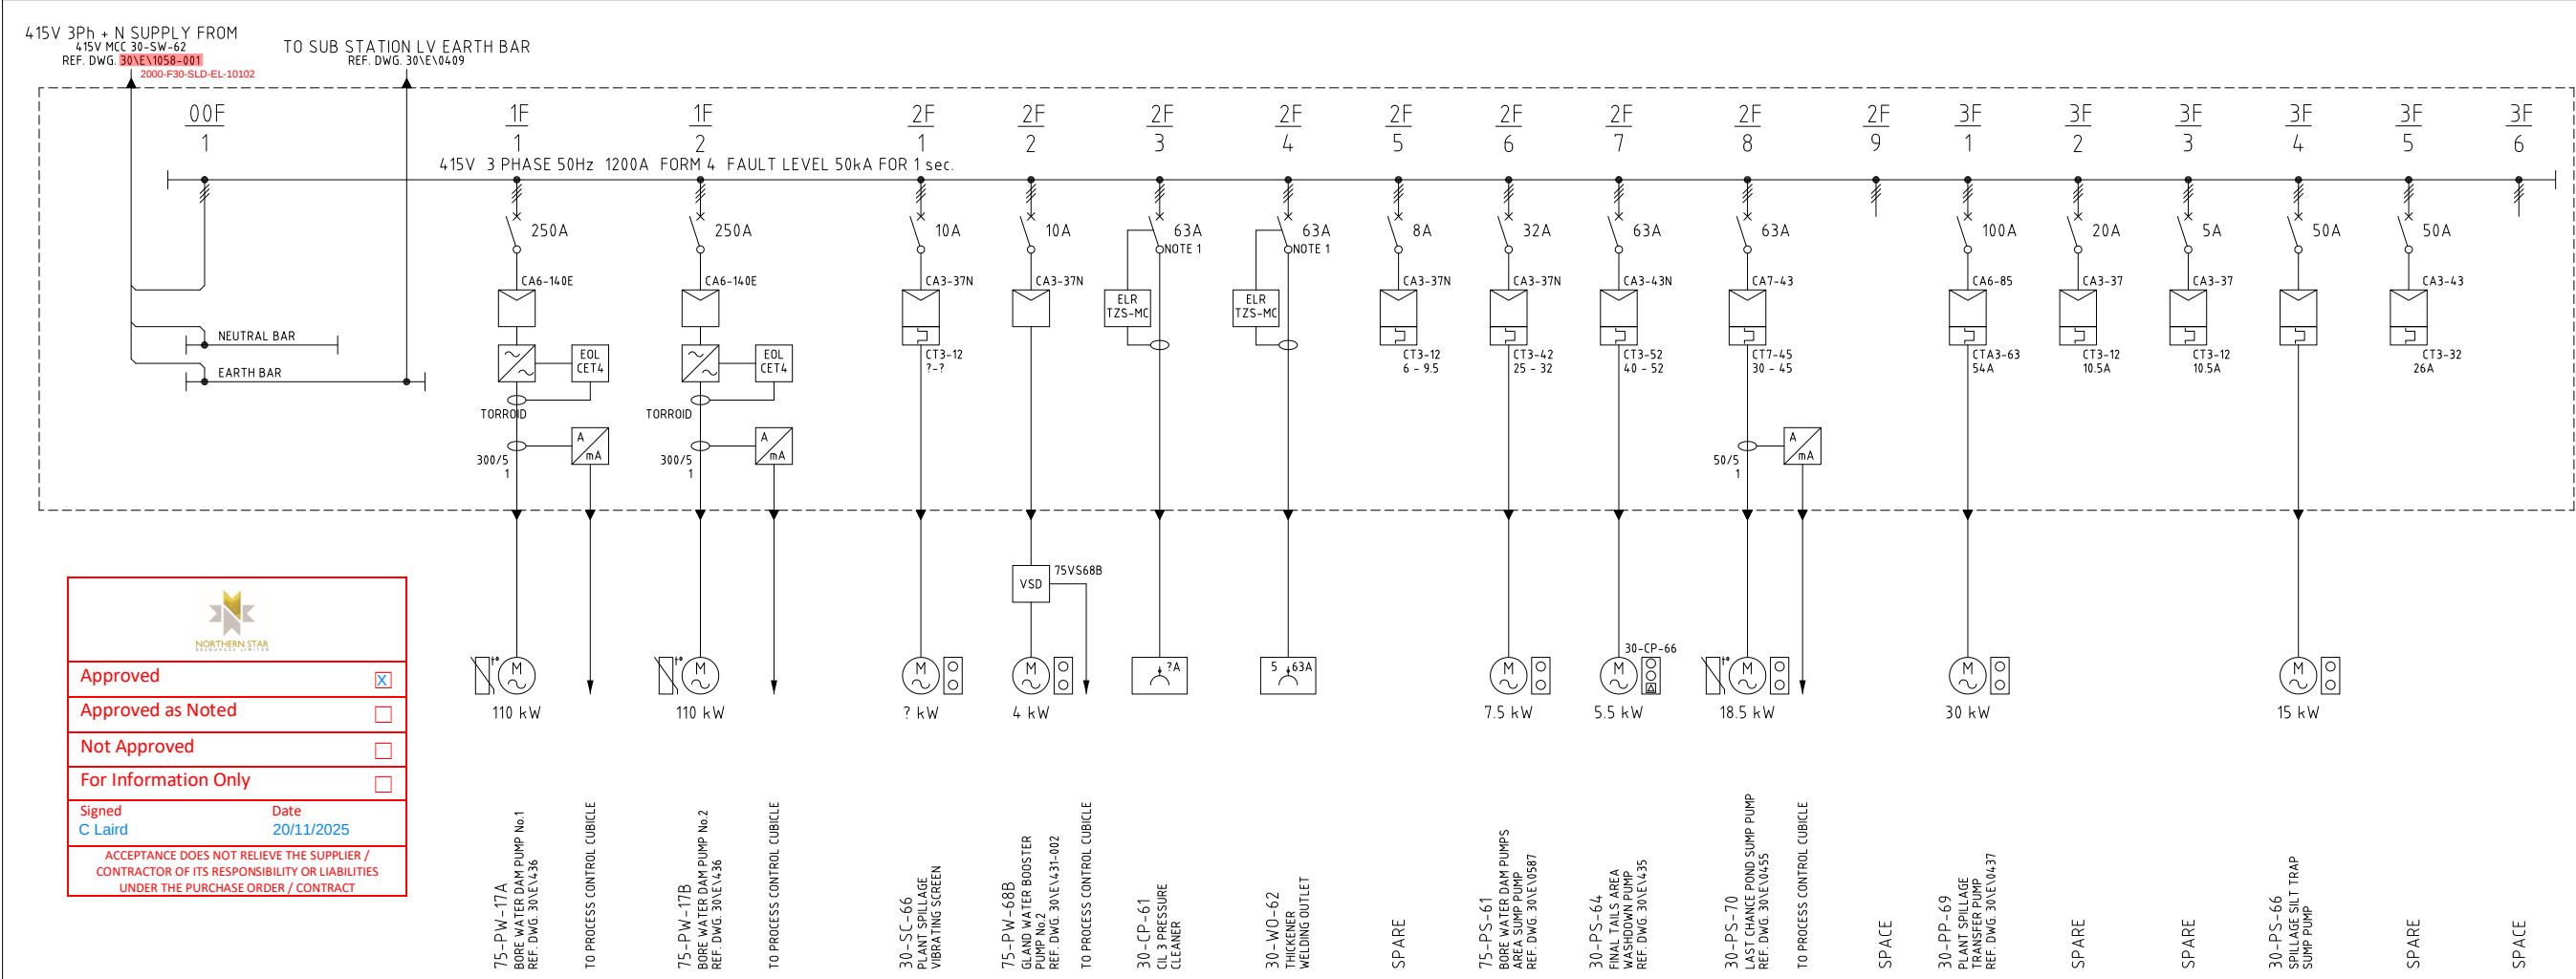

Approved ☒




Approved as Noted ☐

Not Approved ☐

For Information Only ☐

Signed **C Laird** Date **20/11/2025**

ACCEPTANCE DOES NOT RELIEVE THE SUPPLIER / CONTRACTOR OF ITS RESPONSIBILITY OR LIABILITIES UNDER THE PURCHASE ORDER / CONTRACT

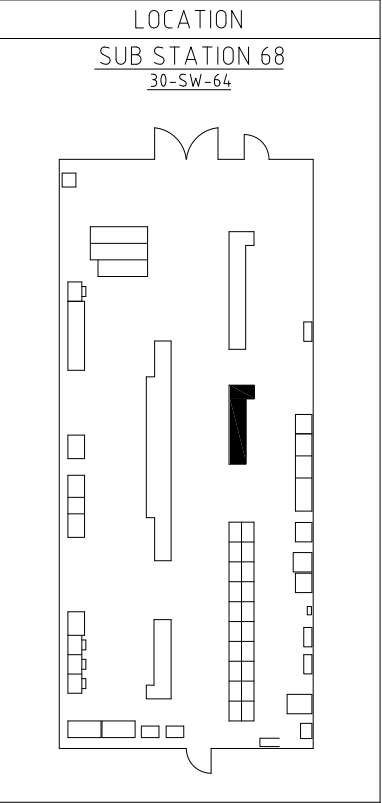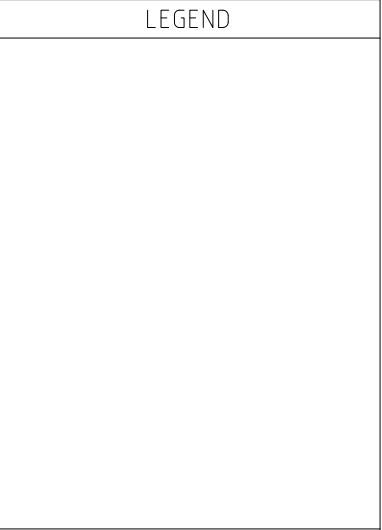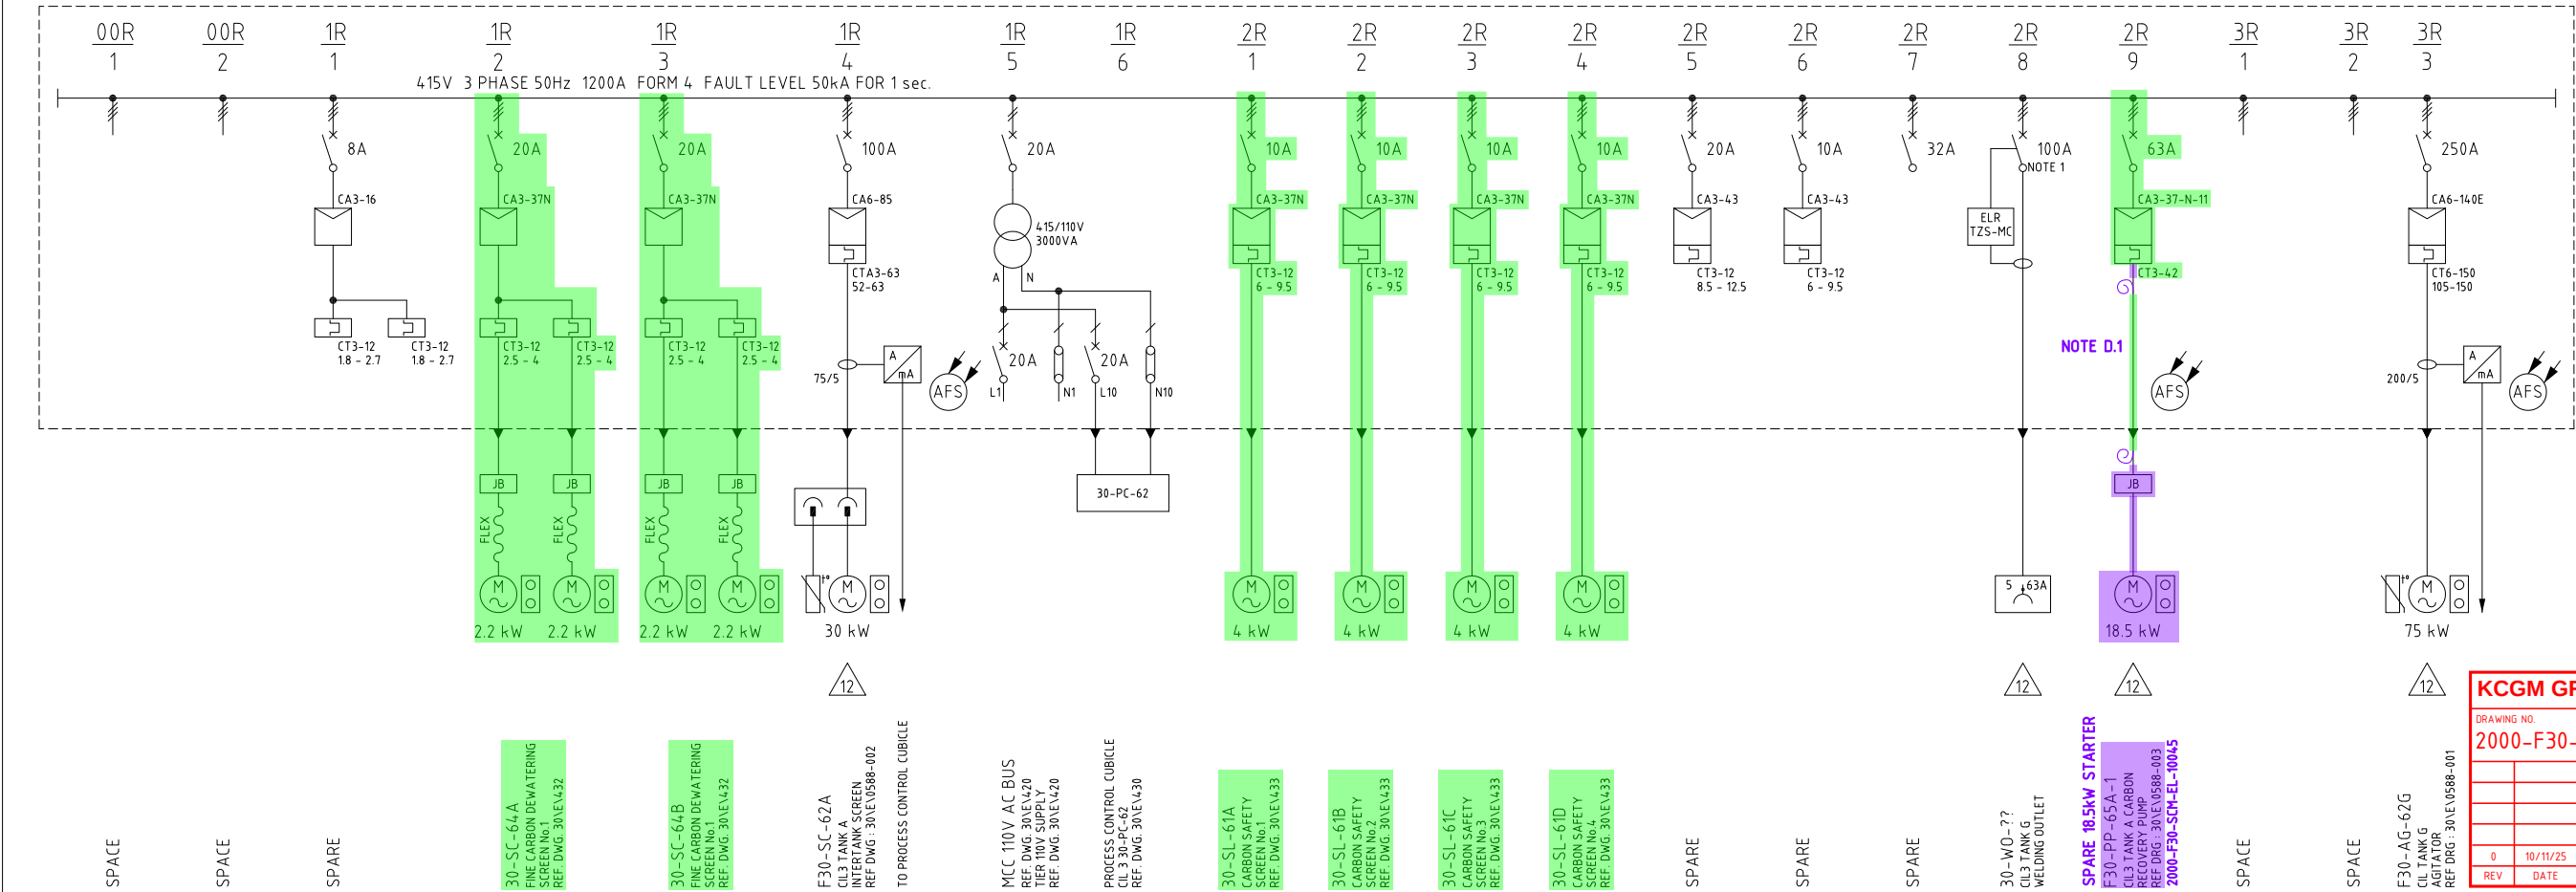

NOTES

1. EARTH LEAKAGE CIRCUIT BREAKERS SHALL HAVE 300mA SENSITIVITY FOR WELDING OUTLETS.

KCGM GROWTH PROJECT DEMOLITION NOTES

D.1. F30-PP-65A-1 CABLING TO BE DISCONNECTED AND MADE SAFE AT BOTH ENDS.

LEGEND

—	STAGE 1 - NEW
—	STAGE 1 - REMOVE
—	STAGE 1 - DECOMMISSIONED (OTHERS)
—	STAGE 2 - NEW
—	STAGE 2 - REMOVE
—	STAGE 2 - DECOMMISSIONED (OTHERS)

KCGM GROWTH PROJECT

DRAWING NO. 2000-F30-SLD-EL-10105

REV	DATE	DESCRIPTION	CHECK	TECH APP
0	10/11/25	APPROVED FOR CONSTRUCTION		

12	10/07/24	ISSUED FOR CONSTRUCTION	PM	CL	RH	6	3-5-07	30PS66 & 30PS67 DRIVE MADE REDUNDANT	BJ			SCALE	NTS				
11	08/11/23	AS BUILT		KVN		5	1-12-06	GENERAL REVISION				DRAWN		9/7/97			
10A	23/08/19	2019 S.L.D. UPDATE PROJECT "AS BUILT"- FIELD REVIEW		RH		4	2/4/02	AGITATOR ADDED TO 30-PS-66		IGC		DESIGNED		9/7/97			
9	19/04/12	75PW688 VSD INSTALLED		AM		3	26/07/99	NEW PLANT SPILLAGE TIERS SF/1-5		CV	PRL	CHECKED					
8	3/03/09	ADDED 75PS06 PUMP DETAILS		MS	MS	2	1/07/99	TIER 2F/1 75-PW-68A NOW SPARE		CV	RB	APPROVED					
7	16/7/08	ADDED 30-PS-70 LAST CHANCE POND SUMP PUMP		TW	MS	1	7/97	'AS BUILT' FIMISTON PLANT 1997 CONTRACT# 700746				PROJ.APP					
MK	DATE	REVISION	BY	CKD	APP	MK	DATE	REVISION	BY	CKD	APP	DWG NO.	PROJ. FILE #				

REFERENCE DRAWINGS

30\EV\1040 - 1043	30\EV\1039	30\EV\1045
-------------------	------------	------------

SCALE

NTS

FIMISTON PLANT CARBON IN LEACH (C.I.L. 3) SUB STATION No.68 MCC 30-SW-64 SINGLE LINE DIAGRAM SHEET 1

KALGOORLIE CONSOLIDATED GOLD MINES PTY. LTD. ACN 009 377 619