


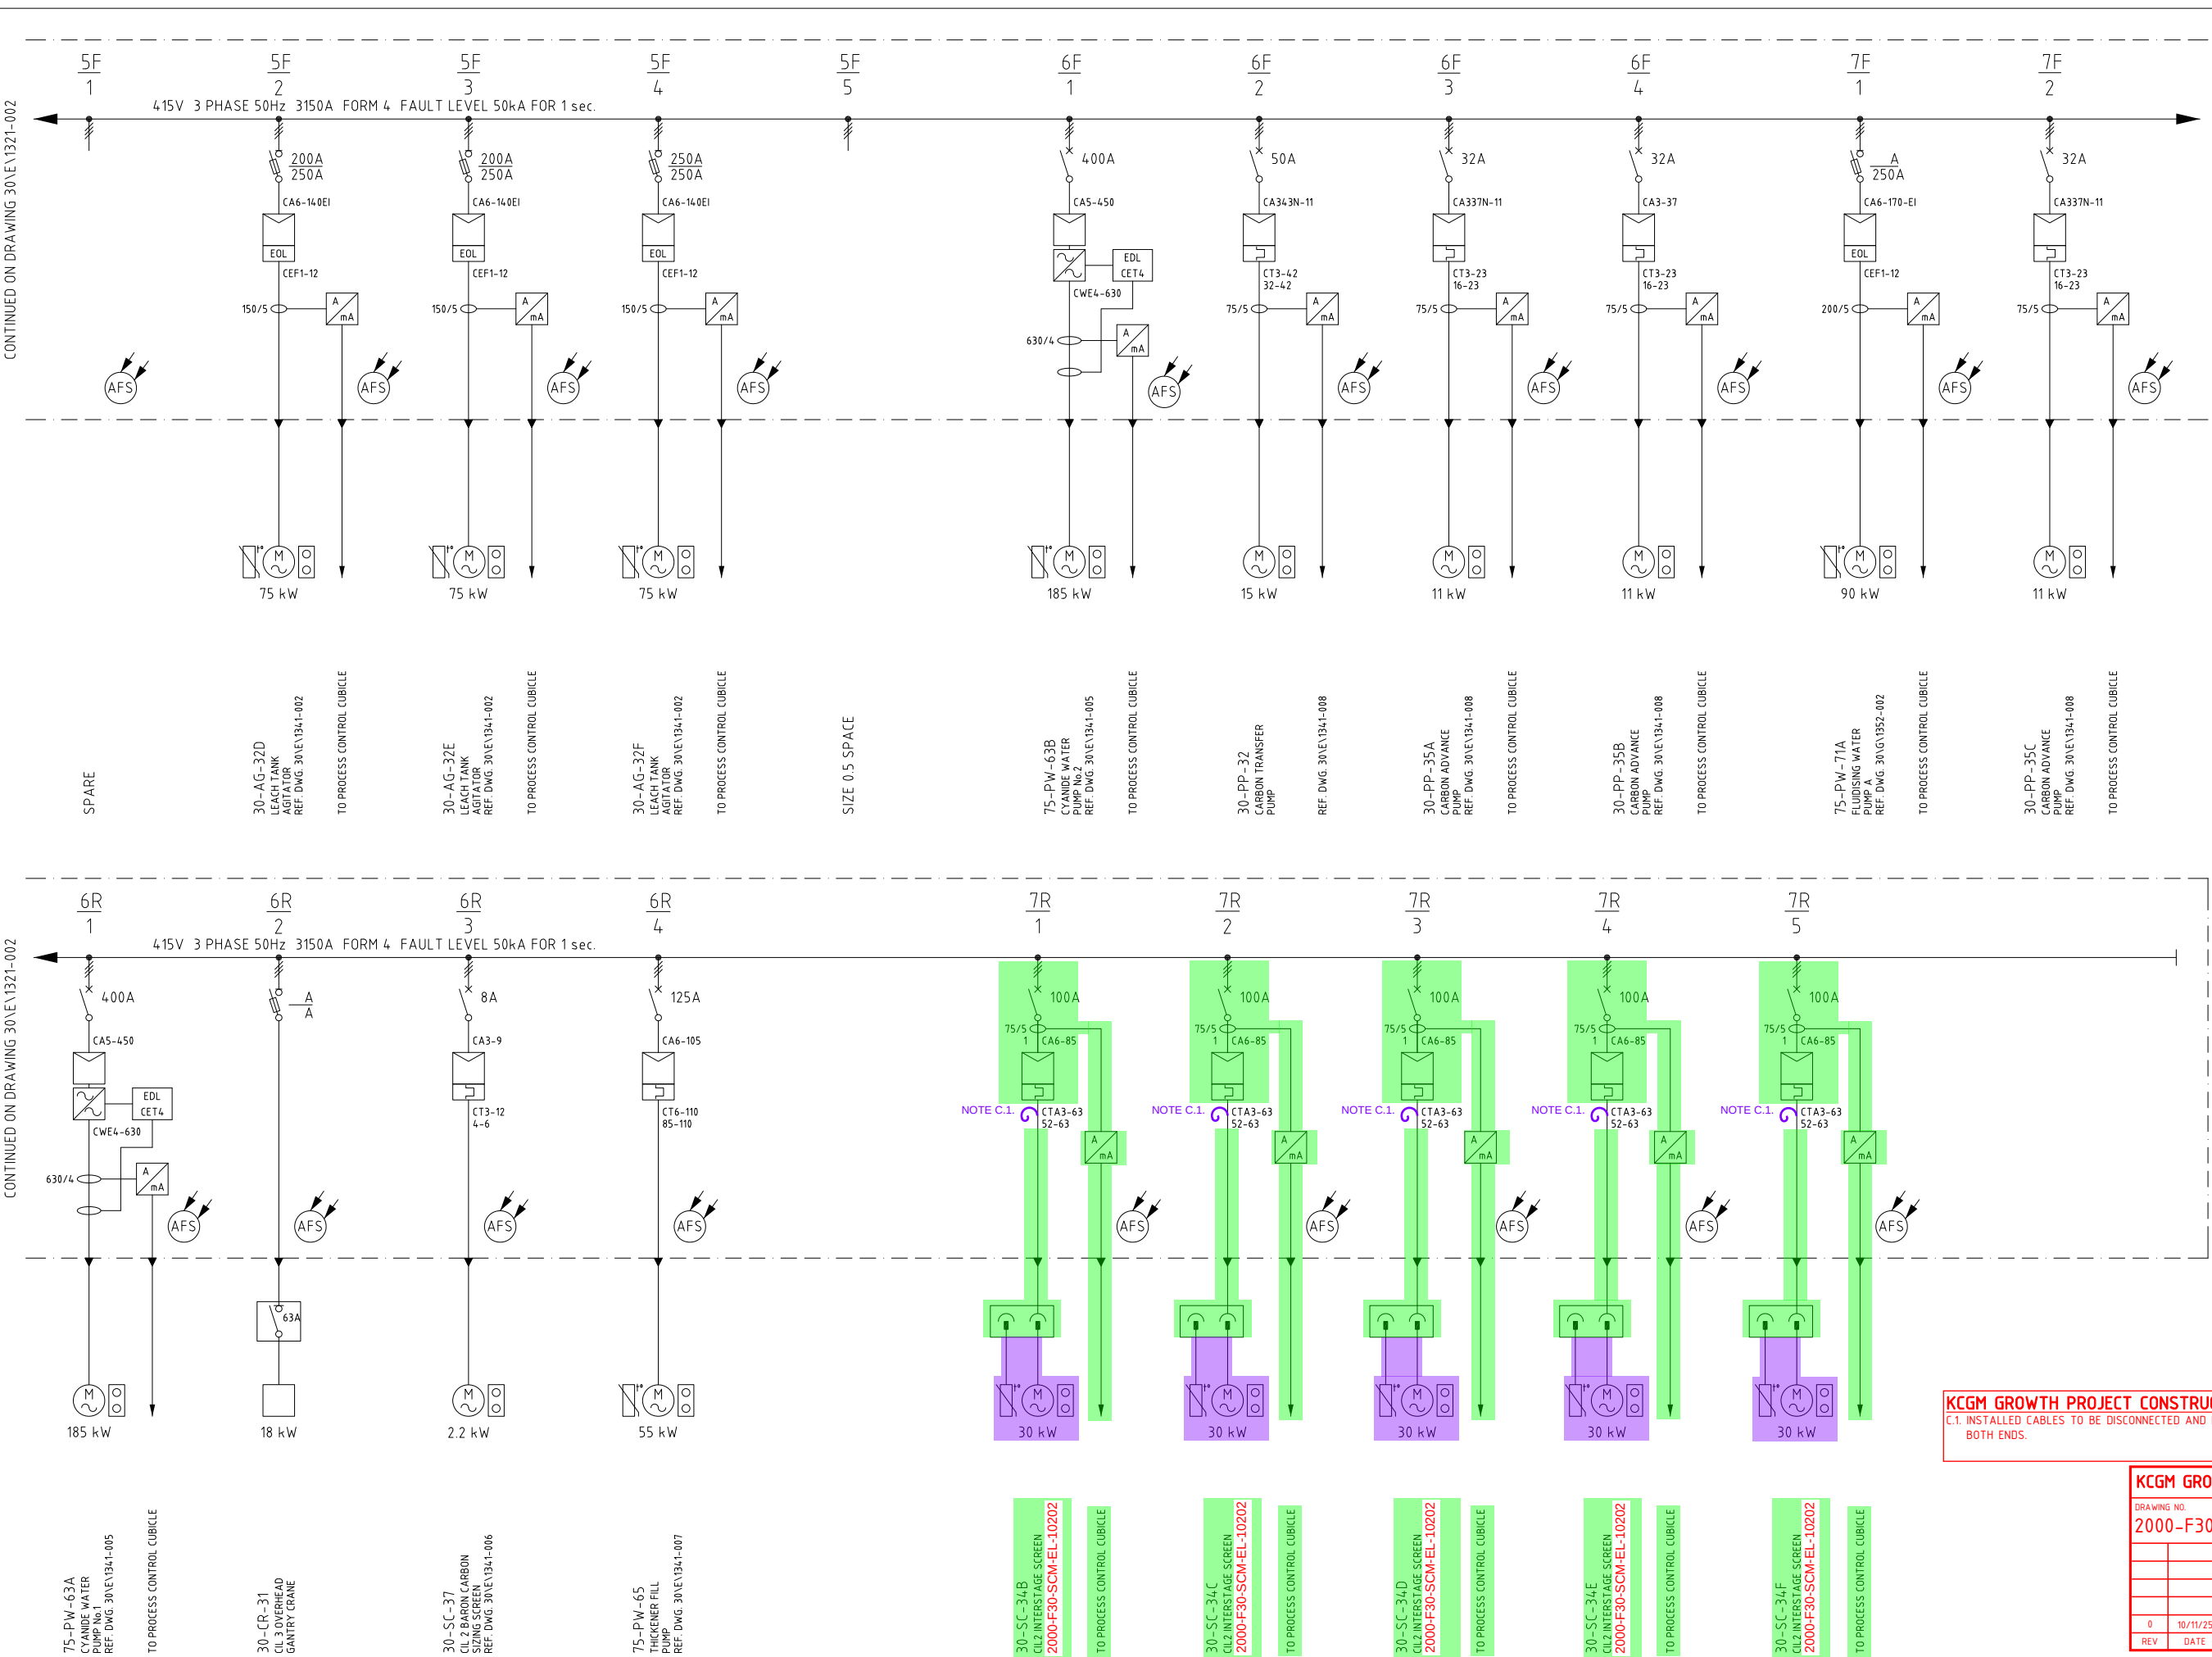

LEGEND

Approved☒

Approved as Noted☐

Not Approved☐

For Information Only☐

Signed **C Laird** Date **20/11/2025**

ACCEPTANCE DOES NOT RELIEVE THE SUPPLIER / CONTRACTOR OF ITS RESPONSIBILITY OR LIABILITIES UNDER THE PURCHASE ORDER / CONTRACT

LOCATION

SUB STATION 38  
30-SW-31

REAR

FRONT

- NOTES
1. WHERE DRIVES & FEEDERS REQUIRE 2 OFF CIRCUIT BREAKER AUXILIARIES THEN AN ADDITIONAL POLE SPACE IS REQUIRED.  
No. OF POLES USED SHOWN IN BRACKETS.

2. FUSES TO BE RATED FOR TYPE 2 SHORT CIRCUIT CO-ORDINATION.

3. ALL AFS (ARC FLASH SENSORS) ARE CONNECTED TO THE ARC FLASH RELAY VIA I/O UNITS.
- LEGEND

EXISTING

NON-EXISTENT

STAGE 1 - NEW

STAGE 1 - REMOVE

STAGE 1 - DECOMMISSIONED (OTHERS)

STAGE 2 - NEW

STAGE 2 - REMOVE

STAGE 2 - DECOMMISSIONED (OTHERS)

KCGM GROWTH PROJECT CONSTRUCTION NOTES

C.1. INSTALLED CABLES TO BE DISCONNECTED AND MADE SAFE AT BOTH ENDS.

KCGM GROWTH PROJECT

DRAWING NO.  
2000-F30-SLD-EL-10201

|     |          |                           |       |          |
|-----|----------|---------------------------|-------|----------|
| 0   | 10/11/25 | APPROVED FOR CONSTRUCTION |       | DM       |
| REV | DATE     | DESCRIPTION               | CHECK | TECH APP |

|    |          |----|----------|------------------------------------------------------|--|--|---|----------|---------------------------------------------------|-----|-----|-----|------|----------|----------|----------|----------|----------------------------------------------------------------------------------------------------------|------------|---------------------------------|-----------|
|    |          |                                                      |  |  | 6 | 24/07/18 | ARC FLASH SENSORS INSTALLED                       | RH  | JMR | JMR |      |          | SCALE    | NTS      |          | FIMISTON PLANT<br>LEACH ADSORPTION & THICKENING<br>SUBSTATION No. 38 MCC 30-SW-31<br>SINGLE LINE DIAGRAM | SIZE<br>A1 | DRAWING NUMBER<br>30\E\1321-003 | REV<br>7A |
|    |          |                                                      |  |  | 5 | 29/12/04 | 75-PW-72A DETAILS ADDED                           |     |     |     |      | DRAWN    |          | 01/09/01 |          |                                                                                                          |            |                                 |           |
|    |          |                                                      |  |  | 4 | 07/04/04 | GRAVITY CCT PROJECT - ISSUED FOR CONSTRUCTION     |     | DBG |     |      | DESIGNED | KCGM     | 01/09/01 |          |                                                                                                          |            |                                 |           |
|    |          |                                                      |  |  | 3 | 17/03/04 | GRAVITY CCT PROJECT - ISSUED FOR MCC CONSTRUCTION |     | DBG |     |      | CHECKED  | KCGM     | 01/09/01 |          |                                                                                                          |            |                                 |           |
|    |          |                                                      |  |  | 2 | 03/03/04 | ISSUED FOR TENDER                                 |     | MGM |     |      | APPROVED | KCGM     | 01/09/01 |          |                                                                                                          |            |                                 |           |
| 7A | 22/08/19 | 2019 S.L.D. UPDATE PROJECT "AS BUILT" - FIELD REVIEW |  |  |   |          |                                                   |     |     |     |      |          | PROJ.APP | KCGM     | 01/09/01 | KALGOORLIE CONSOLIDATED GOLD MINES PTY. LTD. ABN 009 377 619 003                                         |            |                                 |           |
| MK | DATE     | REVISION                                             |  |  |   |          | BY                                                | CKD | APP | MK  | DATE | REVISION | BY       | CKD      | APP      | REFERENCE DRAWINGS                                                                                       | DWG NO.    | PROJ. FILE #                    |           |