


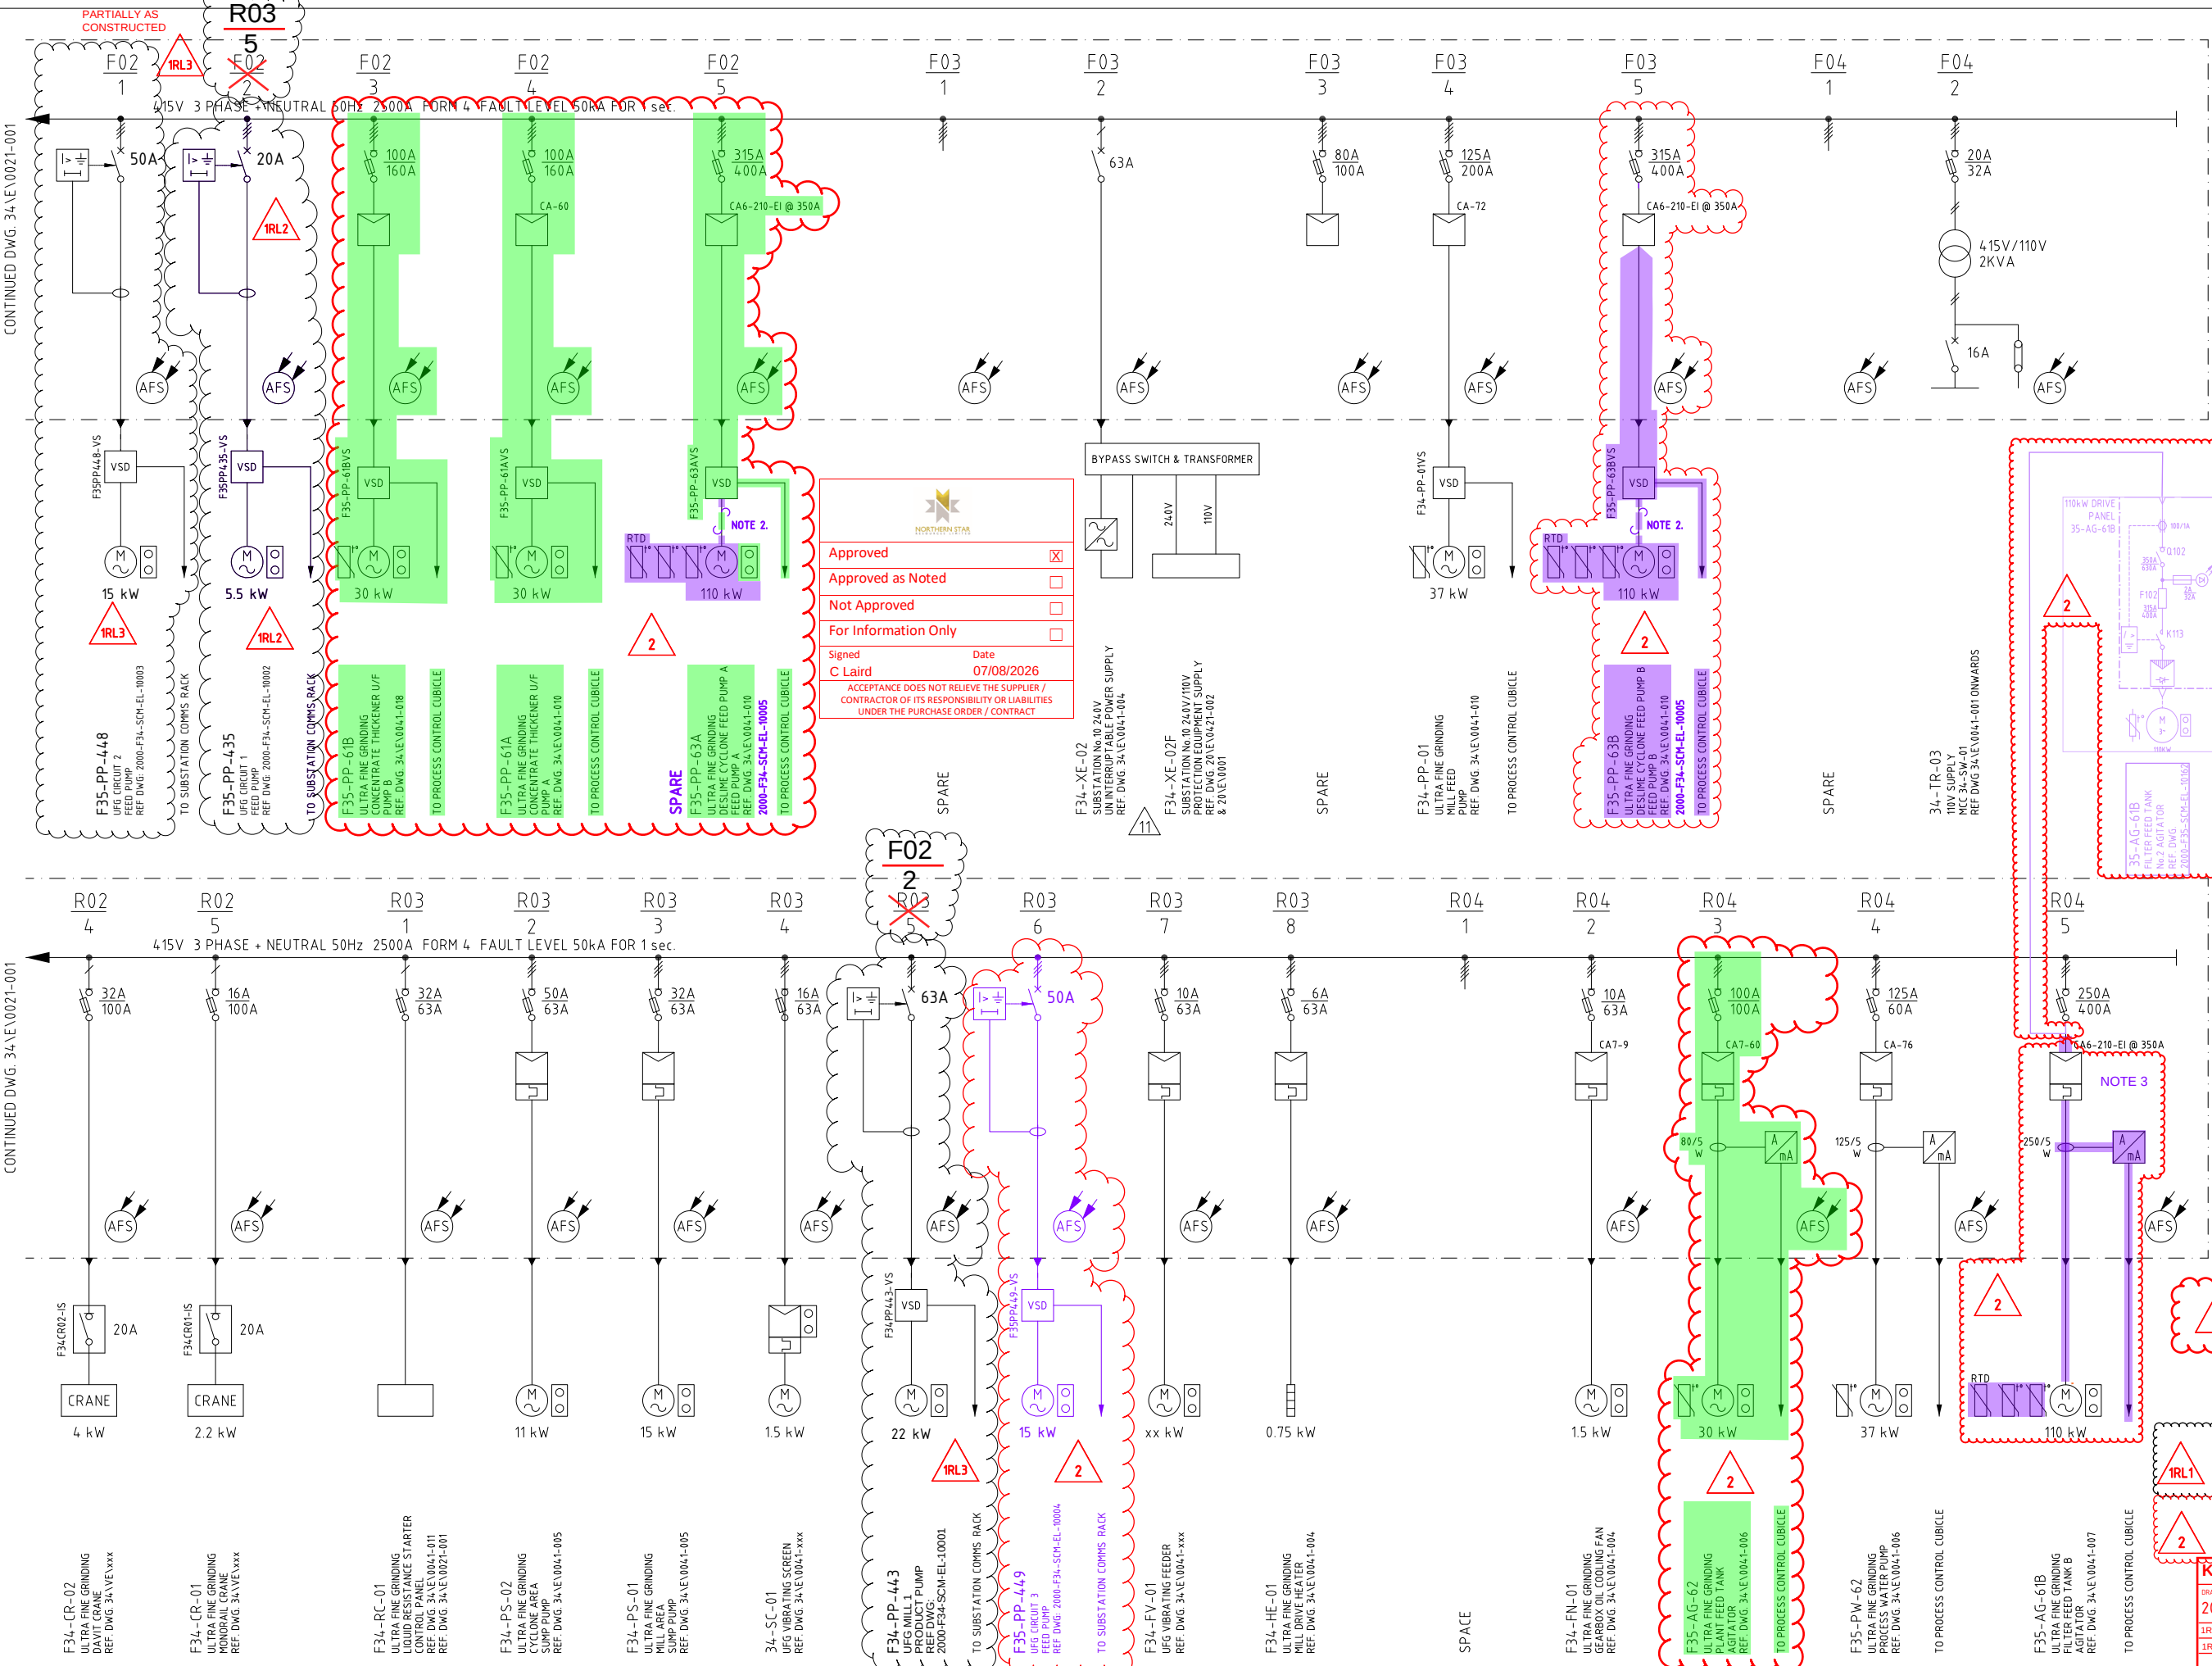

LEGEND

COMBINED FUSE SWITCH

CONTACTOR

OVERLOAD

VARIABLE SPEED DRIVE

RTD

THERMISTOR

LOCAL CONTROL STATION

MOTOR

BUCHHOLZ PROTECTION

POWER QUALITY METER

LINK

FUSE

UPS

OVERCURRENT RELAY WITH TIME LAG

INSTANTANEOUS EARTH CURRENT RELAY

AMP SIGNAL CONVERTOR

GPO

HEATER

CONTROL TRANSFORMER

TRANSFORMER

WITHDRAWABLE BREAKER HEATER

DISTRIBUTION BOARD

LEGEND

— STAGE 1 - NEW

— STAGE 1 - REMOVE

— STAGE 1 - DECOMMISSIONED (OTHERS)

— STAGE 2 - NEW

— STAGE 2 - REMOVE

— STAGE 2 - DECOMMISSIONED (OTHERS)

NOTES

1. ALL AFS (ARC FLASH SENSORS) ARE CONNECTED TO THE ARC FLASH RELAY VIA I/O UNITS.

2. VSD OUTGOING FIELD CABLES DISCONNECTED AND MADE SAFE AT BOTH ENDS.

3. BUCKET R04/S EQUIPMENT IS NOT TO BE MODIFIED. BYPASS THE CONTACTOR ONLY AND LEAVE INSITU. NEW CABLE TERMINATES TO LOAD SIDE OF EXISTING FUSED SWITCH.

KCGM GROWTH PROJECT

DRAWING NO.

2000-F34-SLD-EL-10102

1RL3

20/07/26

AS CONSTRUCTED FOR SP1

1RL2

04/06/26

AS CONSTRUCTED FOR F34.20.01

2

03/08/26

DESIGN CHANGE INFLUENCED BY SHUTDOWN PLANNING

REV

DATE

DESCRIPTION

CHECKED

A1

34-E\0021-002

11

7

09/01/18

AS BUILT

RH

JM

JM

1

15/11/01

HOLD #53 ADDED, OTHER MINOR REVISIONS

MGM

EM

SCALE

NTS

23/08/01

FIMSTON PLANT

6

15/02/07

34SC01 DETAILS ADDED.

0

11/10/01

ISSUED FOR CONSTRUCTION

EM

21/08/01

ULTRA FINE GRINDING

5

13/05/04

PUMP 35-PP-64 MOVED FROM 34-SW-62, PANEL 1F

11

11/05/20

ISSUED FOR CONSTRUCTION - F34XE02

AA

DESIGNED

4

15/05/02

"AS BUILT"

IGC

10

14/09/20

2019 S.L.D. UPDATE PROJECT "AS BUILT"

RA

CHECKED

3

05/02/02

DRIVES 34-PW-01A, 01B, 01C ADDED

IGC

9A

26/08/19

2019 S.L.D. UPDATE PROJECT "AS BUILT" - FIELD REVIEW

RH

APPROVED

2

05/02/02

"AS BUILT" AS PER KOUNIS DRAWINGS

AB

8

08/06/18

ARC FLASH SENSOR INSTALLED

JMR

PROJ APP

MK

DATE

REVISION

BY

CKD

APP

MK

DATE

REVISION

BY

CKD

APP

REFERENCE DRAWINGS

DWG NO.

PROJ FILE #

KALGOORLIE CONSOLIDATED GOLD MINES PTY. LTD.

ABN 009 377 619 003