


D:\CAD PROJECTS\235 NORTHERN STAR RESOURCES LTD\23517 KCGM GROWTH PROJECT\03 DELIVERABLES\PR-PFD\AS BUILT\2000-F00-PFD-PR-10029.DWG 07SEP26 3:24PM ANTHONY VANDORNUM



| DRG No.               | REFERENCES                                          | REV               | DATE | DESCRIPTION | DRAW | CHECK | DESIGN | TECH APP | PROJ APP |
|-----------------------|-----------------------------------------------------|-------------------|------|-------------|------|-------|--------|----------|----------|
| 2000-F00-PID-PR-10007 | LEGEND SHEET 7 - PIPING AND INSTRUMENTATION DIAGRAM |                   |      |             |      |       |        |          |          |
| 2000-F00-PID-PR-10006 | LEGEND SHEET 6 - PIPING AND INSTRUMENTATION DIAGRAM |                   |      |             |      |       |        |          |          |
| 2000-F00-PID-PR-10005 | LEGEND SHEET 5 - PIPING AND INSTRUMENTATION DIAGRAM |                   |      |             |      |       |        |          |          |
| 2000-F00-PID-PR-10004 | LEGEND SHEET 4 - PIPING AND INSTRUMENTATION DIAGRAM |                   |      |             |      |       |        |          |          |
| 2000-F00-PID-PR-10003 | LEGEND SHEET 3 - PIPING AND INSTRUMENTATION DIAGRAM |                   |      |             |      |       |        |          |          |
| 2000-F00-PID-PR-10002 | LEGEND SHEET 2 - PIPING AND INSTRUMENTATION DIAGRAM |                   |      |             |      |       |        |          |          |
| 2000-F00-PID-PR-10001 | LEGEND SHEET 1 - PIPING AND INSTRUMENTATION DIAGRAM |                   |      |             |      |       |        |          |          |
| 1                     | 04SEP26                                             | SP1 AS BUILT      |      |             |      |       |        |          |          |
| 0                     | 10APR25                                             | ISSUED FOR DESIGN |      |             |      |       |        |          |          |

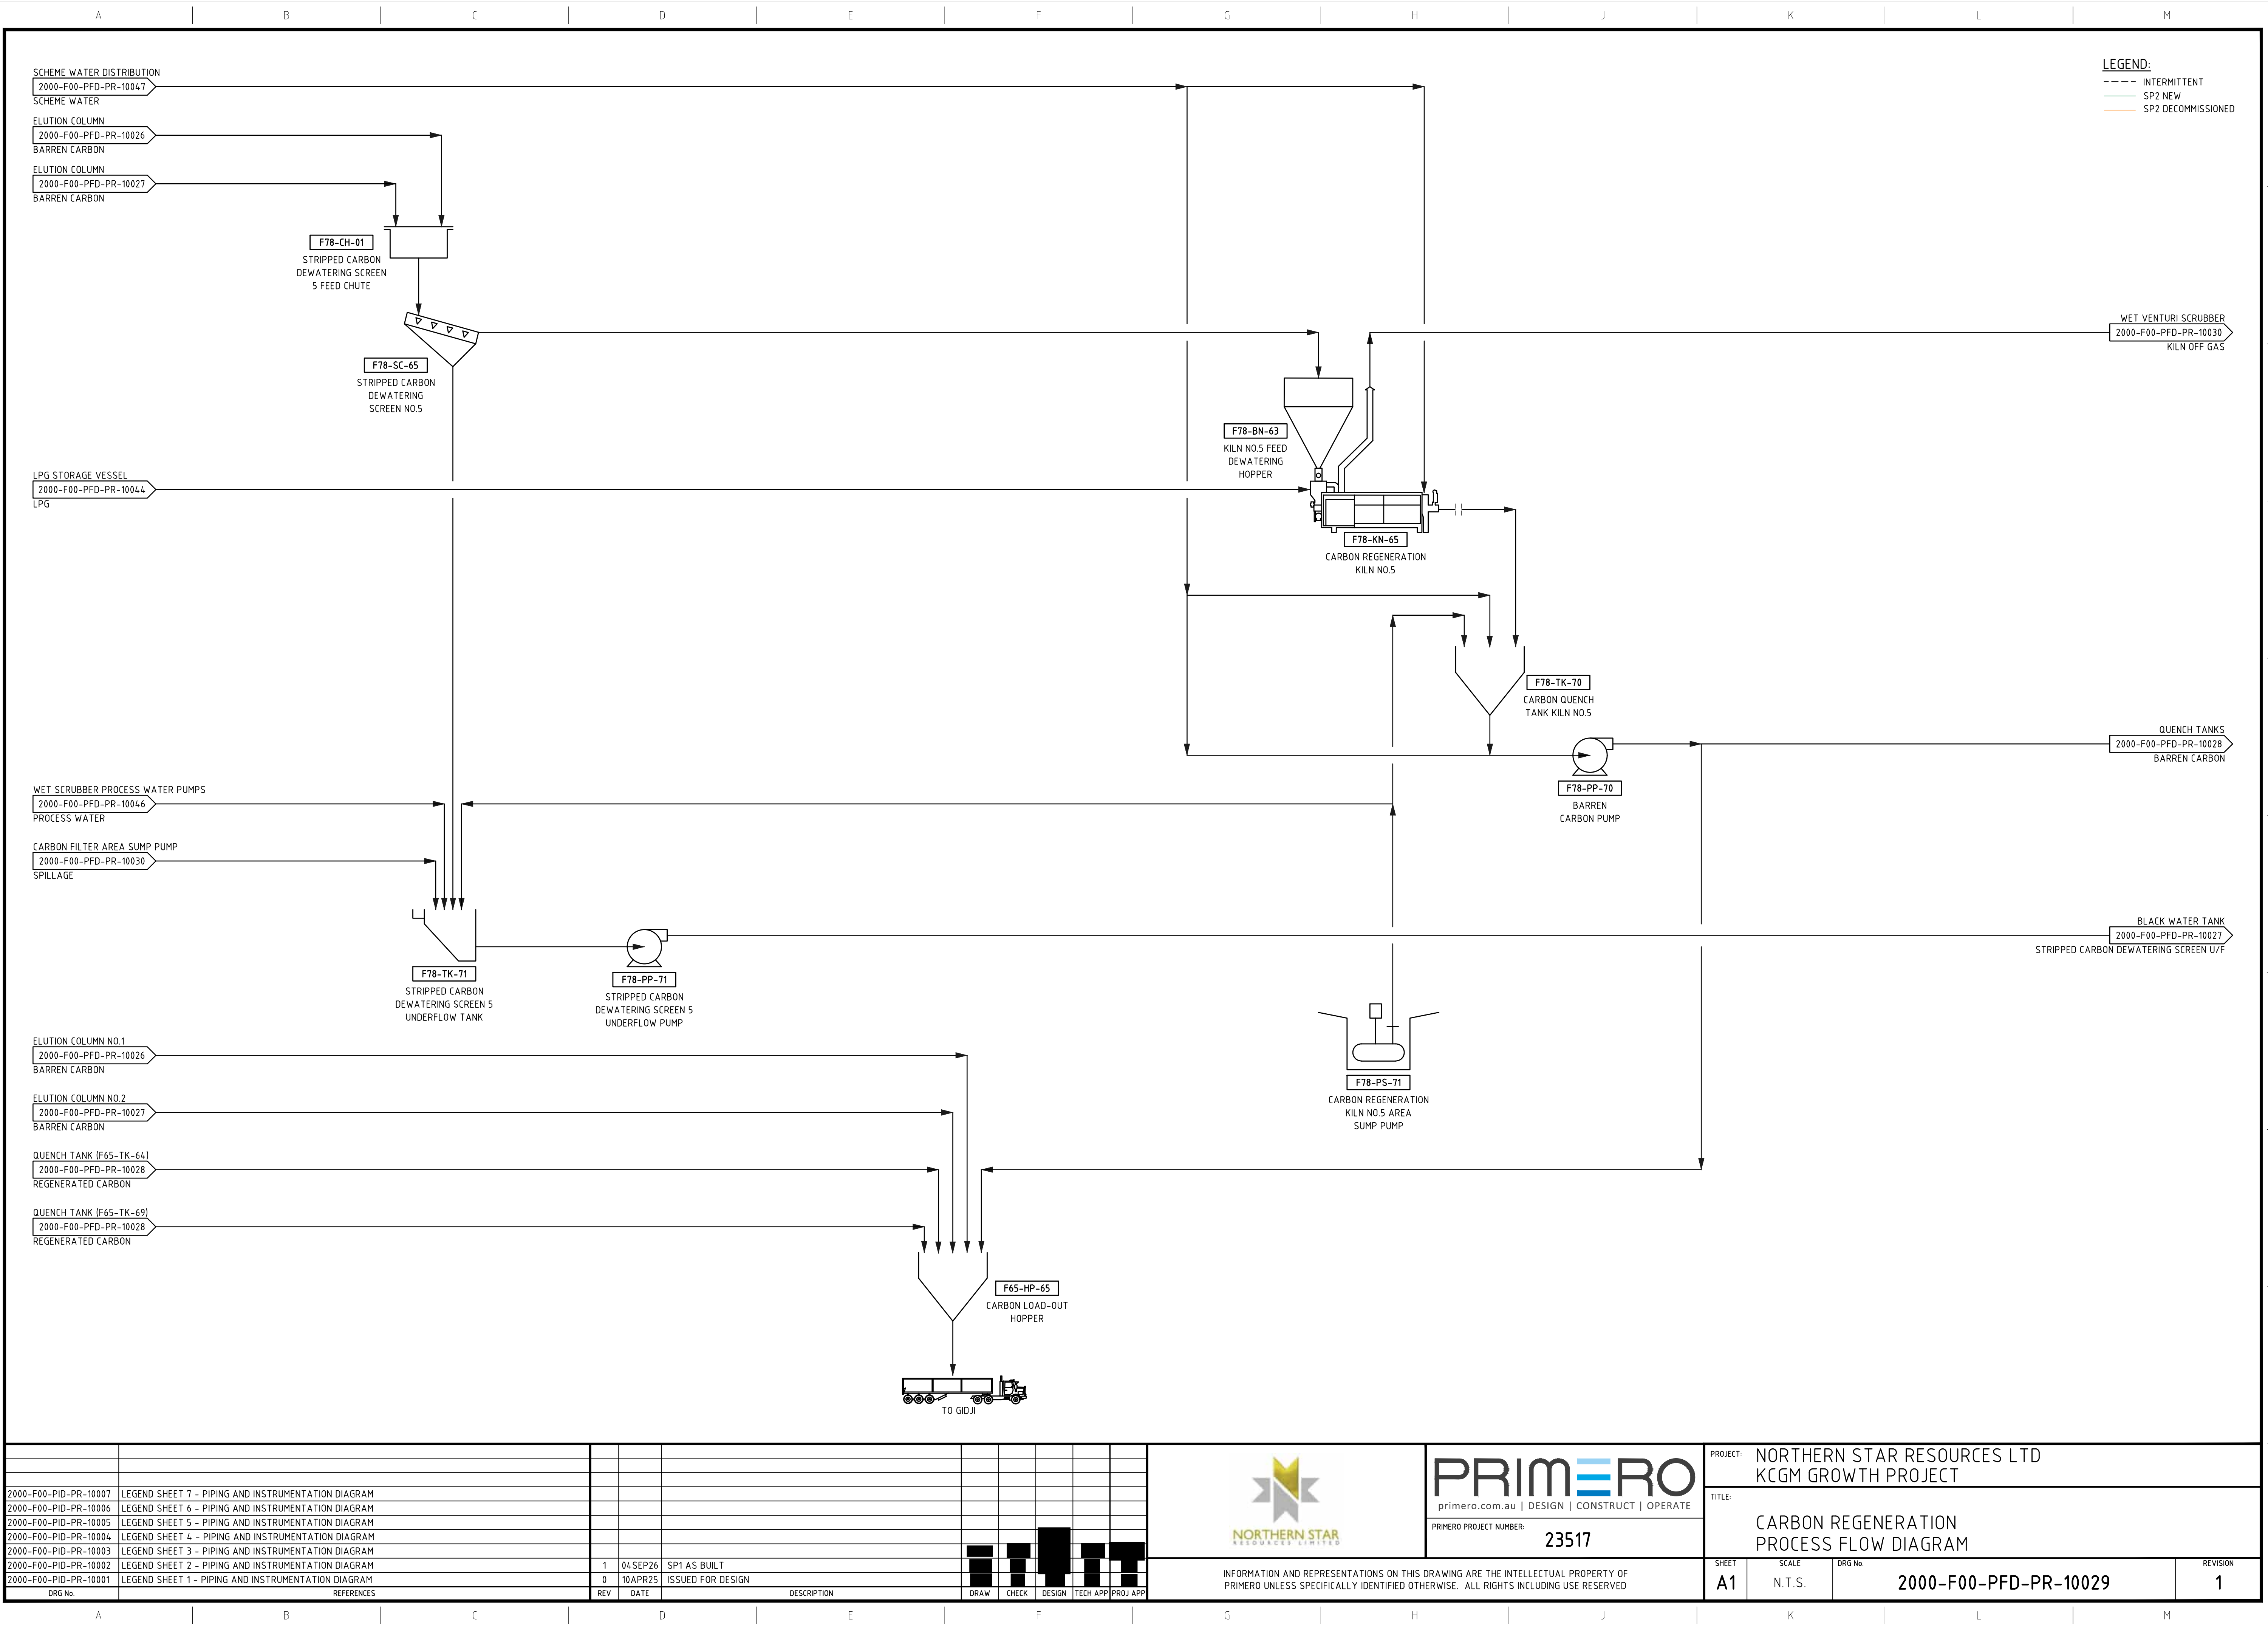

INFORMATION AND REPRESENTATIONS ON THIS DRAWING ARE THE INTELLECTUAL PROPERTY OF PRIMERO UNLESS SPECIFICALLY IDENTIFIED OTHERWISE. ALL RIGHTS INCLUDING USE RESERVED

|          |                                                    |                       |          |
|----------|----------------------------------------------------|-----------------------|----------|
| PROJECT: | NORTHERN STAR RESOURCES LTD<br>KCGM GROWTH PROJECT |                       |          |
| TITLE:   | CARBON REGENERATION<br>PROCESS FLOW DIAGRAM        |                       |          |
| SHEET    | SCALE                                              | DRG No.               | REVISION |
| A1       | N.T.S.                                             | 2000-F00-PFD-PR-10029 | 1        |