


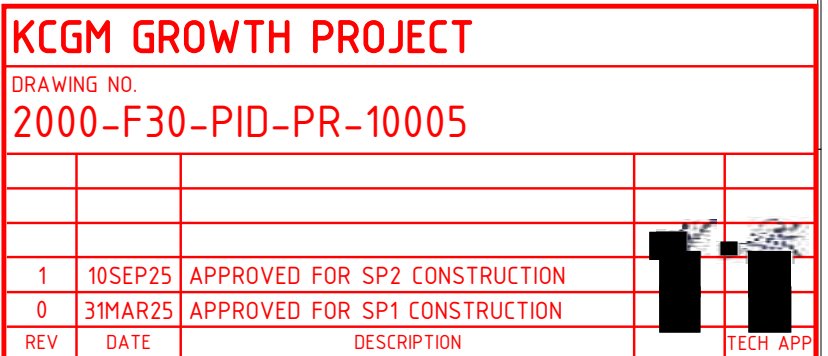

COPYRIGHT ©

This drawing remains the property of MINPROC ENGINEERS PTY. LTD. and may not be copied in any way without prior written approval from this company.

		3	FW	03.09.91	AS BUILT
		2	EAC	13.05.91	REVISED AS NOTED
		1		08.04.91	LINES 363&5-1A,316/7-FS, 318/9-FD ADDED.SPEC X'S W
		0		26.03.91	ISSUED FOR CONSTRUCTION
		B		15.02.91	ISSUED FOR TENDER
		A		10.12.90	ISSUED FOR APPROVAL
CHECKED		No.	BY		

	12/3/91	
	12/3/91	
	12/3/91	
	11/90	PLANT GRID NORTH

MINES		SIZE	SCALE									
		B1	N.T.S.									
997 M	REV.	A	B	C	D	E	F	G	H			
	No.	1	2	3	4	5	6	7	8			
DRAWING No.		FME-30-PI-0313										