


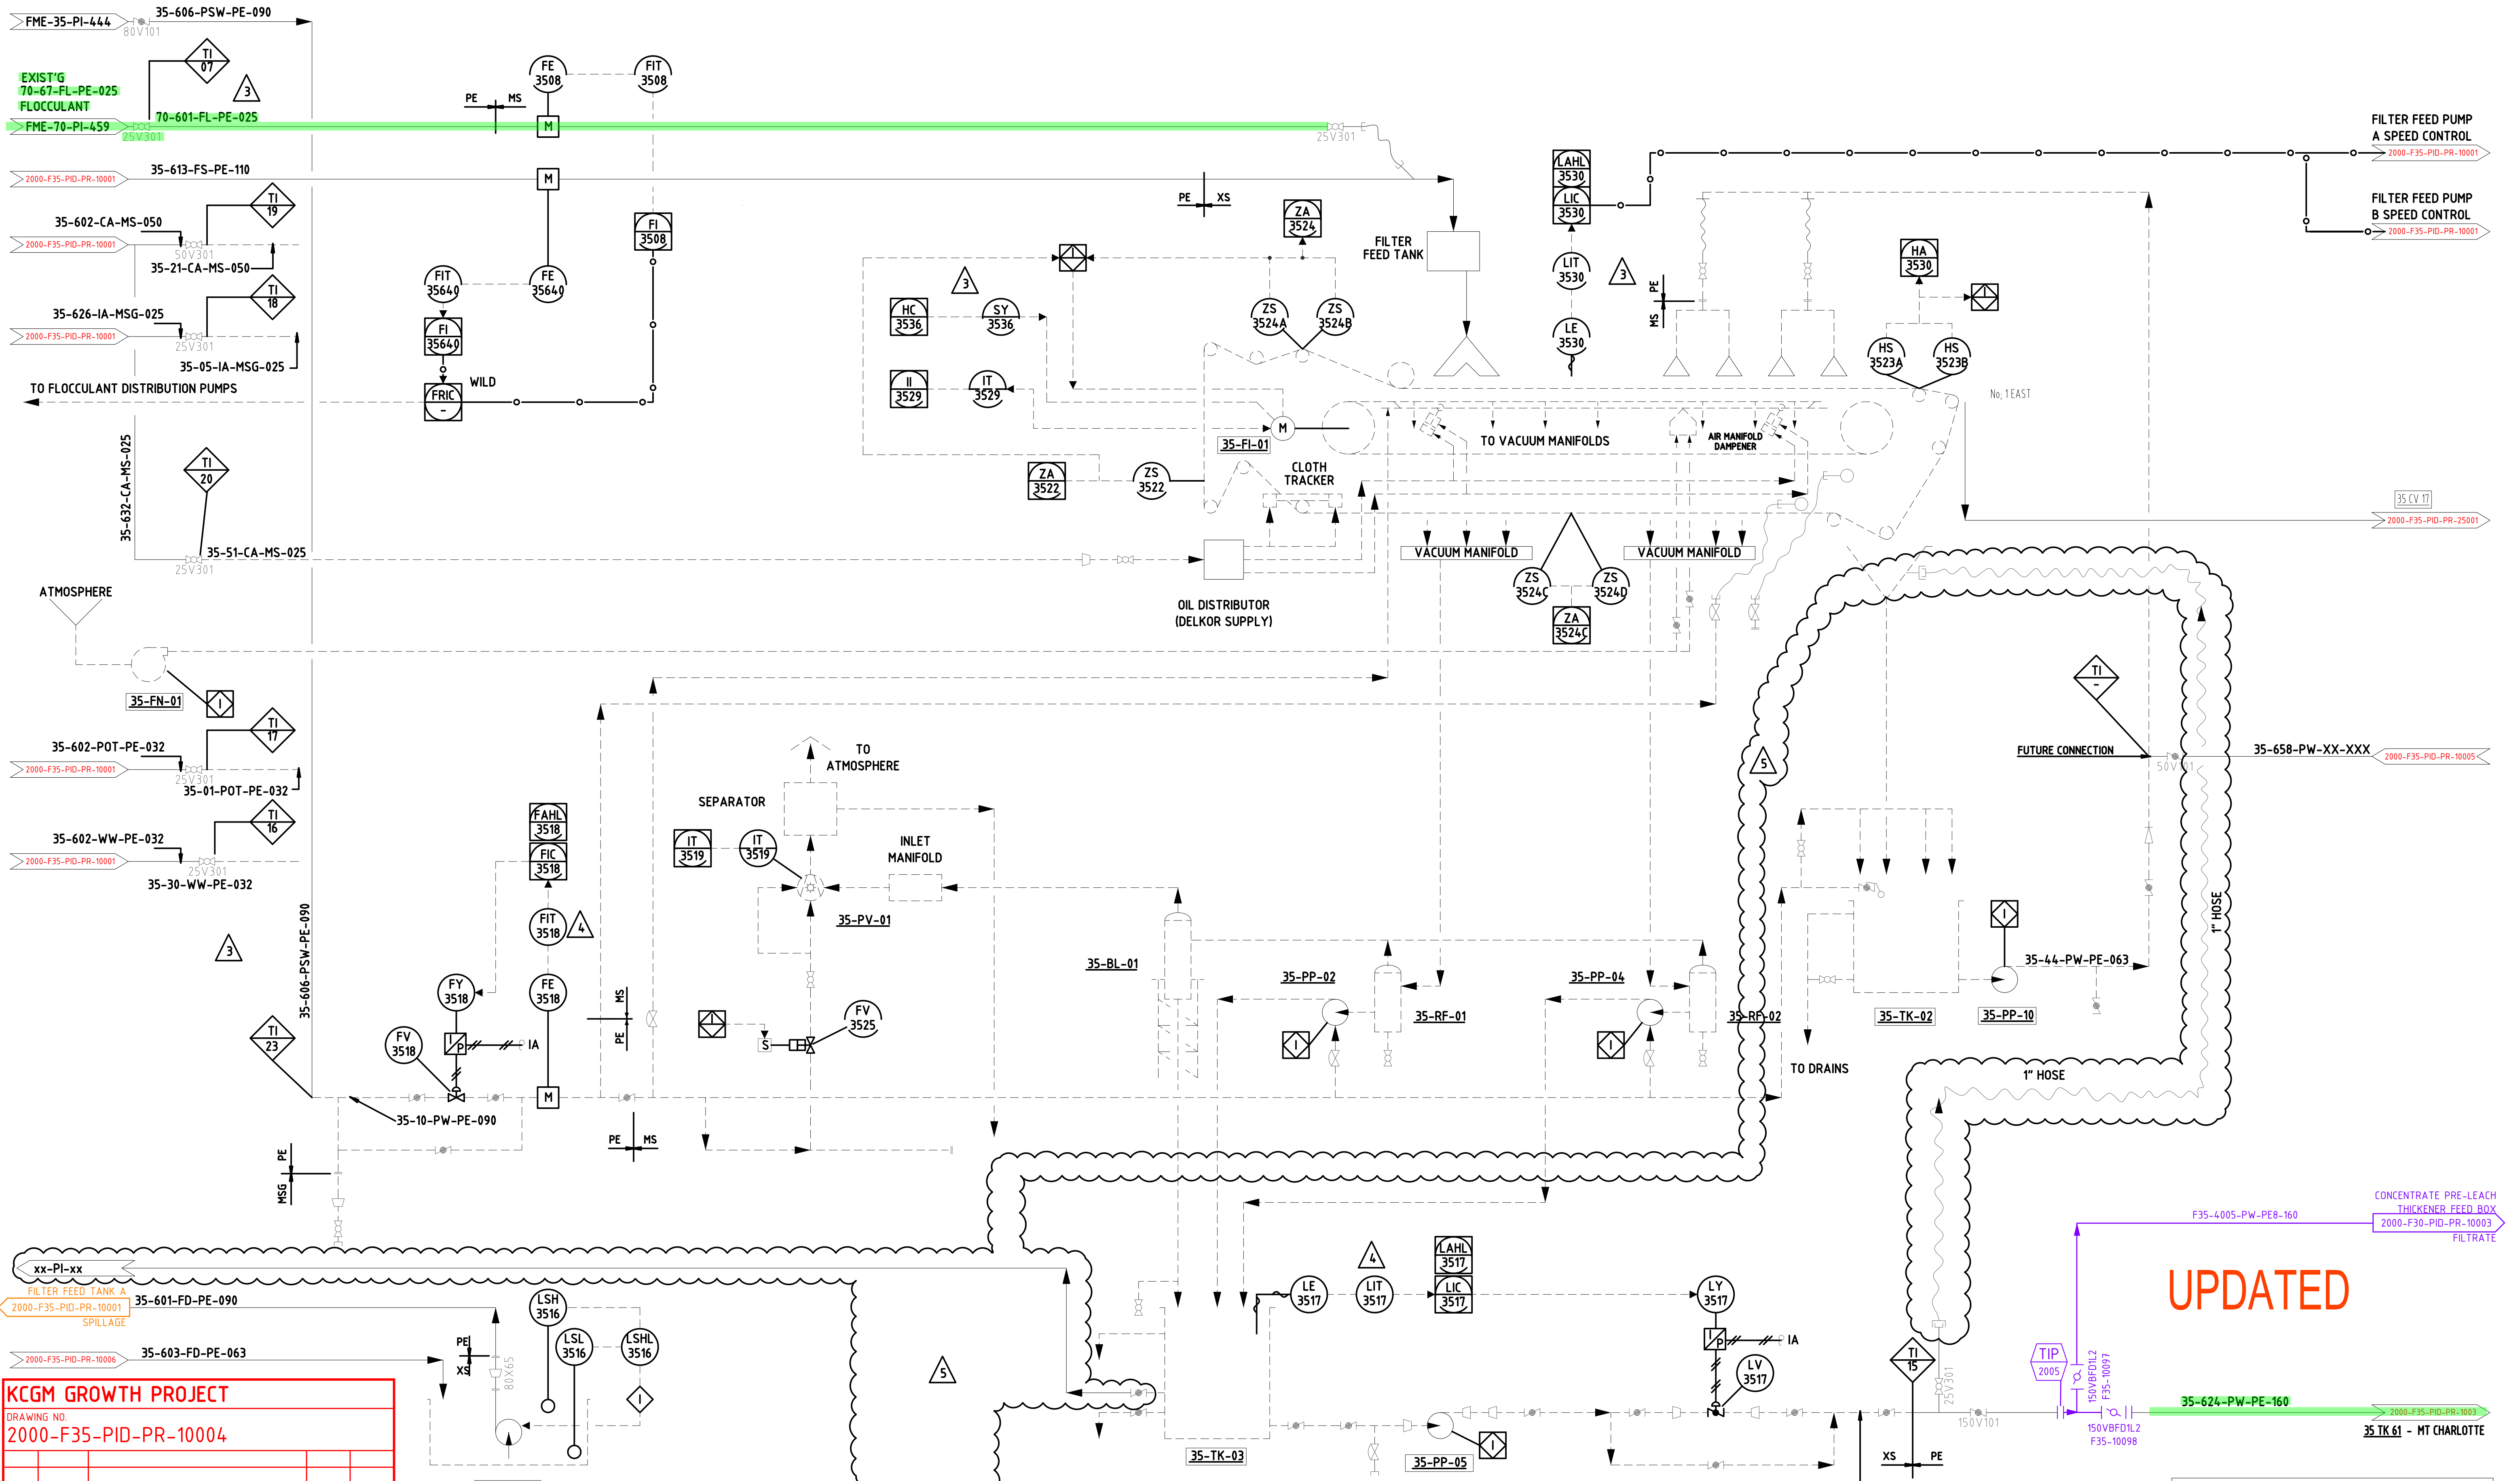

KCGM GROWTH PROJECT				
DRAWING NO. 2000-F35-PID-PR-10004				
REV	DATE	DESCRIPTION	CHECK	TECH APP
1	4SEP25	UPDATED 35-PS61A DISCHARGE		
0	25JUN25	APPROVED FOR CONSTRUCTION		

35-FN-01 FILTER BLOWBACK FAN
35-PS-61A FILTER WASHDOWN PUMP No. 1

35-FI-01 CONCENTRATES FILTER No. 1 - EAST
35-BL-01 BAROMETRIC LEG
35-PP-02 FILTER No. 1 FILTRATE PUMP No. 1
35-RF-01 FILTER No. 1 FILTRATE RECEIVER No.1

35-TK-03 FILTER No 1 FINAL FILTRATE TANK
35-PP-05 FILTER No 1 FINAL CONCENTRATE

35-TK-02 FILTER No 1 CLOTH WASH TANK
35-PP-10 FILTER No 1 WASH PUMP
35-PP-04 FILTER No. 1 FILTRATE PUMP No. 2
35-RF-02 FILTER No. 1 FILTRATE RECEIVER No.2

NOTE- THIS DRAWING TO BE READ IN CONJUNCTION WITH DRG. No. 2000-F35-PID-PR-10006

LEGEND
EXISTING
NON-EXISTENT
STAGE 1 - NEW
STAGE 1 - REMOVE
STAGE 1 - DECOMMISSIONED (OTHERS)
STAGE 2 - NEW
STAGE 2 - REMOVE
STAGE 2 - DECOMMISSIONED (OTHERS)

DRAWING No.	REFERENCE DRAWINGS
9241-00-PI-27	INSTRUMENT AIR DISTRIBUTION
9241-00-PI-26	COMPRESSOR AIR DISTRIBUTION
9241-00-PI-25	POTABLE WATER DISTRIBUTION
9241-00-PI-24	SCHEME WATER DISTRIBUTION
9241-00-PI-23	WASHDOWN WATER DISTRIBUTION

COPYRIGHT ©
This drawing remains the property of MINPROC ENGINEERS LIMITED and may not be copied in any way without prior written approval from this company.

MINPROC ENGINEERS LIMITED
A.C.N. 008 992 694
22, STIRLING HIGHWAY, NEDLANDS WA 6009
PHONE (09) 347 4777

No.	BY	DATE	REVISION	CHECKED
5	L.W.	30.04.2020	TK & REM'D, REVISED - 'AS BUILT'	
4		30/11/94	REVISED AS NOTED SEE DWG SP-410	
3		8/11/94	REVISED AS NOTED SEE DWG SP-410	
2		31/10/94	APPROVED FOR CONSTRUCTION	
1		25/10/94	ISSUED FOR MAT'L TAKE-OFF	
0		12/08/94	APPROVED FOR TENDER	

CLIENT	KALGOORLIE CONSOLIDATED GOLD MINES
TITLE	FIMISTON EXPANSION 1994/95 PIPING & INSTRUMENTATION DIAGRAM CONCENTRATE FILTER No1

SIZE	B1
SCALE	N.T.S.
REV. No.	1 2 3 4 5
DRAWING No.	FME-35-PI-445