


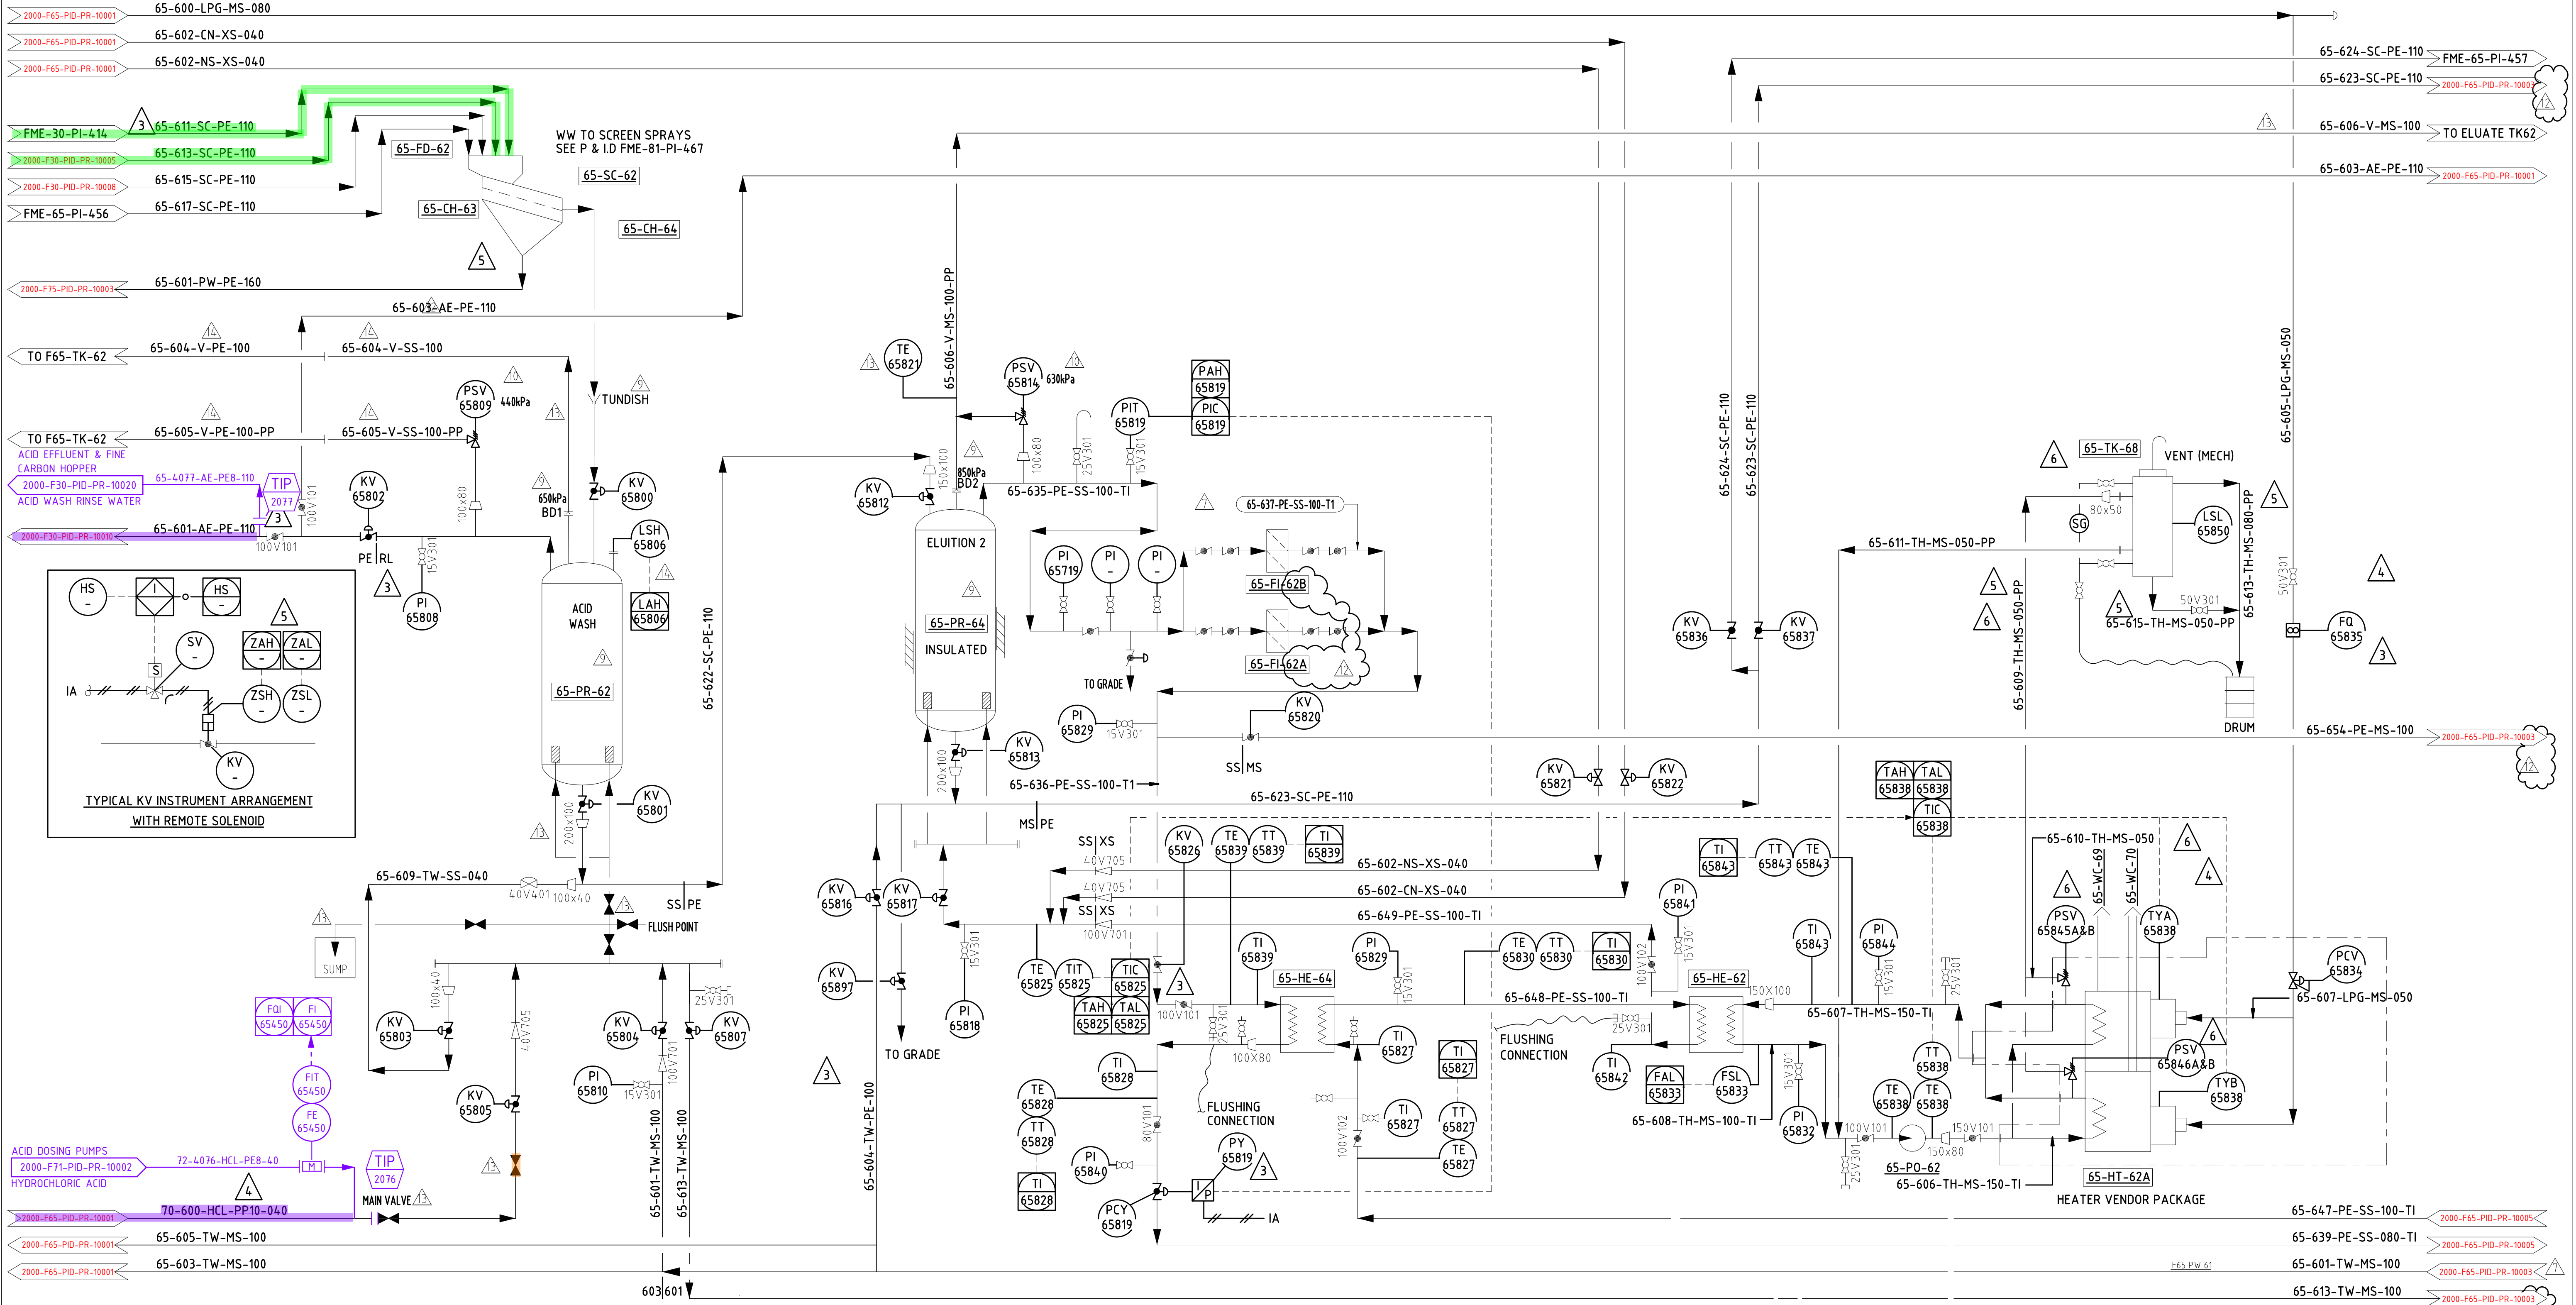

LEGEND

- EXISTING
- NON-EXISTENT
- STAGE 1 - NEW
- STAGE 1 - REMOVE
- STAGE 1 - DECOMMISSIONED (OTHERS)
- STAGE 2 - NEW
- STAGE 2 - REMOVE
- STAGE 2 - DECOMMISSIONED (OTHERS)

NOTE: FOR "WW" "CA" & "IA" REFER DRAWING No: 81\PI\0467

KCGM GROWTH PROJECT

DRAWING No: 2000-F65-PID-PR-10002

REV	DATE	DESCRIPTION
1	14/03/22	GENERAL UPDATE
2	02.04.2020	GENERAL REVISION
3	28/06/17	BURST DISK PRESSURE MODIFIED/ ADDED
4	26/05/17	TUNISH & BURST DISK PRESSURE ADDED
5	29/07/05	AS BUILT MARK-UPS
6	11/10/99	REF 65-PI-458 WAS 456

65-FD-62 CARBON RINSE SCREEN No. 2 FEED BOX

65-SC-62 CARBON RINSE SCREEN No. 2

65-CH-63 CARBON RINSE SCREEN No. 2 UNDERFLOW CHUTE

65-PR-64 ELUTION COLUMN No. 2

65-CH-64 CARBON RINSE SCREEN No. 2 OVERFLOW CHUTE

65-PR-62 ACID WASH COLUMN No. 2

65-FI-62 A & B ELUATE FILTER

65-HE-63 HEAT RECOVERY HEAT EXCHANGER No. 1

65-HE-64 HEAT RECOVERY HEAT EXCHANGER No. 2

65-HE-62 PRIMARY HEAT EXCHANGER No. 2

65-PO-62 HEATER No.2 OIL CIRCULATION PUMP

65-TK-68 HEATER OIL TANK

65-HT-62A ELUTION HEATER No. 3

65-HT-62B ELUTION HEATER No. 4

65-WC-69 ELUTION HEATER No. 2 STACK No.1

65-WC-70 ELUTION HEATER No. 2 STACK No.2

FME-00-SP-419 MISCELLANEOUS EQUIP. LIST CONTRACT #F037

FME-00-SP-415 MANUAL VALVE SCHEDULE

FME-00-SP-411 PIPING LINE LIST INDEX ELUTION CIRC/GOLD ROOM

FME-00-P-401 PIPING KEYPLAN

FME-00-SP-408 INSTRUMENT STANDARDS

FME-00-SP-404 STANDARD ABBREV. & VALVE SYMBOLS

FME-00-SP-403 STANDARD EQUIPMENT SYMBOLS

DRAWING No: REFERENCE DRAWINGS

COPYRIGHT ©

this drawing remains the property of MINPROC ENGINEERS LIMITED and may not be copied in any way without prior written approval from this company.

MINPROC ENGINEERS LIMITED

A.C.N. 008 992 694

22, STIRLING HIGHWAY, NEDLANDS WA 6009

PHONE (09) 347 4777

No.	BY	DATE	REVISION	CHECKED
14	AHA	17/08/22	GENERAL UPDATE	RC
13		14/03/22	LNES 65-604,605, 606 TO TK62/TE ADDED	RC
12		02.04.2020	GENERAL REVISION	RC
10	JB	28/06/17	BURST DISK PRESSURE MODIFIED/ ADDED	
9	JB	26/05/17	TUNISH & BURST DISK PRESSURE ADDED	
8	LW	29/07/05	AS BUILT MARK-UPS	SW
7	DKL	11/10/99	REF 65-PI-458 WAS 456	

No.	BY	DATE	REVISION	CHECKED
6	FW	28/06/95	REVISED AS NOTED	
5	PR	8/5/95	REVISED AS NOTED	
4		19/4/95	REVISED AS NOTED	
3		31/3/95	REVISED AS NOTED	
2		10/2/95	APPROVED FOR CONSTRUCTION	
1		27/1/95	RE-ISSUED FOR TENDER	
0	PGN	21/12/94	APPR. FOR TENDER - F037	

CLIENT: KALGOORLIE CONSOLIDATED GOLD MINES

TITLE: FIMISTON EXPANSION 1994/95 PIPING & INSTRUMENTATION DIAGRAM ACID WASH & ELUTION CIRCUIT No. 2

PLANT GRID NORTH

SIZE: B1

N.T.S.

REV. 1/1/2/3/4/5/6/7/8/9/10/11/12/13/14

DRAWING No: 65\PI\0450