


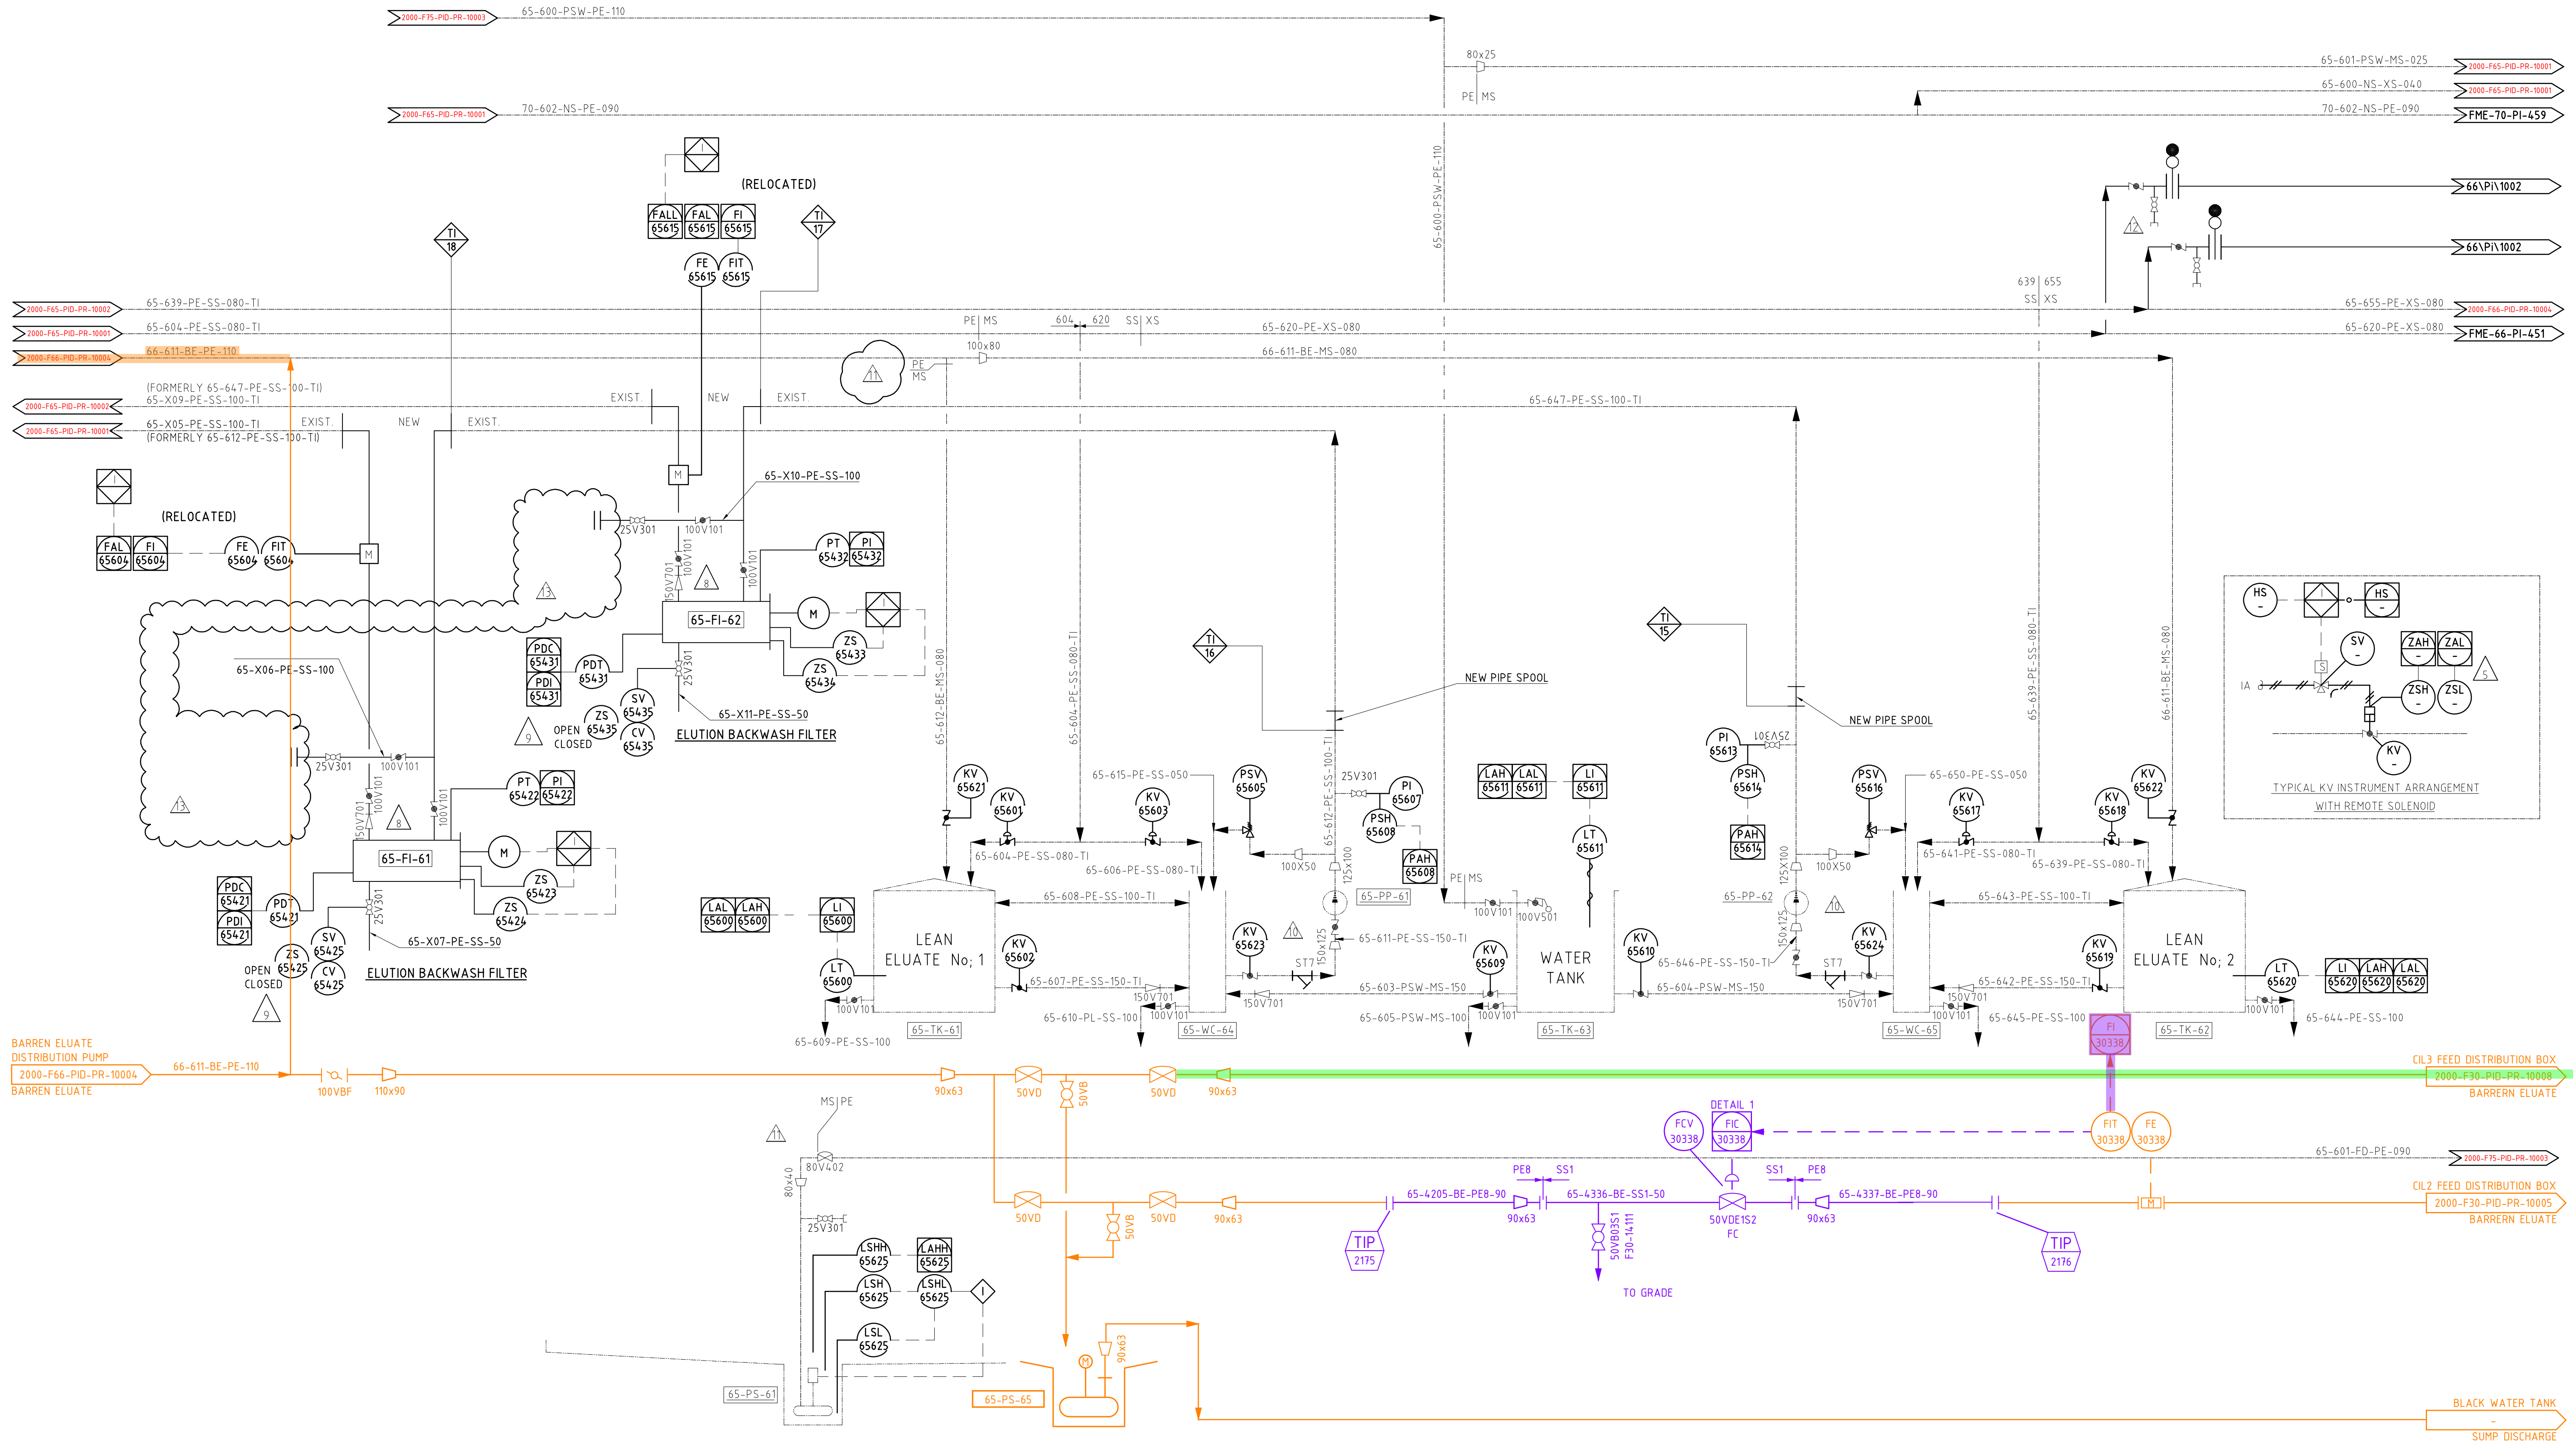

NOTES:

1. FOR "WW" "CA" & "IA" REFER FME-81-PI-0467

- 65-TK-61 LEAN ELUATE TANK No 1
65-PP-61 ELUTION CIRCUIT No 1 WATER PUMP
65-WC-64 ELUTION CIRCUIT No 1 RECYCLE STAND PIPE
65-PS-61 ELUTION AREA WASHDOWN PUMP
65-PS-65 CARBON TRANSFER AREA SUMP PUMP

- 65-FI-61 ELUTION BACKWASH FILTER No 1
65-FI-62 ELUTION BACKWASH FILTER No 2
65-TK-63 ELUTION WATER TANK
65-PP-62 ELUTION CIRCUIT No 2 WATER PUMP
65-WC-65 ELUTION CIRCUIT No 2 RECYCLE STANDPIPE
65-TK-62 ELUATE TANK No 2

- LEGEND
- EXISTING
 - NON-EXISTENT
 - STAGE 1 - NEW
 - STAGE 1 - REMOVE
 - STAGE 1 - DECOMMISSIONED (OTHERS)
 - STAGE 2 - NEW
 - STAGE 2 - REMOVE
 - STAGE 2 - DECOMMISSIONED (OTHERS)

KCGM GROWTH PROJECT				
DRAWING NO. 2000-F65-PID-PR-10005				
REV	DATE	DESCRIPTION	CHECK	TECH APP
0	4SEP25	APPROVED FOR CONSTRUCTION		


FME-00-SP-419	MISCELLANEOUS EQUIP. LIST CONTRACT #F037
FME-00-SP-415	MANUAL VALVE SCHEDULE
FME-00-SP-411	PIPING LINE LIST ELUTION CIRC./GOLD ROOM
FME-00-P-401	PIPING KEYPLAN
FME-00-SP-408	INSTRUMENT STANDARDS
FME-00-SP-404	STANDARD ABBREV. & VALVE SYMBOLS
FME-00-SP-403	STANDARD EQUIPMENT SYMBOLS
DRAWING No.	REFERENCE DRAWINGS

COPYRIGHT ©
This drawing remains the property of MINPROC ENGINEERS LIMITED and may not be copied in any way without prior written approval from this company.

MINPROC ENGINEERS LIMITED
A.C.N. 008 992 694
22, STIRLING HIGHWAY, NEDLANDS WA 6009
PHONE (09) 347 4777

No.	BY	DATE	REVISION	CHECKED	No.	BY	DATE	REVISION	CHECKED
13	JMD	28.04.2020	SAMPLE STATION'S REMOVED - 'AS BUILT'	T.R.	6	gt	9/6/95	LN3 65-603/604-NS REMOVED	
12	JMD	15/06/16	ELUATE BYPASS TANK ADDED		5	PR	8/5/95	REVISIED AS NOTED	
11	DL	11/7/07	LINE No 64-40-BE-MS-000 L 65-400-FD-PE-MSA REMOVED		4	PR	19/4/95	REVISIED AS NOTED	
10	LW	29/07/05	VALVES ADDED - AS NOTED	SW	3		31/3/95	REVISIED AS NOTED	
9	DA	19/2/00	L/S'S ADDED TO FLUSHING VALVES		2		10/2/95	APPROVED FOR CONSTRUCTION	
8	DL	3/2/2000	CHK VALVES ADDED - "AS BUILT"		1		27/1/95	RE-ISSUED FOR TENDER	
7	DL	29/10/99	FILTERS 65-FI-01 & 02 ADDED		0		21/12/94	APPR. FOR TENDER - F037	
No.	BY	DATE	REVISION	CHECKED	No.	BY	DATE	REVISION	CHECKED

PROJECT APPR.	RY	DATE
DESIGN APPR.		3/5/95
DESIGNED		20/2/95
CHECKED		28/2/95
DRAWN		19/4/94

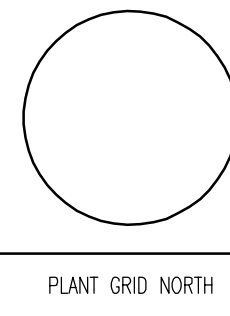

CLIENT	KALGOORLIE CONSOLIDATED GOLD	SIZE	B1	SCALE	N.T.S.
TITLE	FIMSTON EXPANSION 1994/95 PIPING & INSTRUMENTATION DIAGRAM LEAN ELUATE CIRCUIT	REV.	01	DATE	19/4/94
DRAWING No.	65\PI\0448	REV.	02	DATE	13/11/94
		REV.	03	DATE	18/11/94
		REV.	04	DATE	19/11/94
		REV.	05	DATE	19/11/94
		REV.	06	DATE	19/11/94
		REV.	07	DATE	19/11/94
		REV.	08	DATE	19/11/94
		REV.	09	DATE	19/11/94
		REV.	10	DATE	19/11/94