


- NOTES
1. DELETED.
 2. XXX REFERS TO PROCESS SLURRY CONTAINING MERCURY
 3. NEW 160 OD HDPE LINE TO REPLACE EXISTING LINE TO TAILS DISCHARGE HOPPER

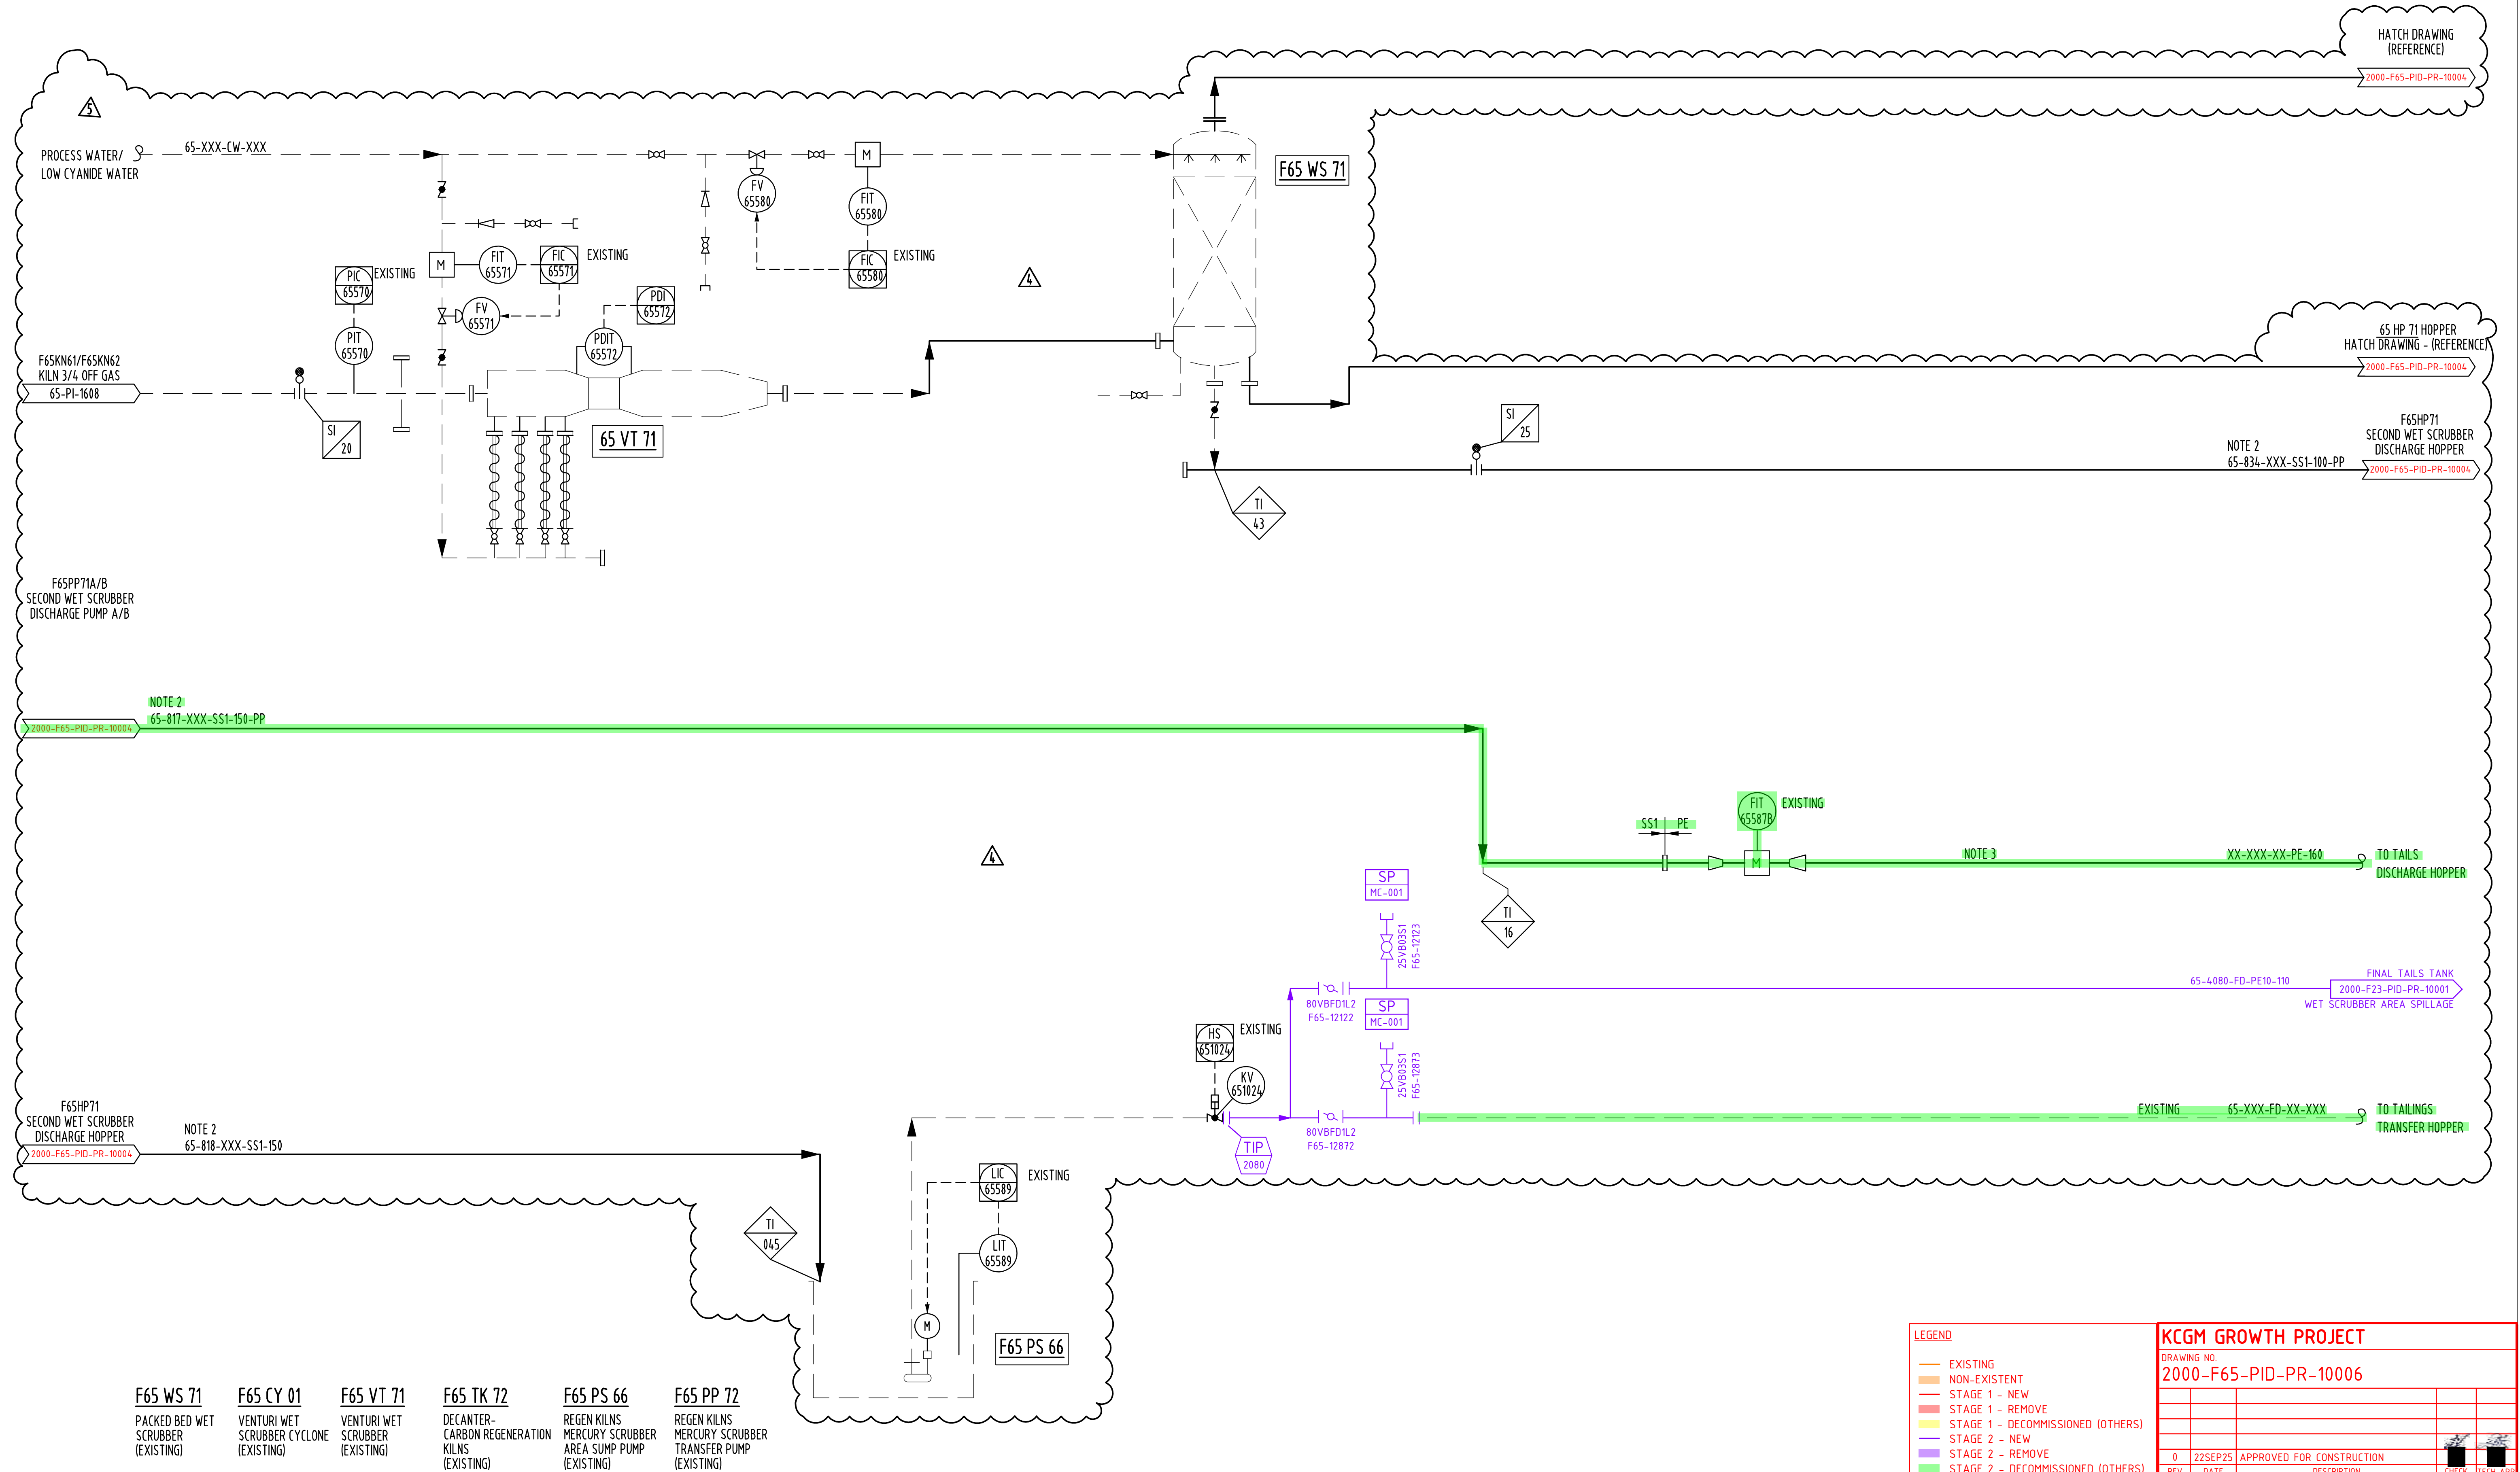

LEGEND										KCGM GROWTH PROJECT									
— EXISTING										DRAWING NO.									
— NON-EXISTENT										2000-F65-PID-PR-10006									
— STAGE 1 - NEW																			
— STAGE 1 - REMOVE																			
— STAGE 1 - DECOMMISSIONED (OTHERS)																			
— STAGE 2 - NEW																			
— STAGE 2 - REMOVE																			
— STAGE 2 - DECOMMISSIONED (OTHERS)																			
										0 22SEP25 APPROVED FOR CONSTRUCTION									
										REV DATE DESCRIPTION CHECK TECH APP									
										DRAWING NUMBER									
										65-PI-1605									
										5									
										KALGOORLIE CONSOLIDATED GOLD MINES PTY. LTD.									
										ABN 099 377 619 003									

F65 WS 71		F65 CY 01		F65 VT 71		F65 TK 72		F65 PS 66		F65 PP 72	
PACKED BED WET SCRUBBER (EXISTING)		VENTURI WET SCRUBBER CYCLONE (EXISTING)		VENTURI WET SCRUBBER (EXISTING)		DECANTER-CARBON REGENERATION KILNS (EXISTING)		REGEN KILNS MERCURY SCRUBBER AREA SUMP PUMP (EXISTING)		REGEN KILNS MERCURY SCRUBBER TRANSFER PUMP (EXISTING)	

5	17.04.2020	REVISED - 'AS BUILT'	OGS	T.R.	-
4	05.05.2016	AS BUILT ADDED	MDR		
3	06.MAR15	REVISED FOR GAS SUBMISSION	YA		
2	28NOV14	GENERAL REVISION	YA		
1	12SEP14	ISSUED FOR CONSTRUCTION	YA		
0	23MAY14	ISSUED FOR DESIGN			

DATE	REVISION	BY	CHKD	APP	DATE	REVISION	BY	CHKD	APP

SCALE	NTS	EL	1B
DRAWN	24JUN13		
DESIGNED	24JUN13		
CHECKED	24JUN13		
APPROVED			
PROJ APP			
DWG NO.	PROJ. FILE #.		

00 X SP X 1003	00-PI-1603	00-PI-1602
ABBREVIATIONS, DRAWING EQUIPMENT NUMBERING & BASIC VALVE SYMBOLS	TYPICAL DETAILS - PIPING AND INSTRUMENTATION DIAGRAM SHEET 2	TYPICAL DETAILS - PIPING AND INSTRUMENTATION DIAGRAM SHEET 1
REFERENCE DRAWINGS		