


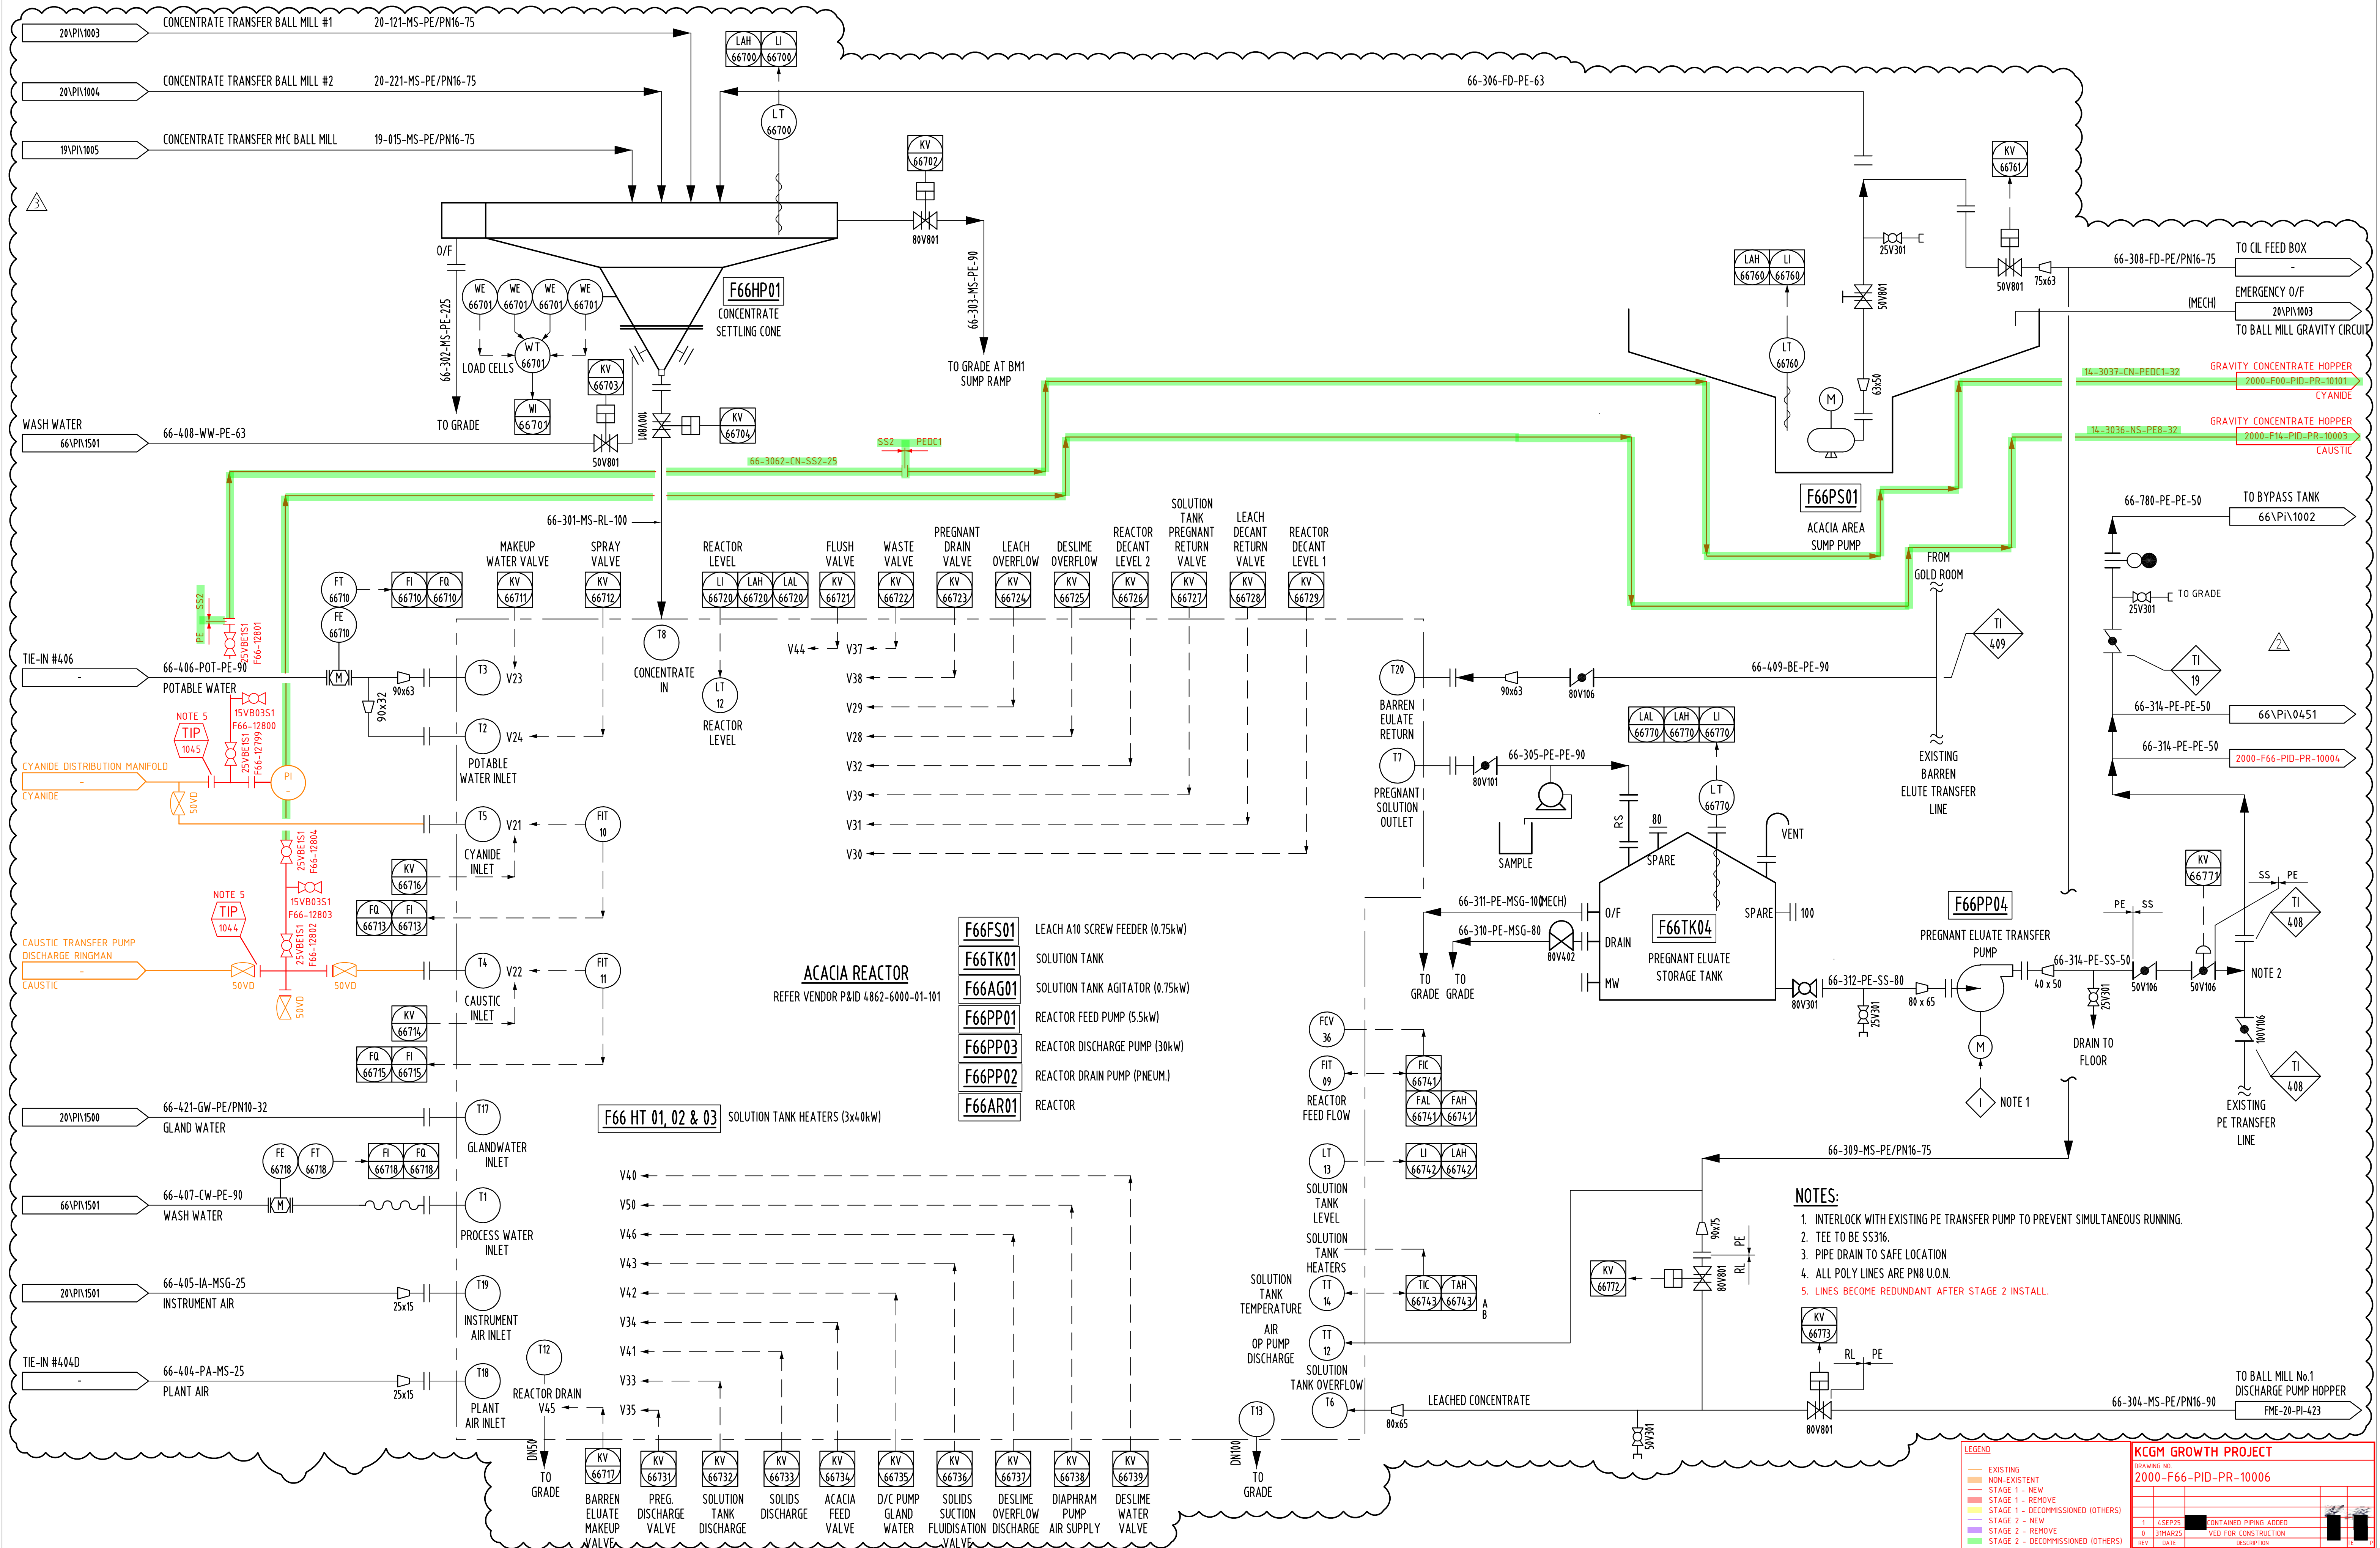

			3			30.04.2020	REVISED - "AS BUILT"				T.R.			-				SCALE			NTS			FIMSTON PLANT			SIZE			DRAWING NUMBER			REV		
			2			05.07.2016	ISSUED FOR ELUATE BYPASS TANK TENDER				SRM							DRAWN			1/12/03			ACACIA REACTOR AREA			A1			66\PI\1500			3		
			1			15.06.2016	ELUATE BYPASS TANK ADDED											DESIGNED			1/12/03			P & ID											
			0			12.05.04	APPROVED FOR CONSTRUCTION											CHECKED			1/12/03														
MK			DATE			REVISION			BY			CKD			APP			DWG NO.			PROJ. FILE #			KALGOORLIE CONSOLIDATED GOLD MINES PTY. LTD.			ABN 009 377 619 003								