


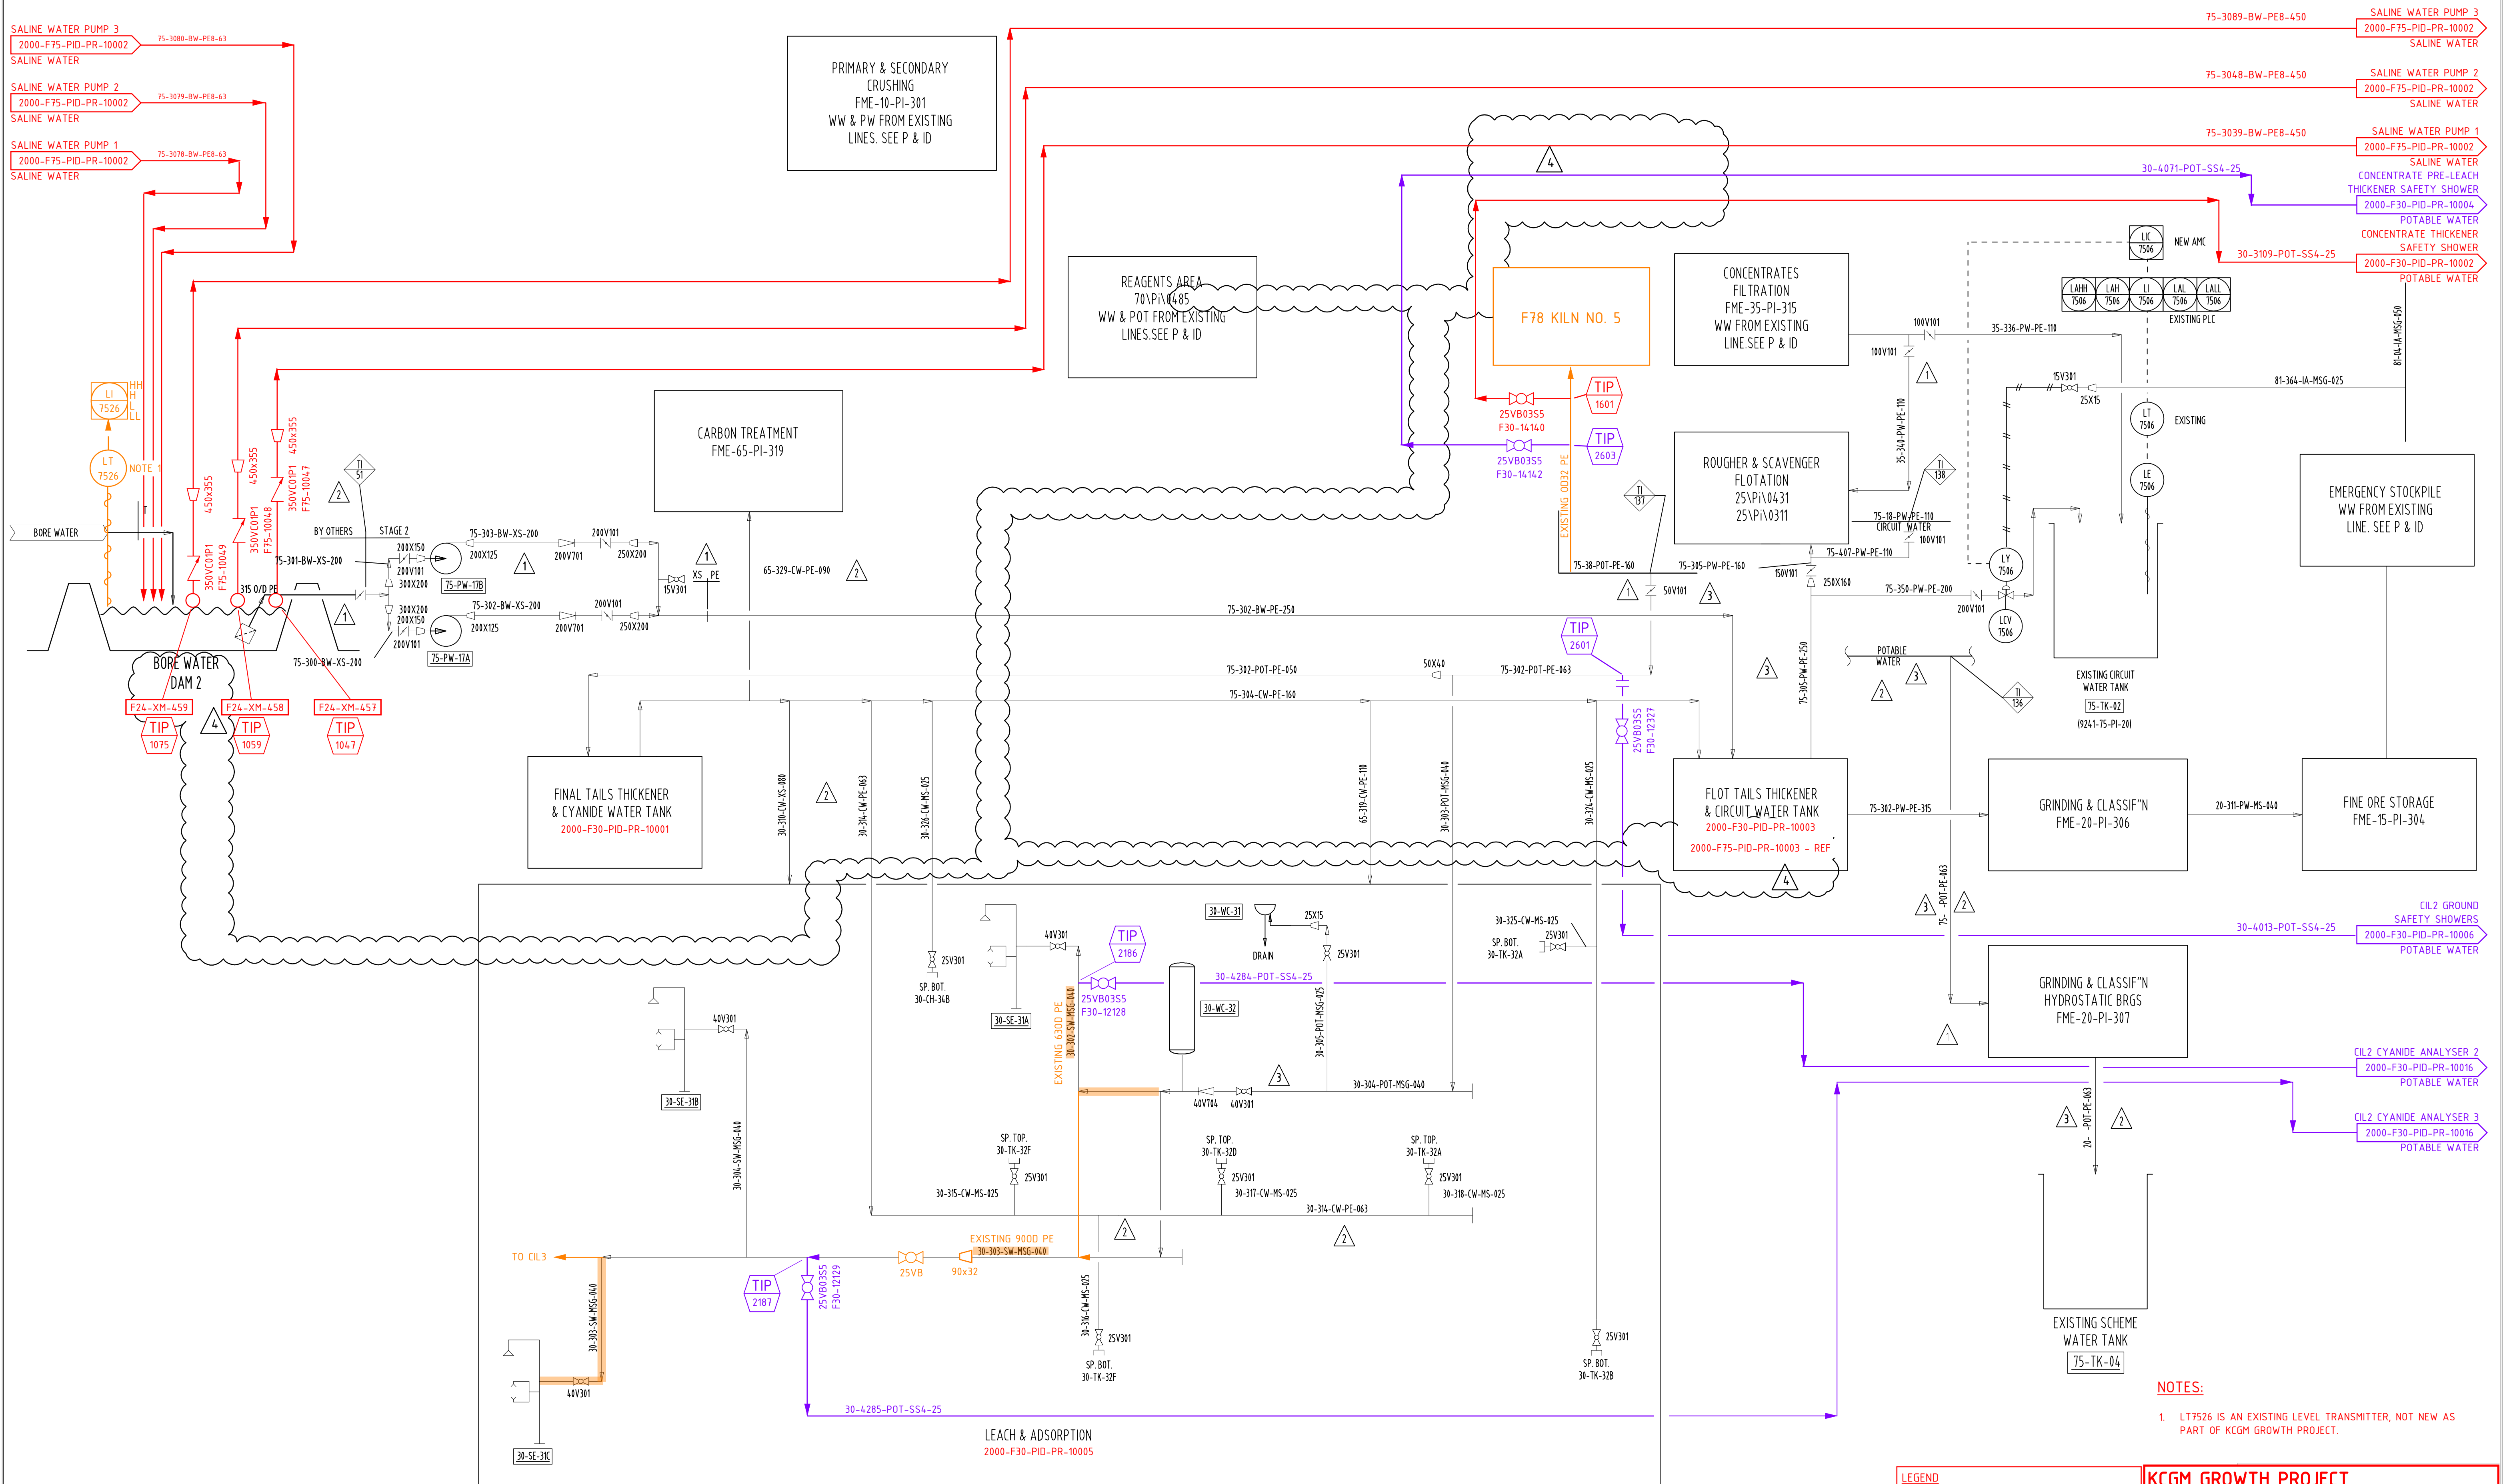

30-SE-31A/C	SHOWER/EYEWASH - CIL TANKS	75-PW-17A/B	BORE WATER/DAM PUMP	F24-XM-457	SALINE WATER PUMP 1 SUCTION TURRET	F24-XM-458	SALINE WATER PUMP 2 SUCTION TURRET	F24-XM-459	SALINE WATER PUMP 3 SUCTION TURRET
30-WC-31	DRINKING FOUNTAIN								
30-WC-32	SHOWER/ACCUMULATOR - CIL TANKS								

COPYRIGHT ©		MINPROC ENGINEERS PTY. LTD.		22 STIRLING HIGHWAY, NEDLANDS, W. A. 6009 TELEPHONE : 389 1655		4		REVISED - 'AS BUILT'		4/9/91		AS BUILT		P.B.		PROJECT APPR.		DATE		12/3/91		CLIENT		KALGOORLIE CONSOLIDATED GOLD MINES		SIZE		SCALE		B1		N.T.S.	
FME-00/P-301		PIPING KEY PLAN				3		FW		4/9/91		AS BUILT								12/3/91													
FME-00/SP-03		EQUIPMENT SYMBOLS				2		FAC		14/5/91		REVISED AS NOTED		P.B.		DESIGN APPR.				12/3/91													
FME-00/SP-04		P & ID SYMBOLS				1				8/4/91		SPEC CHGE 314, 340&342-PW ADDED		B.R.						12/3/91													
DRAWING No.		REFERENCE DRAWINGS				0		B		26/3/91		VALVE ADDED TO 75-302-POT				DESIGNED				12/3/91													
						B				15/2/91		ISSUED FOR CONSTRUCTION				CHECKED				12/3/91													
						A				11/7/91		ISSUED FOR APPROVAL																					
						No.		BY		DATE		REVISION		CHECKED		No.		BY		DATE		PLANT GRID NORTH											

DRAWING No.		REFERENCE DRAWINGS		This drawing remains the property of MINPROC ENGINEERS PTY. LTD. and may not be copied in any way without prior written approval from this company.		REV		DATE		DESCRIPTION		CHECK		TECH APP	
						1		4SEP25		LT7526 LEGEND COLOUR UPDATED					
						0		31MAR25		APPROVED FOR CONSTRUCTION					

TITLE		FIMSTON EXPANSION PROJECT STAGE 2 PIPING & INSTRUMENTATION DIAGRAM WATER MANAGEMENT & TAILINGS - FIM.SITE		REV. No.		1		2		3		932		9	
-------	--	---	--	----------	--	---	--	---	--	---	--	---	--	---	--	---	--	---	--	---	--	---	--	----	--	----	--	-----	--	-----	--	---	--