


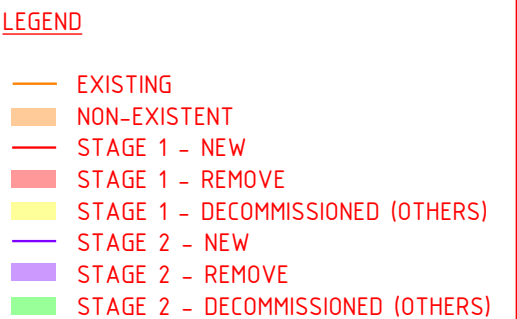

DRAWING NO.
2000-F75-PID-PR-10007

1		[REDACTED]	TO F75-TK-63B		
0	25JUN25	APPROVED FOR CONSTRUCTION			
REV	DATE	DESCRIPTION		CHECK	TECH APP

SIZE	SCALE									
B1	N.T.S.									
REV.	0	1	2	3	4	5	6	7		
No.										
DRAWING No.										
75\PI\0462										

1. THIS DRAWING TO BE READ IN CONJUNCTION WITH P&ID 75-PI-0504

2. PUMPS REQUIRING GLAND WATER THAT ARE WITHIN BROWNFIELDS SCOPE ARE TO BE TIED TO THE EXISTING GLAND WATER CIRCUIT. REFER TO 2000-F2- [REDACTED] AND 2000-F24-PID-PR-10035 FOR BROWNFIELDS [REDACTED] DETAIL

NOTE GLAND WATER POLYETHYLENE PIPES
TO BE PE 80 TYPE B PN10

75\PI1083	GLAND SEAL WATER PUMP DISCHARGE MOD'S
FME-00-SP-403	STANDARD EQUIPMENT SYMBOLS
FME-00-SP-404	ABBREVIATIONS & VALVE SYMBOLS
FME-00-SP-408	INSTRUMENT STANDARDS
DRAWING No.	REFERENCE DRAWINGS

COPYRIGHT ©

This drawing remains the property of MINPROC ENGINEERS LIMITED and may not be copied in any way without prior written approval from this company.

MINPROC ENGINEERS LIMITED


A.C.N. 008 992 694

22, STIRLING HIGHWAY, NEDLANDS WA 6009

PHONE (09) 347 4777

						6	DL	31/12/2008	REF TO DWG NO 19/P1/409 REMOVED		
						5	DL	5/2/2002	MOD'S AS PER 75/P1/1083 ADDED		
						4	DL	21/4/95	APPROVED FOR CONSTRUCTION F035		
						3	DL	3/4/95	APPROVED FOR TENDER BALL MILLS 1 & 2		
						2	DL	17/3/95	APPROVED FOR TENDER F035		
						1	DL	12/12/94	REVISED AS NOTED SEE DRG#SP-410		
7		11.05.2020	TANK REMOVED. PUMP ADDED - AS BUILT			0	DL	5/12/94	APPROVED FOR CONSTRUCTION		
No.	BY	DATE	REVISION	CHECKED		No.	BY		REVISION	CHECKED	

	BY	DATE
PROJECT APPR.	[REDACTED]	5/12/94
DESIGN APPR.	[REDACTED]	5/12/94
DESIGNED	[REDACTED]	5/12/94
CHECKED	[REDACTED]	5/12/94
DRAWN	[REDACTED]	5/12/94

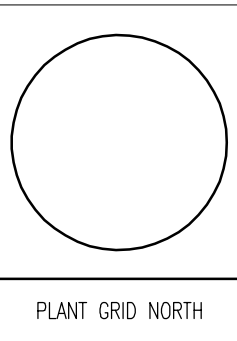

CLIENT	KALGOORLIE CONSOLIDATED GOLD
TITLE	FIMISTON EXPANSION 1994/95 PIPING & INSTRUMENT DIAGRAM GLAND WATER SYSTEM

[illegible]