

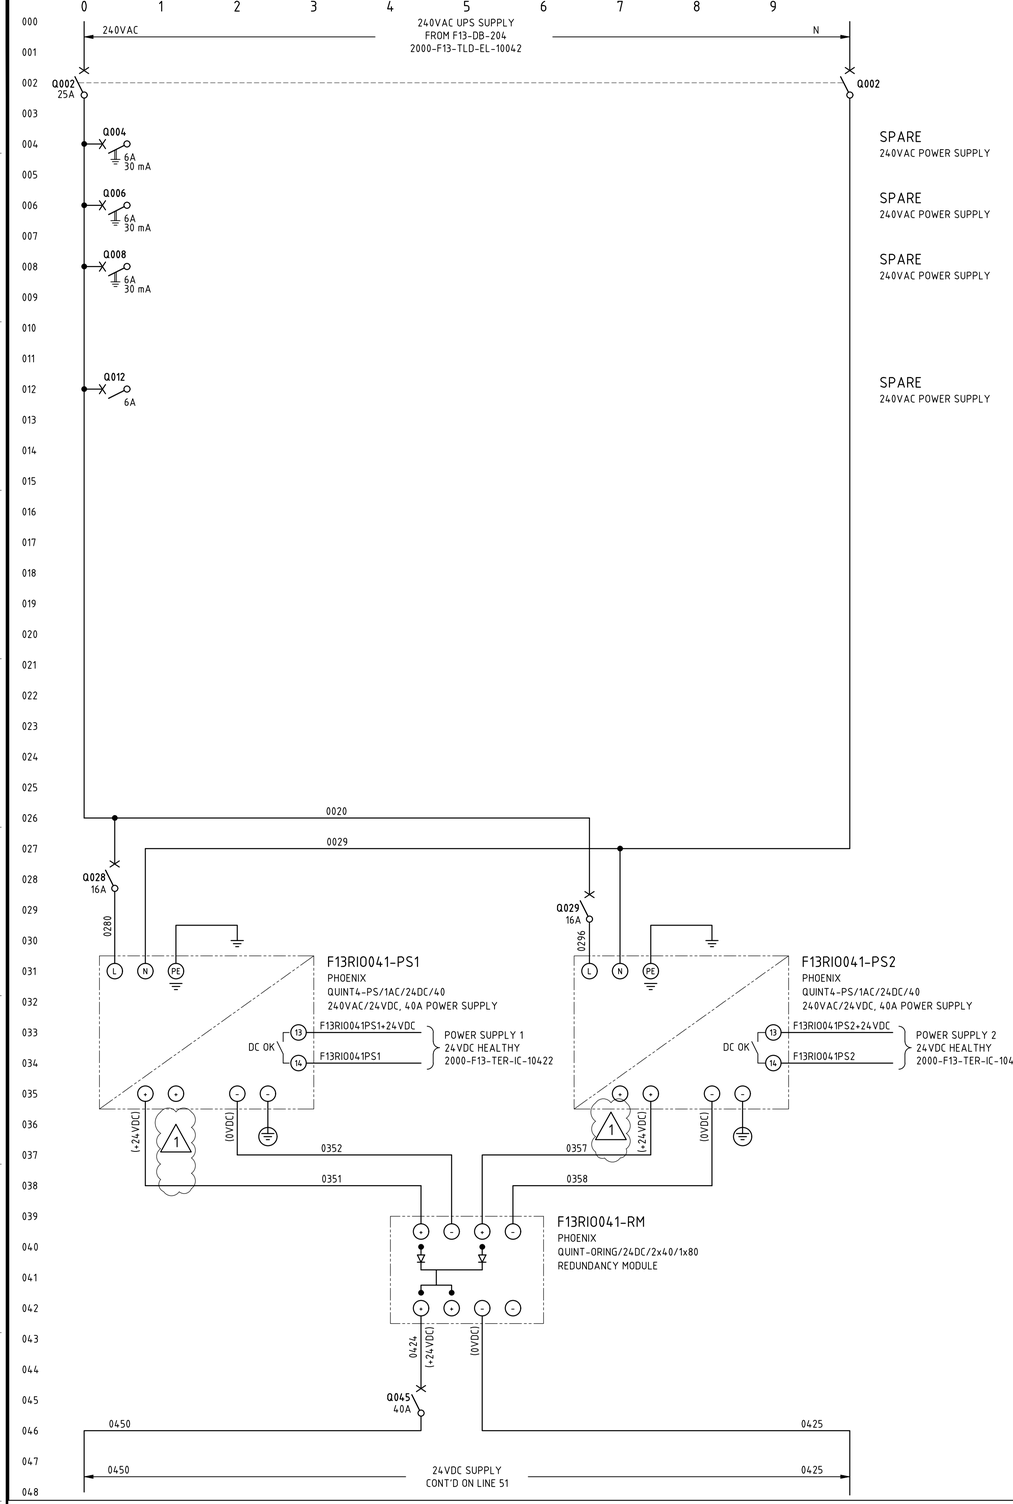


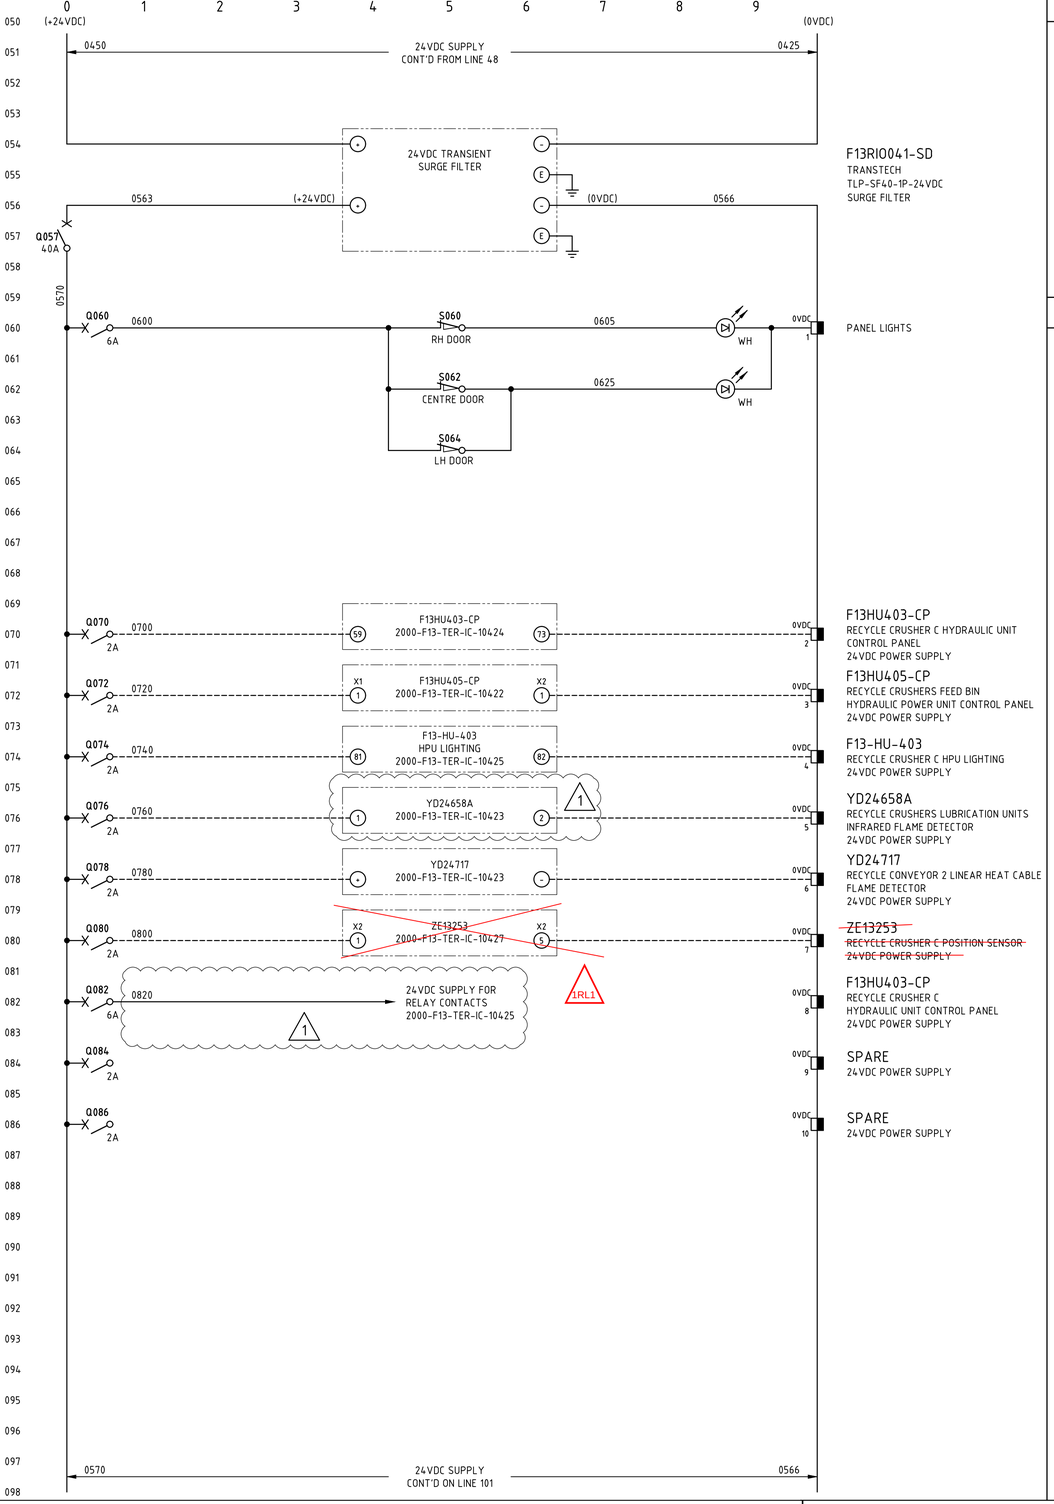

NOTES

1. TERMINALS ON TERMINAL STRIPS ABOVE 50VAC SHALL HAVE A SEPARATE PERSPEX SHROUD AND SHALL BE LABELLED "DANGER xxxVAC".
2. WIRE NUMBER FERRULES ON TERMINAL STRIP SHALL BE PREFIXED WITH EQUIPMENT NUMBER e.g. F13RIO041-xxxx.
3. EACH WIRE SHALL BE IDENTIFIED AT BOTH ENDS WITH FERRULES.
4. FOR NETWORK CONNECTION & BUS CABLING DETAILS REFER TO RIO PANEL COMMUNICATIONS TERMINATION DIAGRAMS.
5. INSTRUMENT EARTH BAR TO BE BONDED TO MAIN EARTH BAR WITH SOLID COPPER LINK.

LEGEND

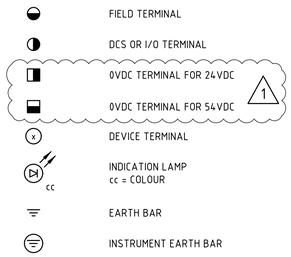

AS CONSTRUCTED

CHANGE: ☒ NO CHANGE: ☐

SIGNATURE: *Karl Whitelaw*
NAME: Karl Whitelaw
DATE: 27 / 10 / 25

ENGINEER SIGN OFF

SIGNATURE: *Jordan Peace*
NAME: Jordan Peace
DATE: 27 / 10 / 25

2000-F13-SCM-IC-10421_Rev1A

Recycle crushing F13-RIO-041 recycle crushing field n-IO panel - schematic diagram sheet 1