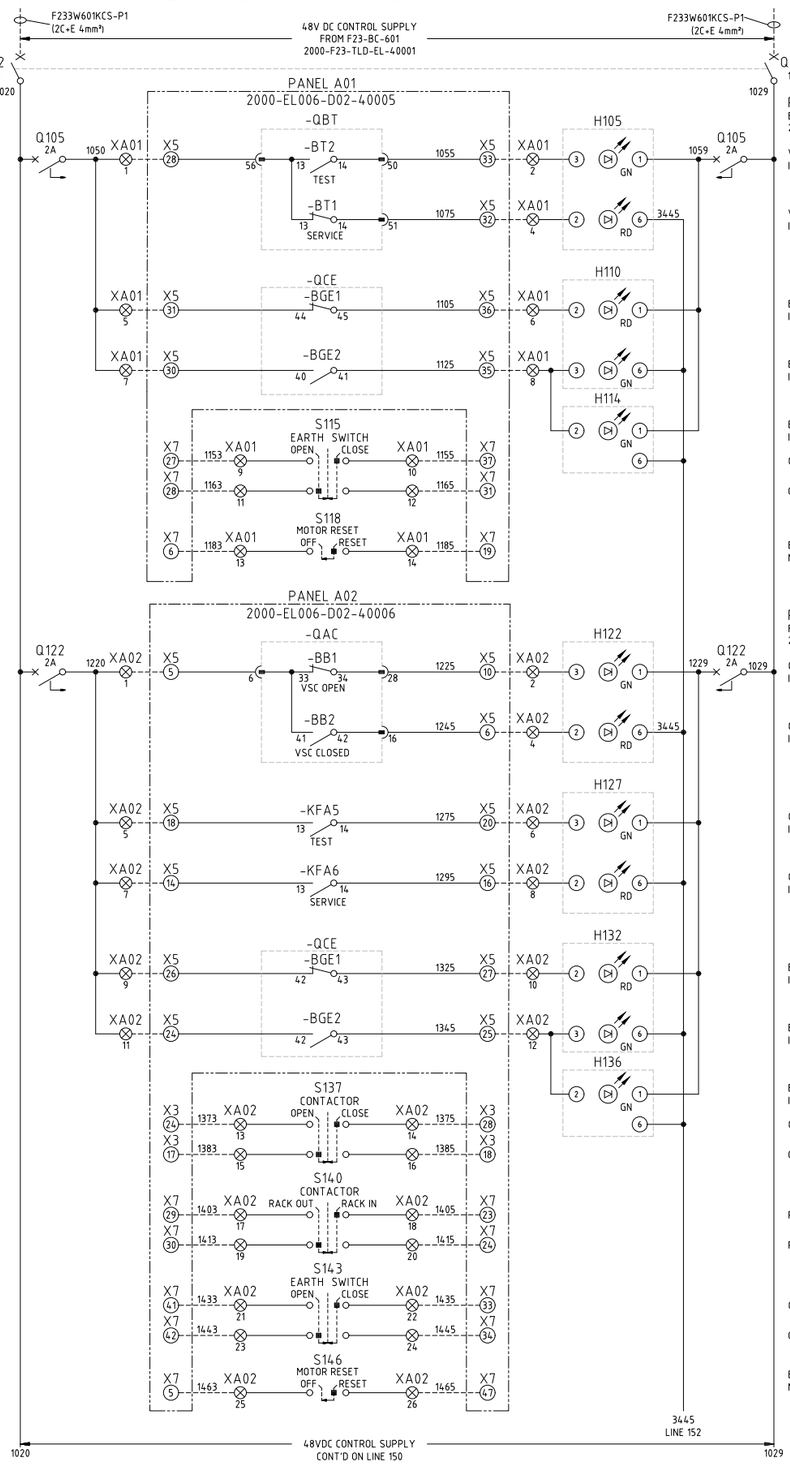


PANEL A01
BUS VT & EARTH SWITCH
2000-F23-TER-EL-40001

VT RACKED OUT INDICATION

VT RACKED IN INDICATION

EARTH SWITCH OPEN INDICATION

EARTH SWITCH CLOSED INDICATION

EARTH SYMBOL INDICATION

CLOSE EARTH SWITCH COMMAND

OPEN EARTH SWITCH COMMAND

EARTH SWITCH MOTOR RESET

PANEL A02
F23PP651-VS FEEDER
2000-F23-TER-EL-40001

CONTACTOR OPEN INDICATION

CONTACTOR CLOSED INDICATION

CONTACTOR RACKED OUT INDICATION

CONTACTOR RACKED IN INDICATION

EARTH SWITCH OPEN INDICATION

EARTH SWITCH CLOSED INDICATION

EARTH SYMBOL INDICATION

CLOSE CONTACTOR COMMAND

OPEN CONTACTOR COMMAND


RACK IN CONTACTOR COMMAND

RACK OUT CONTACTOR COMMAND

CLOSE EARTH SWITCH COMMAND

OPEN EARTH SWITCH COMMAND

EARTH SWITCH MOTOR RESET

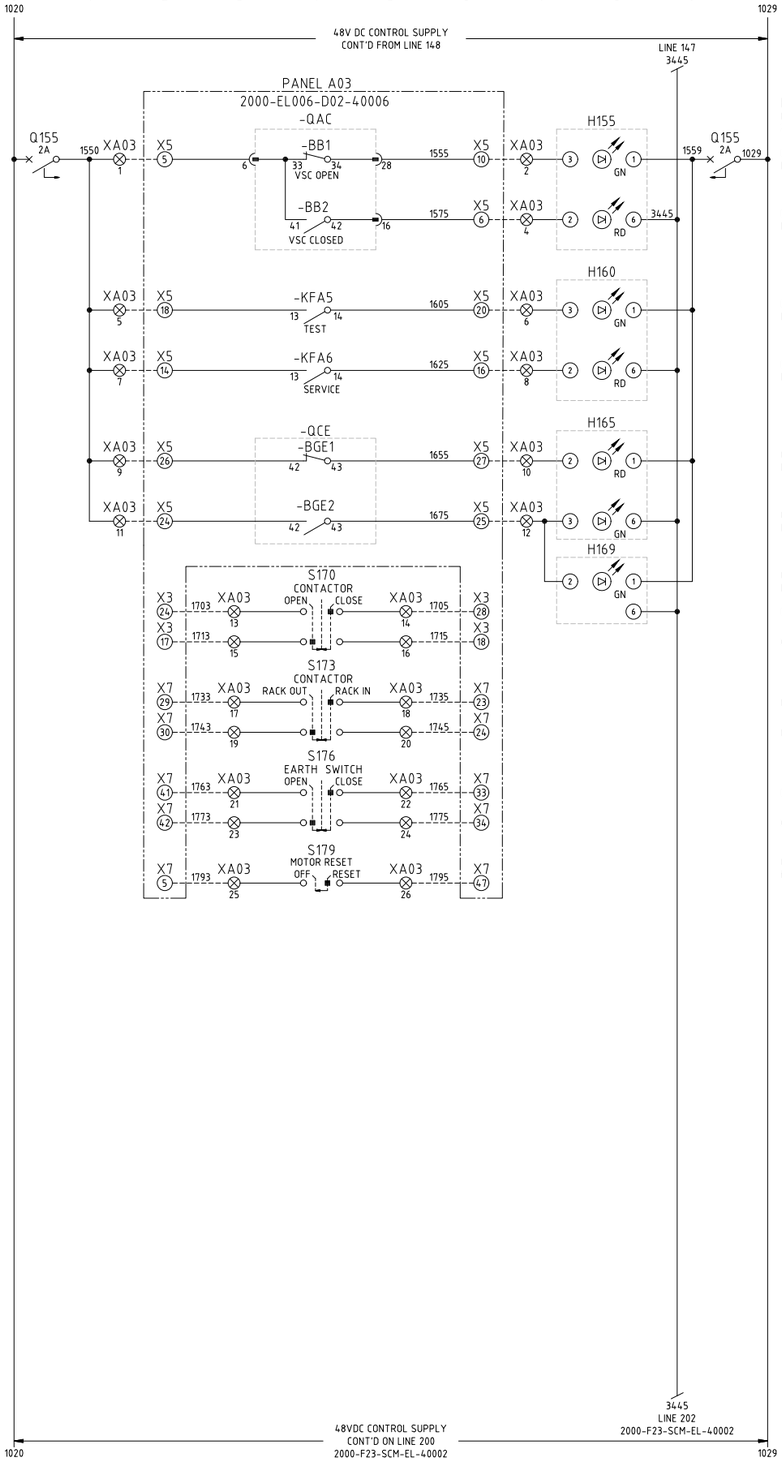

PANEL A03
F23PP652-VS FEEDER
2000-F23-TER-EL-40001

CONTACTOR OPEN INDICATION

CONTACTOR CLOSED INDICATION

CONTACTOR RACKED OUT INDICATION

CONTACTOR RACKED IN INDICATION

EARTH SWITCH OPEN INDICATION

EARTH SWITCH CLOSED INDICATION

EARTH SYMBOL INDICATION

CLOSE CONTACTOR COMMAND

OPEN CONTACTOR COMMAND

RACK IN CONTACTOR COMMAND

RACK OUT CONTACTOR COMMAND

CLOSE EARTH SWITCH COMMAND

OPEN EARTH SWITCH COMMAND

EARTH SWITCH MOTOR RESET

NOTES

1. WIRE NUMBER FERRULES ON TERMINAL STRIP SHALL BE PREFIXED WITH EQUIPMENT NUMBER e.g. FxxPPxxx-1200.
2. EACH WIRE SHALL BE IDENTIFIED AT BOTH ENDS WITH FERRULES.

LEGEND

- ⊗ RSP TERMINAL
- Xx (xx) HV SWITCHBOARD TERMINAL
- (x) DEVICE TERMINAL

AS BUILT

2000-F23-SCM-EL-40001_Rev2

FIM III booster station F23-SW-601 HV switchboard remote switching panel schematic diagram sheet 1