
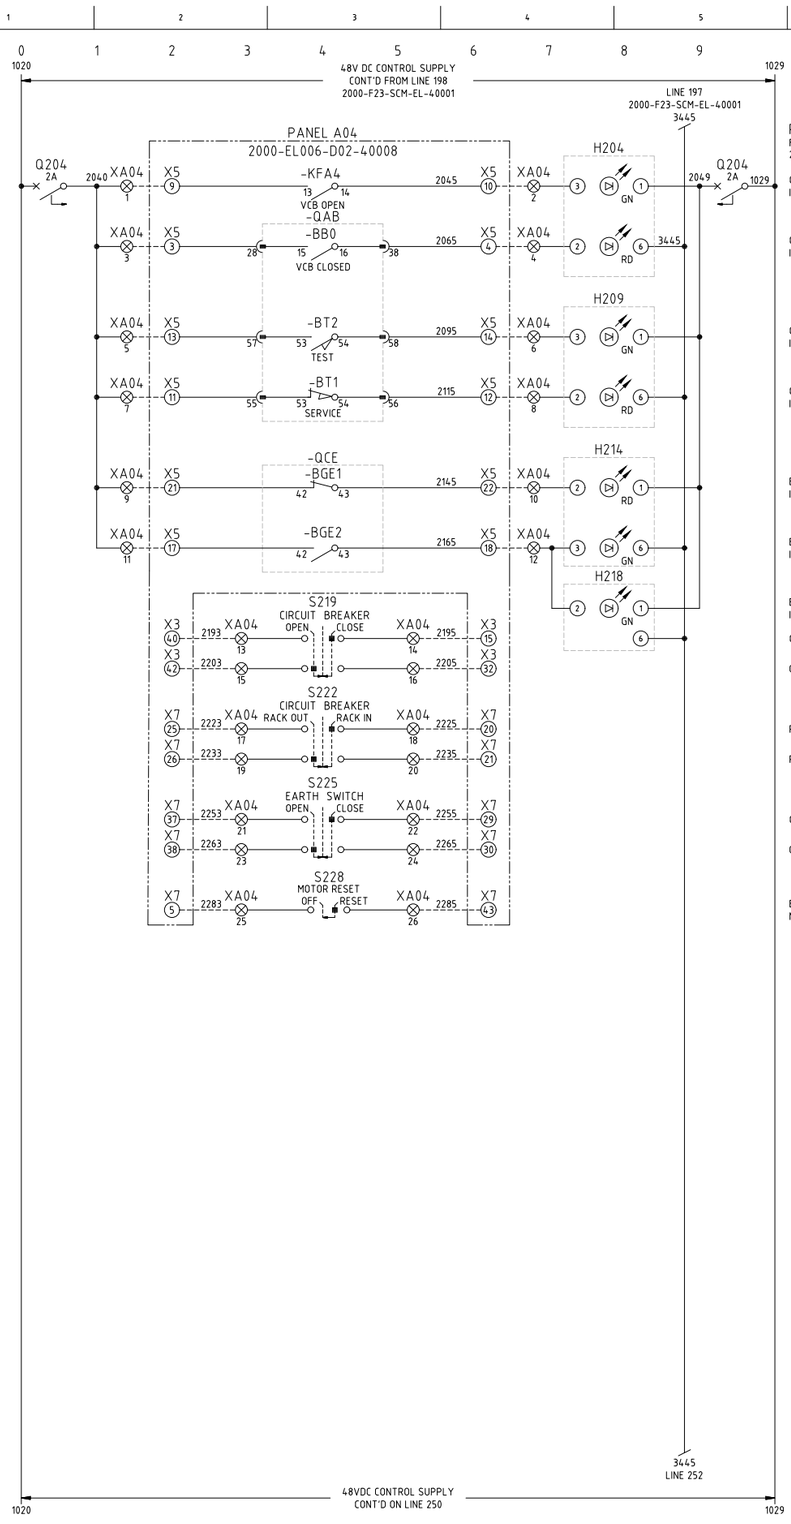


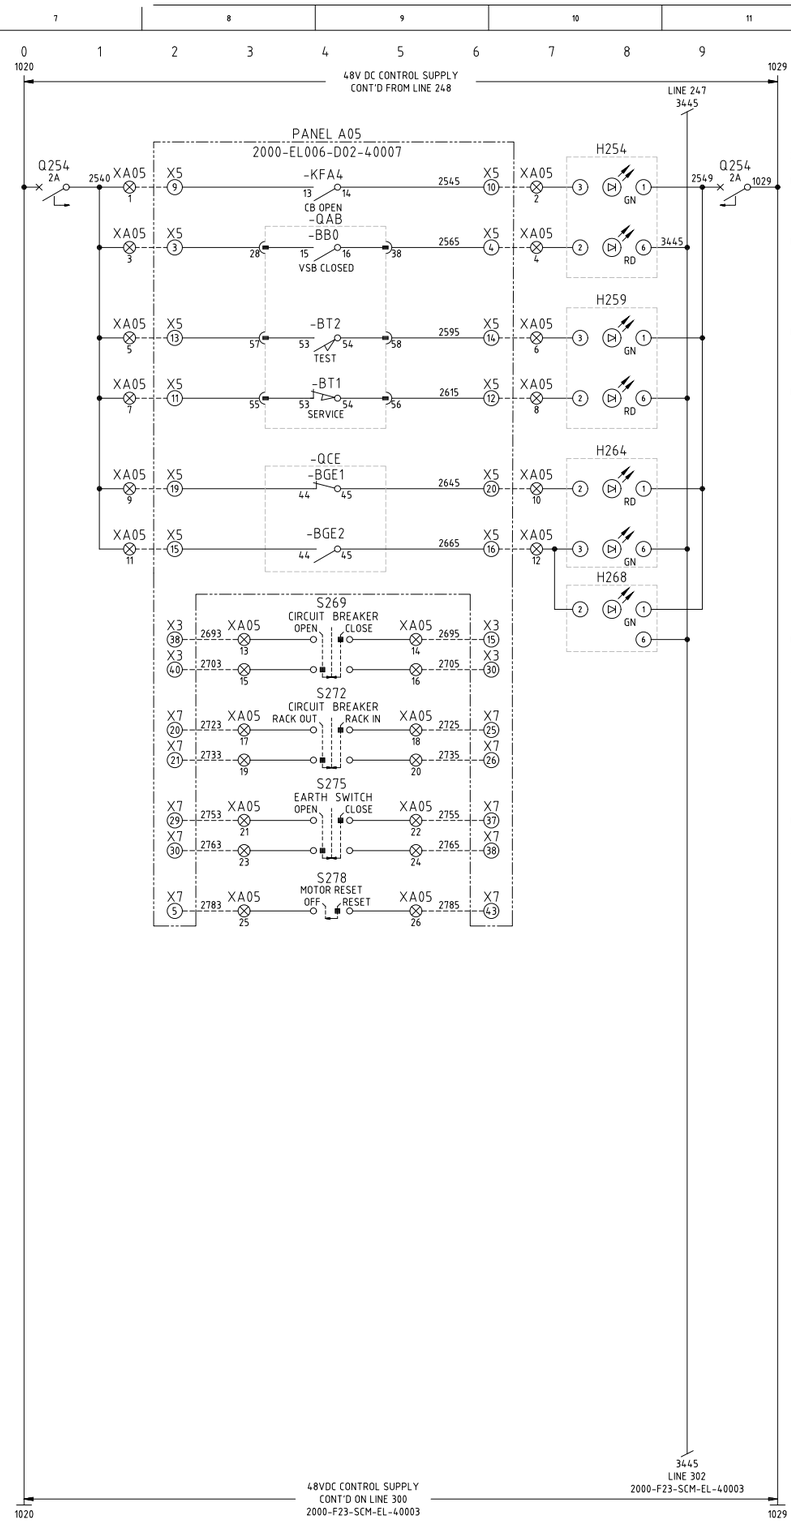

NOTES

1. WIRE NUMBER FERRULES ON TERMINAL STRIP SHALL BE PREFIXED WITH EQUIPMENT NUMBER e.g. FxxPPxxx-1200.
2. EACH WIRE SHALL BE IDENTIFIED AT BOTH ENDS WITH FERRULES.

LEGEND

- ⊗ RSP TERMINAL
- Xx (xx) HV SWITCHBOARD TERMINAL
- (x) DEVICE TERMINAL

AS BUILT

2000-F23-SCM-EL-40002_Rev2

FIM III booster station F23-SW-601 HV switchboard remote switching panel schematic diagram sheet 2