

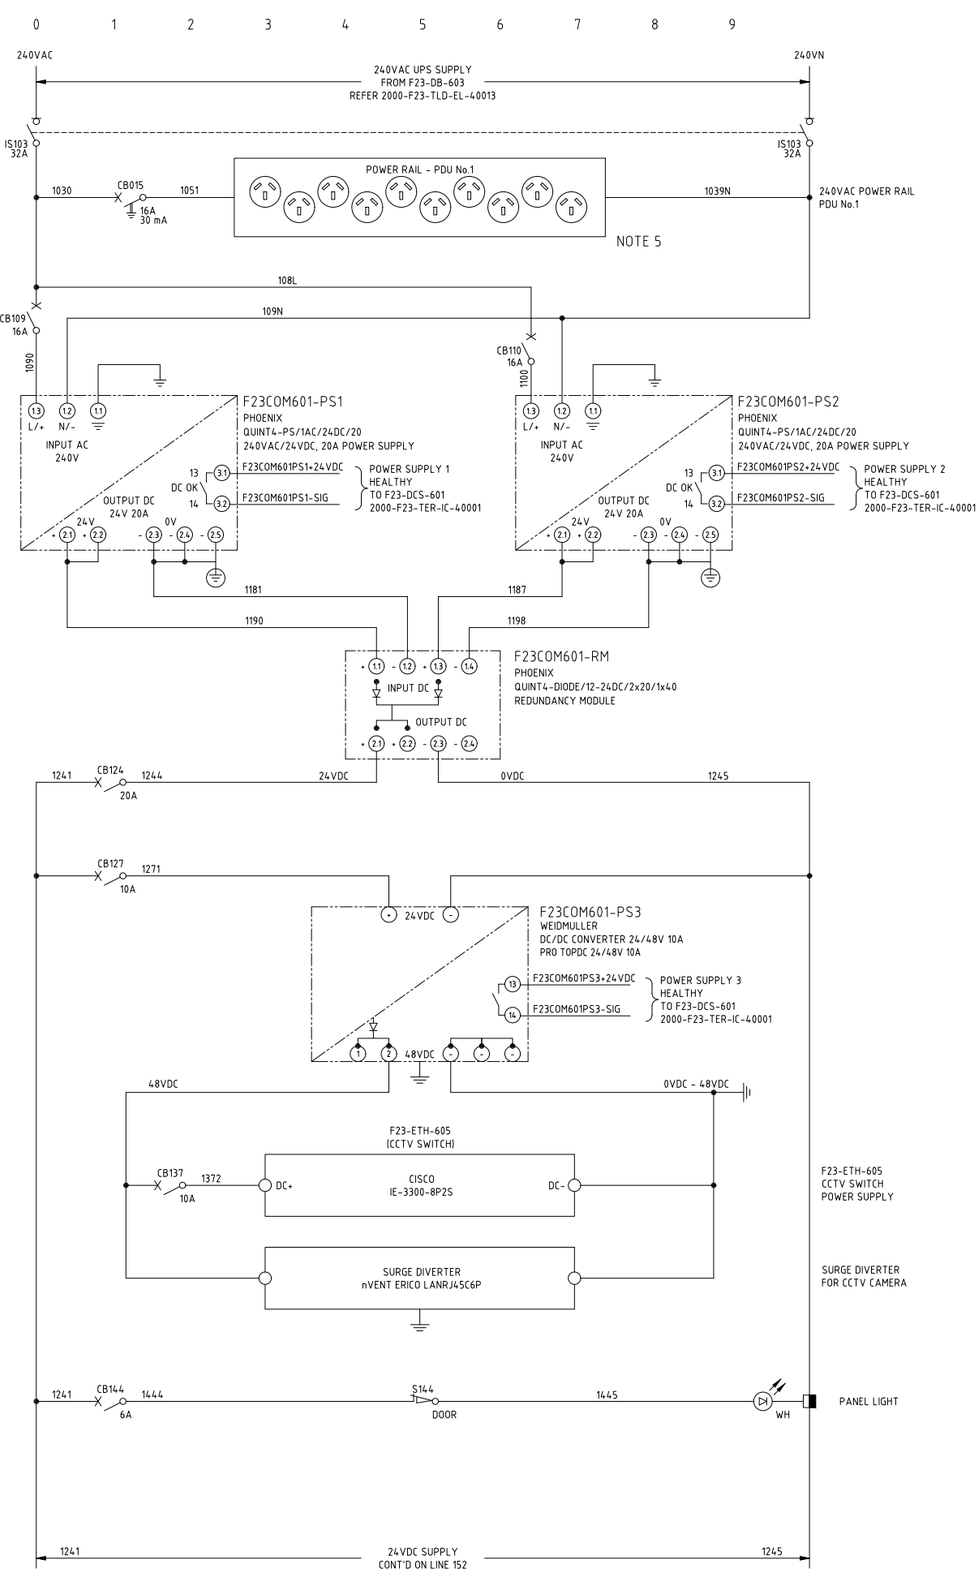


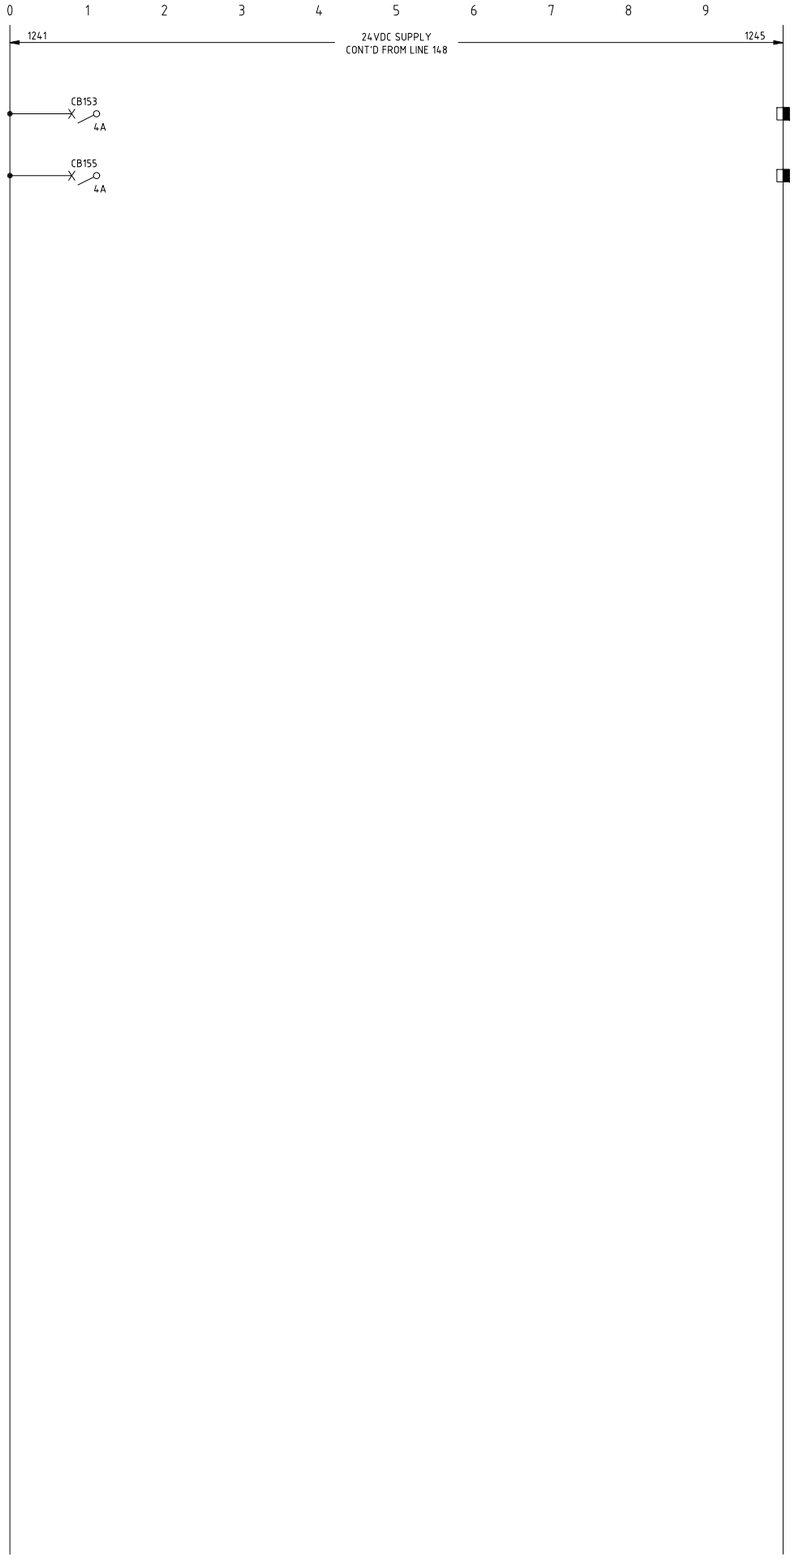

NOTES

1. EACH WIRE SHALL BE IDENTIFIED AT BOTH ENDS WITH FERRULES.
2. REFFER TO THE ELECTRICAL EQUIPMENT LIST 2000-F23-LST-EL-40002 FOR DETAILS OF FOBOTS AND NETWORK SWITCHES.
3. REFER TO COMMUNICATIONS RACK GENERAL ARRANGEMENT DRAWING 2000-F23-DRG-IC-40001.
4. REFER TO COMMUNICATIONS BLOCK DIAGRAM 2000-F23-BLK-IC-40001.
5. EACH CISCO ETHERNET SWITCH AND SERVEREDGE KVM SHALL HAVE ONE POWER CABLES CONNECTED FROM THE DEVICE TO THE 240VAC PDU.

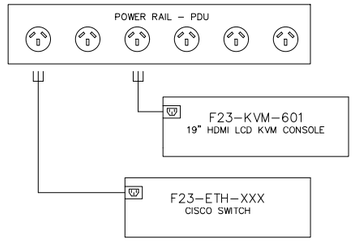

AS BUILT

2000-F23-SCM-IC-40001_Rev3

Communications cabinet schematic diagram