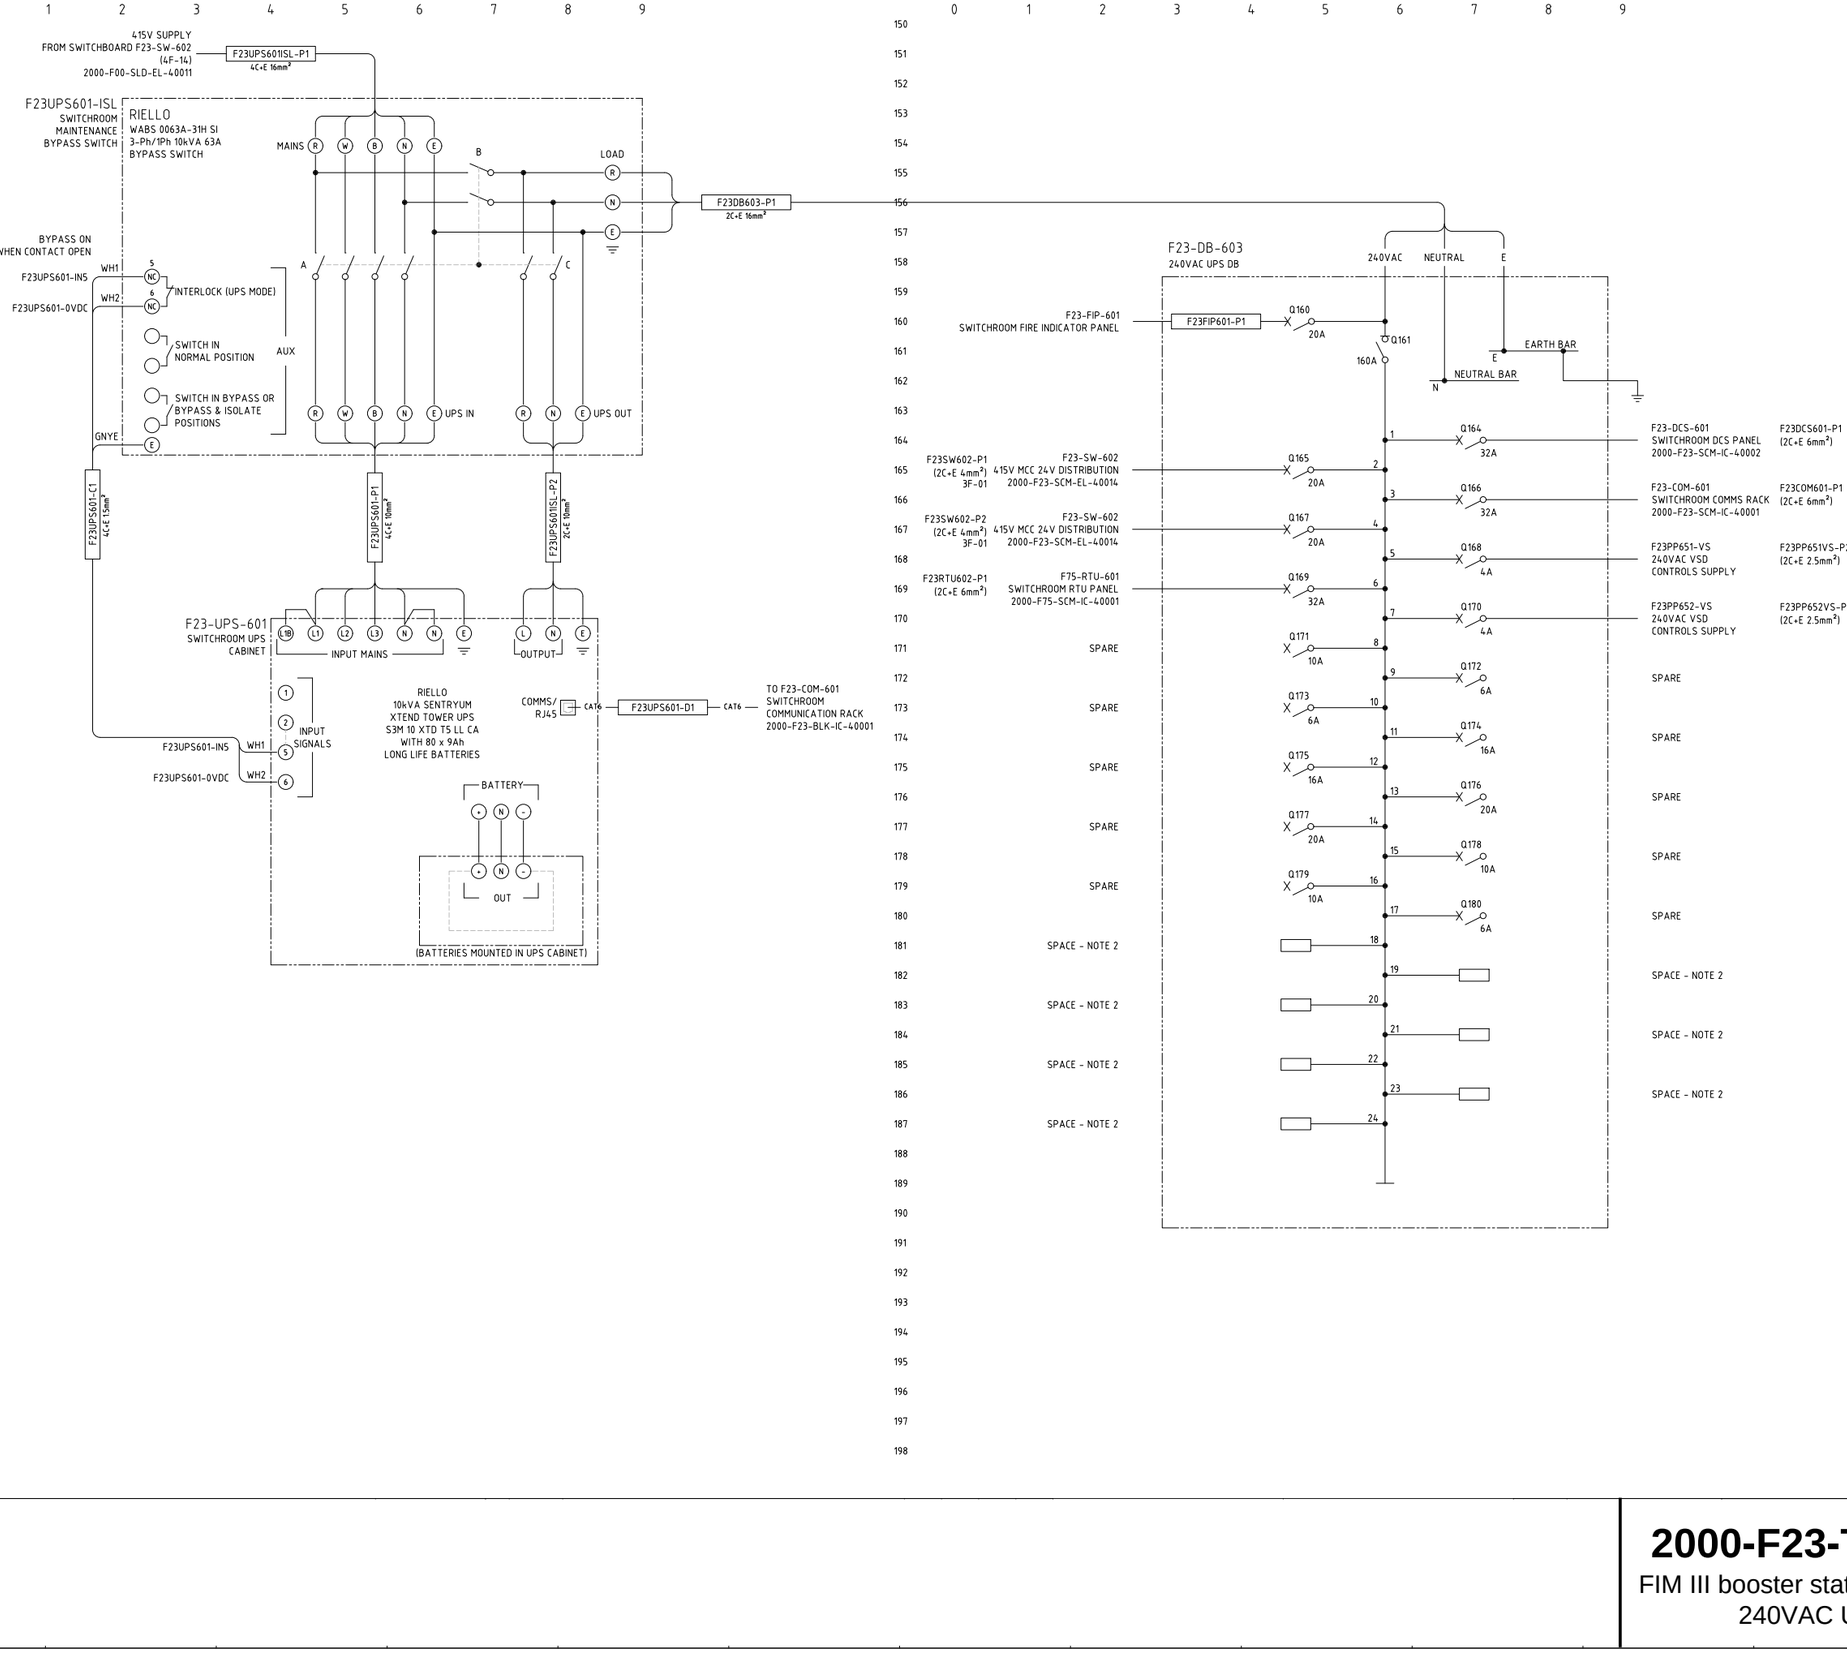


NOTES

1. CIRCUIT BREAKERS SHALL BE PAD-LOCKABLE IN THE 'OFF' POSITION ONLY, VIA LOCK-DOGS OR SIMILAR, LOCKING TO ESCUTCHEON SHALL NOT BE ACCEPTABLE.
2. ALL SPARE SPACE SHALL BE FILLED WITH DUMMY CIRCUIT BREAKERS, ESCUTCHEON POLE FILLERS SHALL NOT BE ACCEPTABLE.
3. EQUIPOTENTIAL BONDING CONDUCTOR SHALL BE INSTALLED FROM DB EARTH BAR TO SWITCHROOM EARTH BAR OR NEAREST EARTHED STRUCTURE VIA 35mm² Cu GNYE/PVC OR AS PER CABLE SCHEDULE.
4. AS-BUILT CIRCUIT SCHEDULE SHALL BE KEPT INTERNAL TO DISTRIBUTION BOARD AT ALL TIMES.
5. MINIMUM 20% SPARE CIRCUIT BREAKERS AND ADDITIONAL 20% SPARE SPACE SHALL BE PROVIDED FOR FUTURE LOADS.
6. DISTRIBUTION BOARD SHALL BE CONSTRUCTED IN ACCORDANCE WITH STANDARD - 2000-F00-STS-EL-10007. LOW VOLTAGE DISTRIBUTION BOARDS SPECIFICATION.
7. UPS MAINTENANCE BYPASS SWITCH SHALL BE OF THE ROTARY 3-POSITION TYPE. POSITIONS AS FOLLOWS:
   NORMAL MODE: SWITCH A & C CLOSED
   BYPASS MODE: SWITCH A & B CLOSED
   BYPASS & ISOLATE MODE: SWITCH B CLOSED
8. REFER TO FIM III BOOSTER STATION ELECTRICAL EQUIPMENT LIST 2000-F23-LST-EL-40002 FOR EQUIPMENT AND UPS DETAILS.
9. REFER TO FIM III BOOSTER STATION CABLE SCHEDULE 2000-F23-LST-EL-40003 FOR CABLE DETAILS.

LEGEND

- MCC TERMINAL
- VSD TERMINAL
- FIELD TERMINAL
- PLC OR I/O TERMINAL
- MARSHALLING TERMINAL
- DISTRIBUTION BOARD TERMINAL
- DEVICE TERMINAL
- INDICATION LAMP cc = COLOUR
- DUMMY CIRCUIT BREAKER NOTE 2

AS BUILT

2000-F23-TLD-EL-40013_Rev1

FIM III booster station F23-DB-603 HV/LV switchroom
240VAC UPS DB three-line diagram