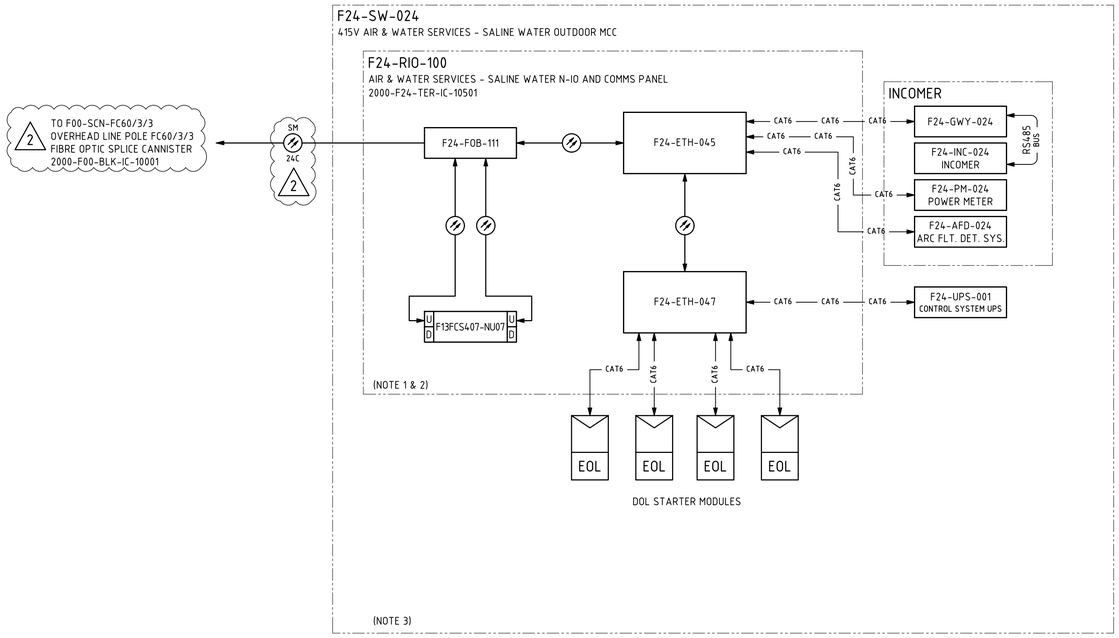


NOTES

1. FOR INTERNAL FIBRE OPTIC, CAT6 PATCH LEAD EQUIPMENT CONNECTION DETAILS REFER TO SPECIFIC TERMINATION DIAGRAMS.
2. REFER TO SPECIFIC COMMUNICATIONS TERMINATION DRAWINGS FOR EXTERNAL EQUIPMENT CONNECTION DETAIL.
3. RIO PANEL, MCC & SWITCHBOARD HARDWARE/INTERCONNECTIONS (E.G. NIO NODE) & INTER-FOBOT PATCHING NOT SHOWN FOR CLARITY. REFER TO SPECIFIC COMMUNICATIONS TERMINATION DRGS FOR DETAIL.

LEGEND

FOB	FIBRE OPTIC BREAK OUT TRAY
ETH	ETHERNET SWITCH HIRSCHMANN = DCS NETWORKS CISCO = ALL OTHER NETWORKS
FCS	YOKOGAWA FIELD CONTROL UNIT
xxxFCS4xx-NUxx (U/D)	YOKOGAWA NODE INTERFACE UNIT (DUAL OPTICAL ESB PORTS: U = UPLINK, D = DOWNLINK) TAG RELATED TO PARENT FCS
GWY	COMMUNICATIONS GATEWAY
MC	FIBRE TO CAT6 MEDIA CONVERTER
xxx	EQUIPMENT OR VENDOR PACKAGE PANELS AS NOTED WITHIN BLOCK.
EOL	MCC MODULE DOL INTELLIGENT ELECTRONIC DEVICE/OVERLOAD
UPS	UNINTERRUPTIBLE POWER SUPPLY
	VSD - VARIABLE SPEED DRIVE (WALL MOUNTED)
	MULTI CORE FIBRE OPTIC CABLE OR DUPLEX PATCH LEAD
CAT6	CAT6 ETHERNET CABLE CONNECTION

AS CONSTRUCTED

CHANGE: ☐ NO CHANGE: ☒

SIGNATURE: George Forrest
NAME: GEORGE FORREST
DATE: 2025/12/06

ENGINEER SIGN OFF

SIGNATURE: Sanam Gurung
NAME: SANAM GURUNG
DATE: 2025/12/06

2000-F24-BLK-IC-10501_Rev2A

Saline water F24-SW-024 and remote IO communications block diagram