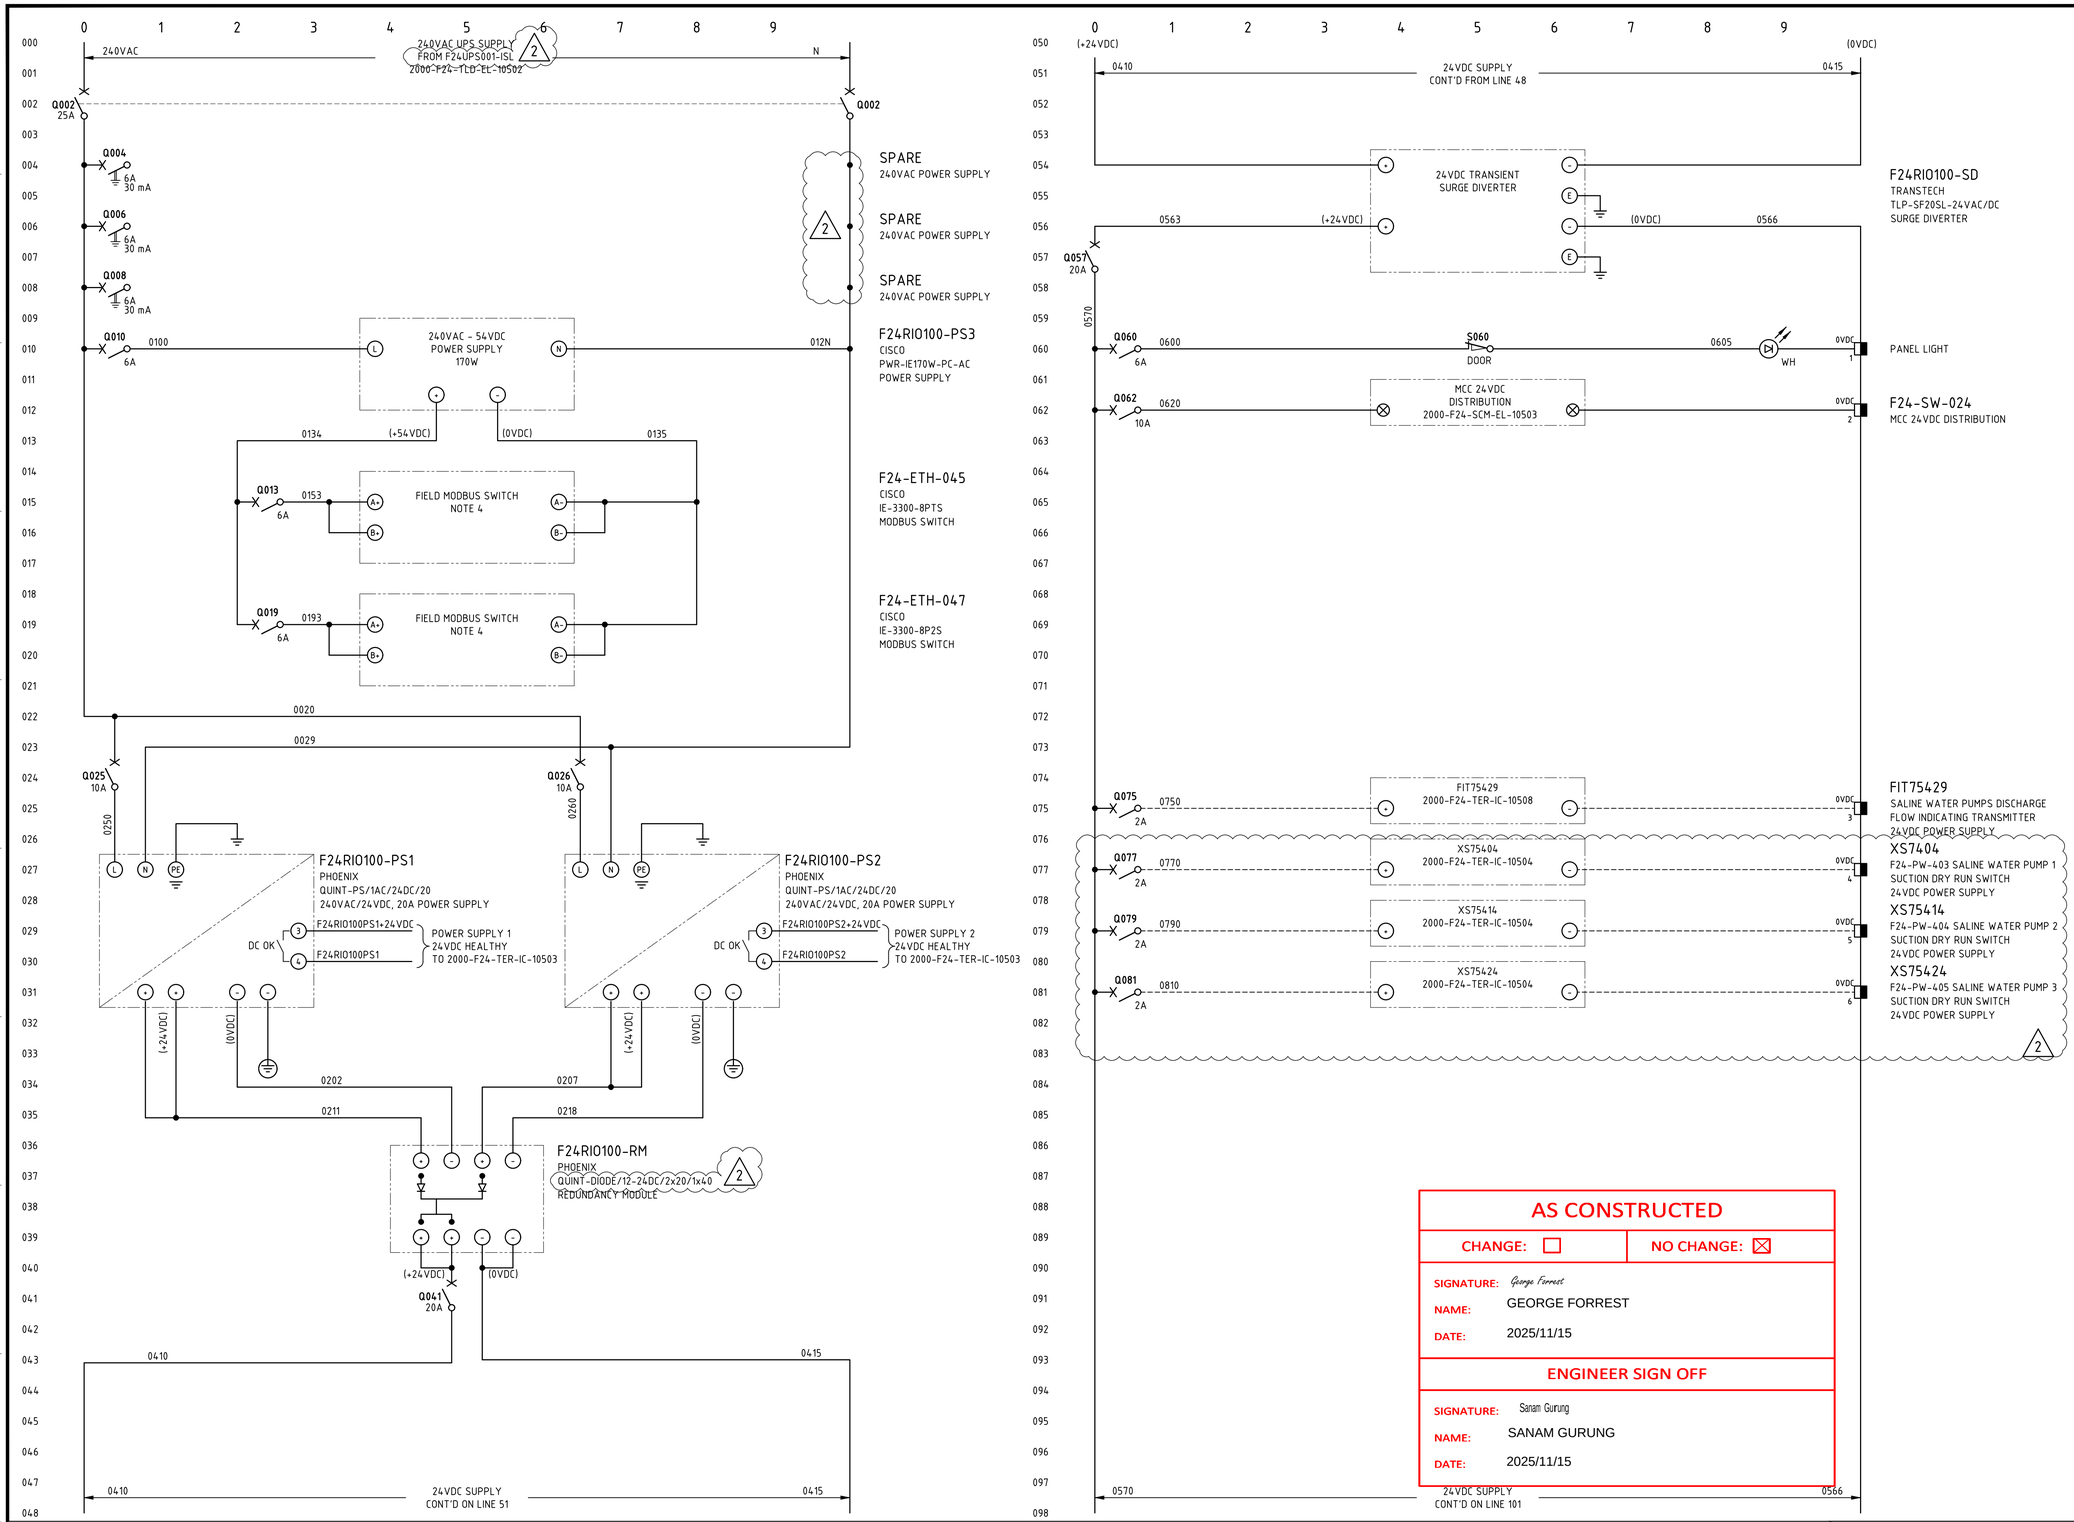


NOTES

1. TERMINALS ON TERMINAL STRIPS ABOVE 50VAC SHALL HAVE A SEPARATE PERSPEX SHROUD AND SHALL BE LABELLED "DANGER xxxVAC".
2. WIRE NUMBER FERRULES ON TERMINAL STRIP SHALL BE PREFIXED WITH EQUIPMENT NUMBER e.g. F24RIO100-xxxx.
3. EACH WIRE SHALL BE IDENTIFIED AT BOTH ENDS WITH FERRULES.
4. FOR NETWORK CONNECTION & BUS CABLING DETAILS REFER TO: MCC COMMUNICATIONS TERMINATION DIAGRAMS.
5. INSTRUMENT EARTH BAR TO BE BONDED TO MAIN EARTH BAR WITH SOLID COPPER LINK.

LEGEND

- FIELD TERMINAL
- DCS OR I/O TERMINAL
- 0VDC TERMINAL FOR 24VDC
- 0VDC TERMINAL FOR 54VDC
- DEVICE TERMINAL
- INDICATION LAMP (cc = COLOUR)
- EARTH BAR
- INSTRUMENT EARTH BAR

AS CONSTRUCTED

CHANGE: ☐ NO CHANGE: ☒

SIGNATURE: George Forrest
NAME: GEORGE FORREST
DATE: 2025/11/15

ENGINEER SIGN OFF

SIGNATURE: Sanam Gurung
NAME: SANAM GURUNG
DATE: 2025/11/15

2000-F24-SCM-IC-10501_Rev2A

Saline water F24-SW-024 MCC n-IO and comms panel schematic diagram sheet 1