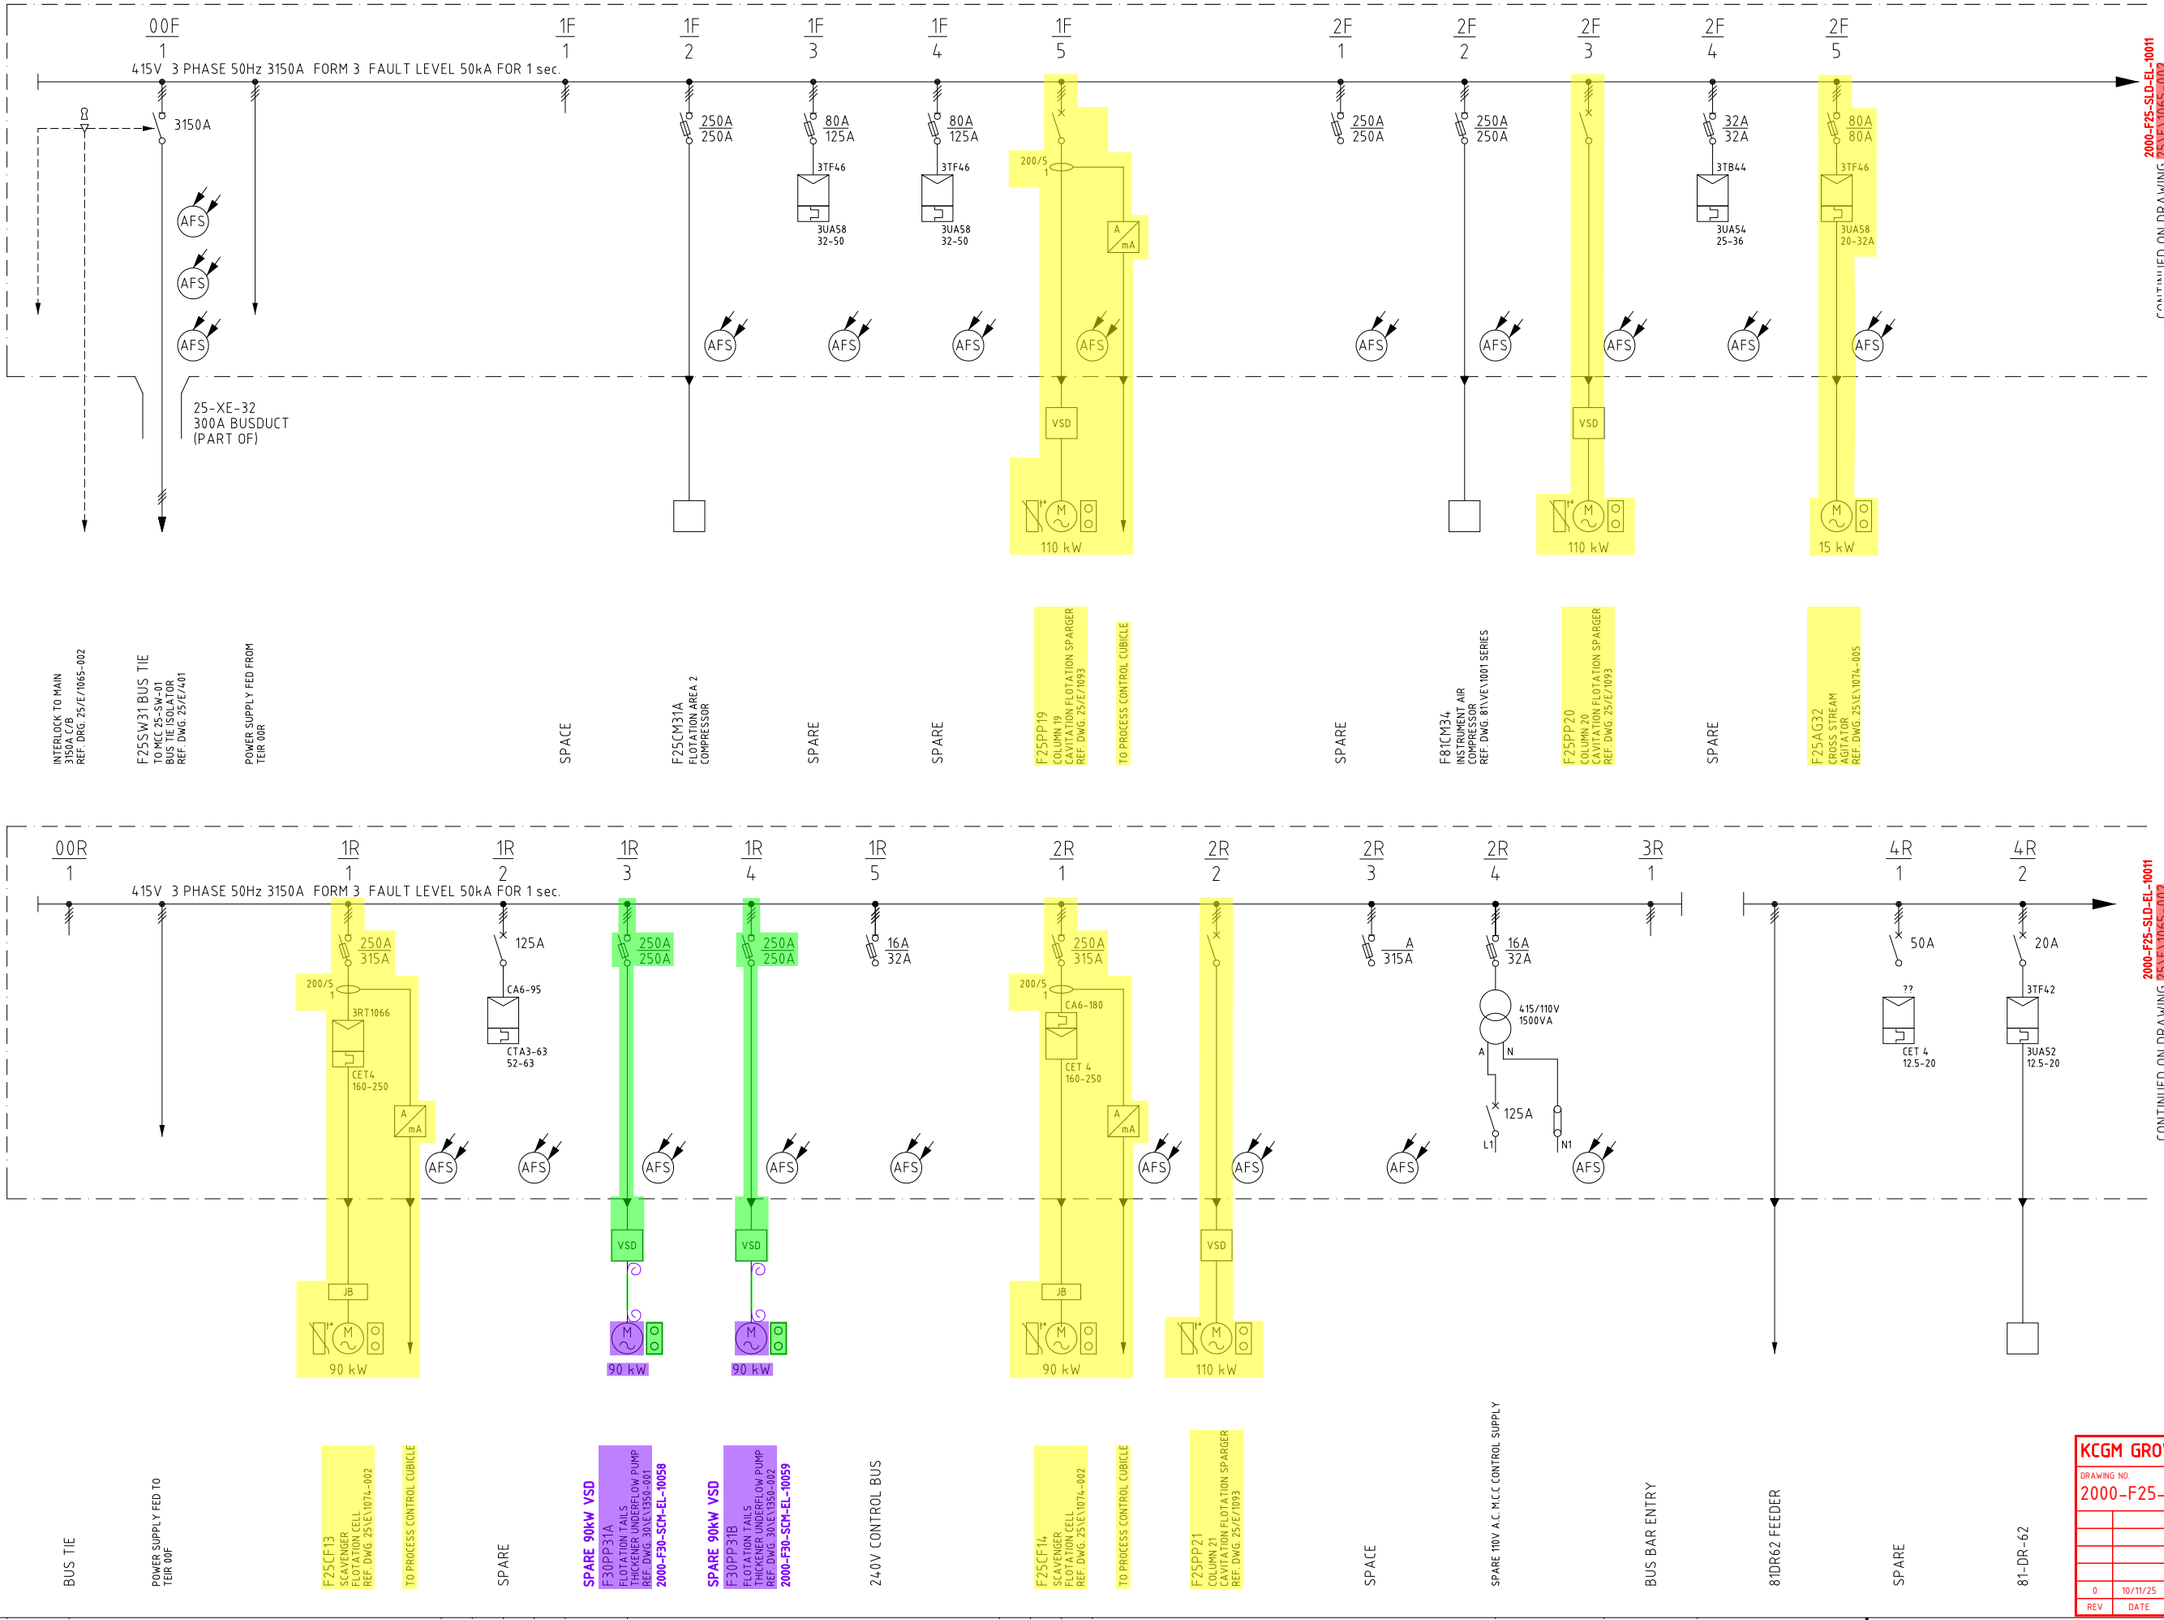


LEGEND

NORTHERN STAR RESOURCES LIMITED


Approved	X
Approved as Noted	
Not Approved	
For Information Only	

ACCEPTANCE DOES NOT RELIEVE THE SUPPLIER / CONTRACTOR OF ITS RESPONSIBILITY OR LIABILITIES UNDER THE PURCHASE ORDER / CONTRACT

LOCATION

SUB STATION 6

25-SW-31

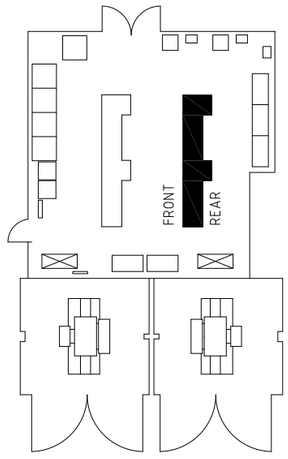

NOTES

1. ALL AFS (ARC FLASH SENSORS) ARE CONNECTED TO THE ARC FLASH RELAY VIA I/O UNITS

LEGEND

- EXISTING
- NON-EXISTENT
- STAGE 1 - NEW
- STAGE 1 - REMOVE
- STAGE 1 - DECOMMISSIONED (OTHERS)
- STAGE 2 - NEW
- STAGE 2 - REMOVE
- STAGE 2 - DECOMMISSIONED (OTHERS)

KCGM GROWTH PROJECT

DRAWING NO.
2000-F25-SLD-EL-10010

REV	DATE	DESCRIPTION	CHECK	TECH APP
0	10/11/25	APPROVED FOR CONSTRUCTION		DM

2000-F25-SLD-EL-10010_Rev0

25-SW-31 sub no. 6 415V MCC 25-SW-31 single line diagram