
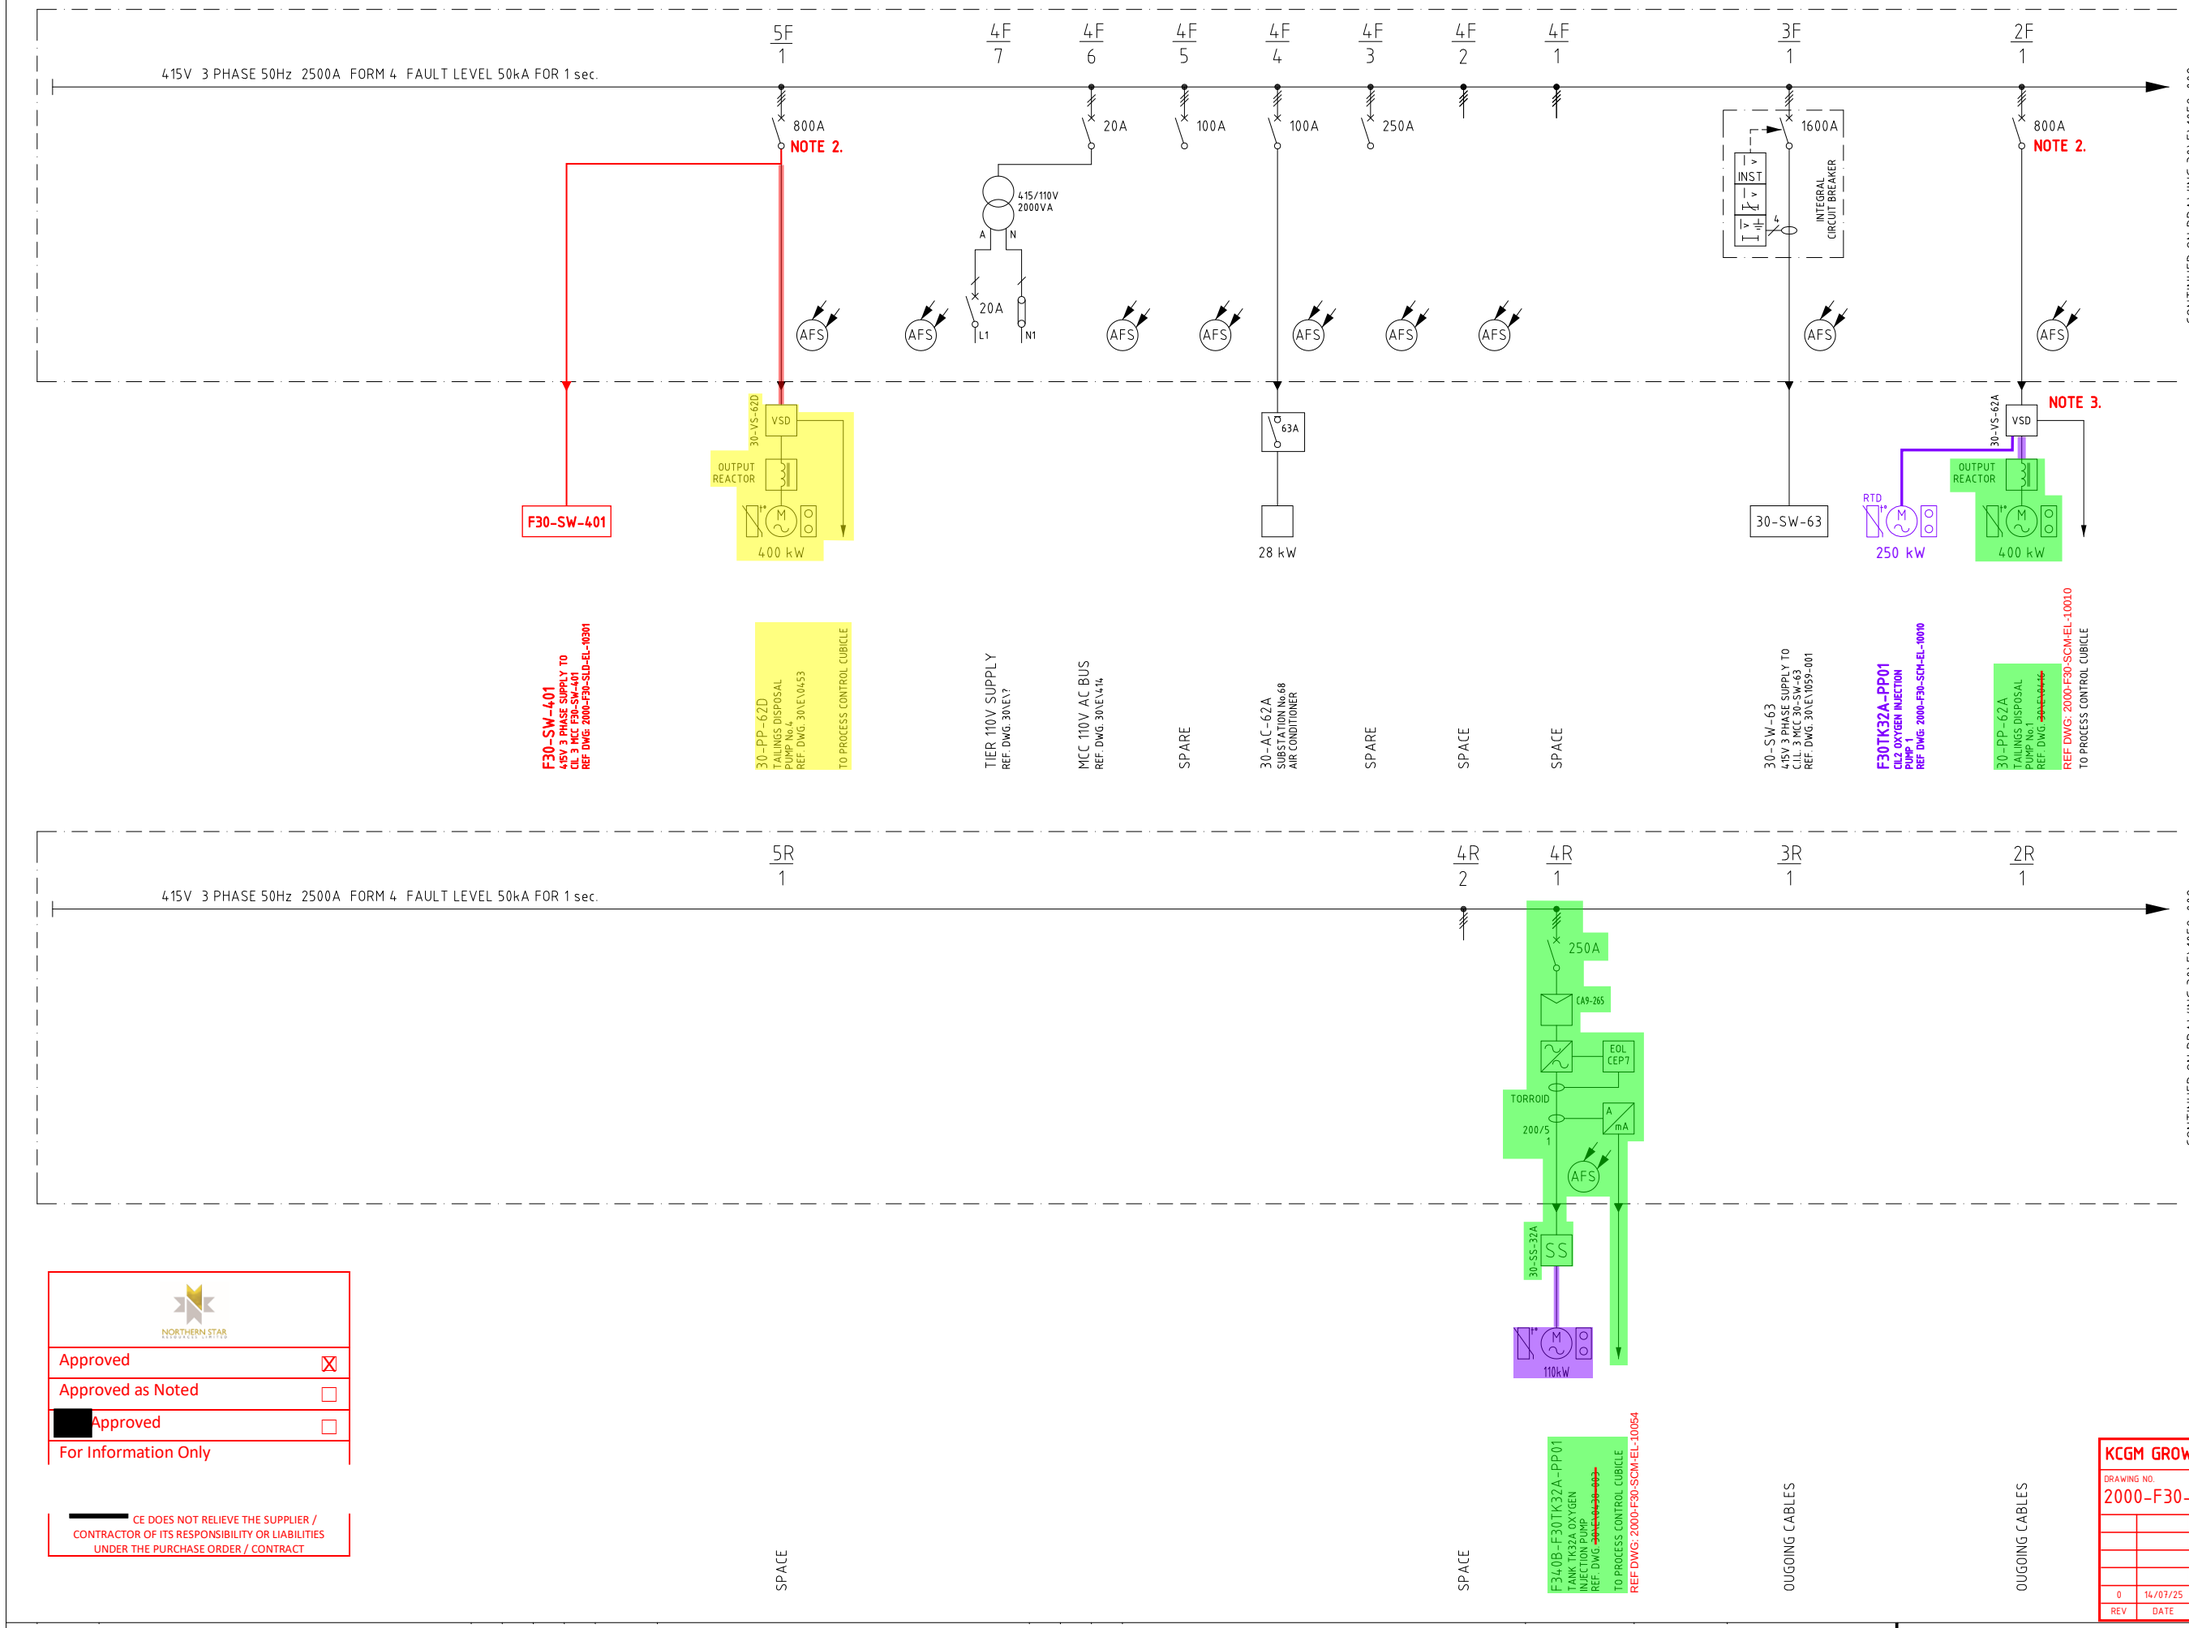



LEGEND

LOCATION

SUB STATION 68

30-SW-62

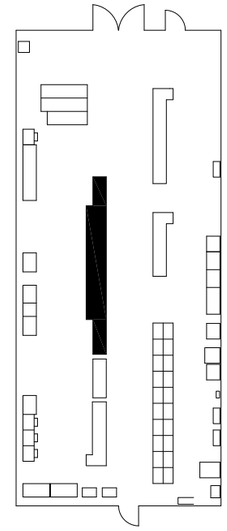

NOTES

1. ALL AFS (ARC FLASH SENSORS) ARE CONNECTED TO THE ARC FLASH RELAY VIA I/O UNITS
2. MCC FEEDER RE-PURPOSED AS PART OF THE KCGM GROWTH PROJECT.
3. VSD RE-PURPOSED AS PART OF THE KCGM GROWTH PROJECT.

LEGEND

- STAGE 1 - NEW
- STAGE 1 - REMOVE
- STAGE 1 - DECOMMISSIONED (OTHERS)
- STAGE 2 - NEW
- STAGE 2 - REMOVE
- STAGE 2 - DECOMMISSIONED (OTHERS)

NORTHERN STAR

| | |
|---|---|
| Approved | [X] |
| Approved as Noted | [ ] |
| [redacted] Approved | [ ] |
| For Information Only | |

[redacted] CE DOES NOT RELIEVE THE SUPPLIER / CONTRACTOR OF ITS RESPONSIBILITY OR LIABILITIES UNDER THE PURCHASE ORDER / CONTRACT

KCGM GROWTH PROJECT

DRAWING NO.
2000-F30-SLD-EL-10101

| REV | DATE | DESCRIPTION | CHECK | TECH APP |
|---|---|---|---|---|
| 0 | 14/07/25 | APPROVED FOR CONSTRUCTION | [redacted] | MB/DM |

# 2000-F30-SLD-EL-10101_Rev0

Carbon in leach (CIL3) substation no. 68 MCC 30-SW-62 single line diagram