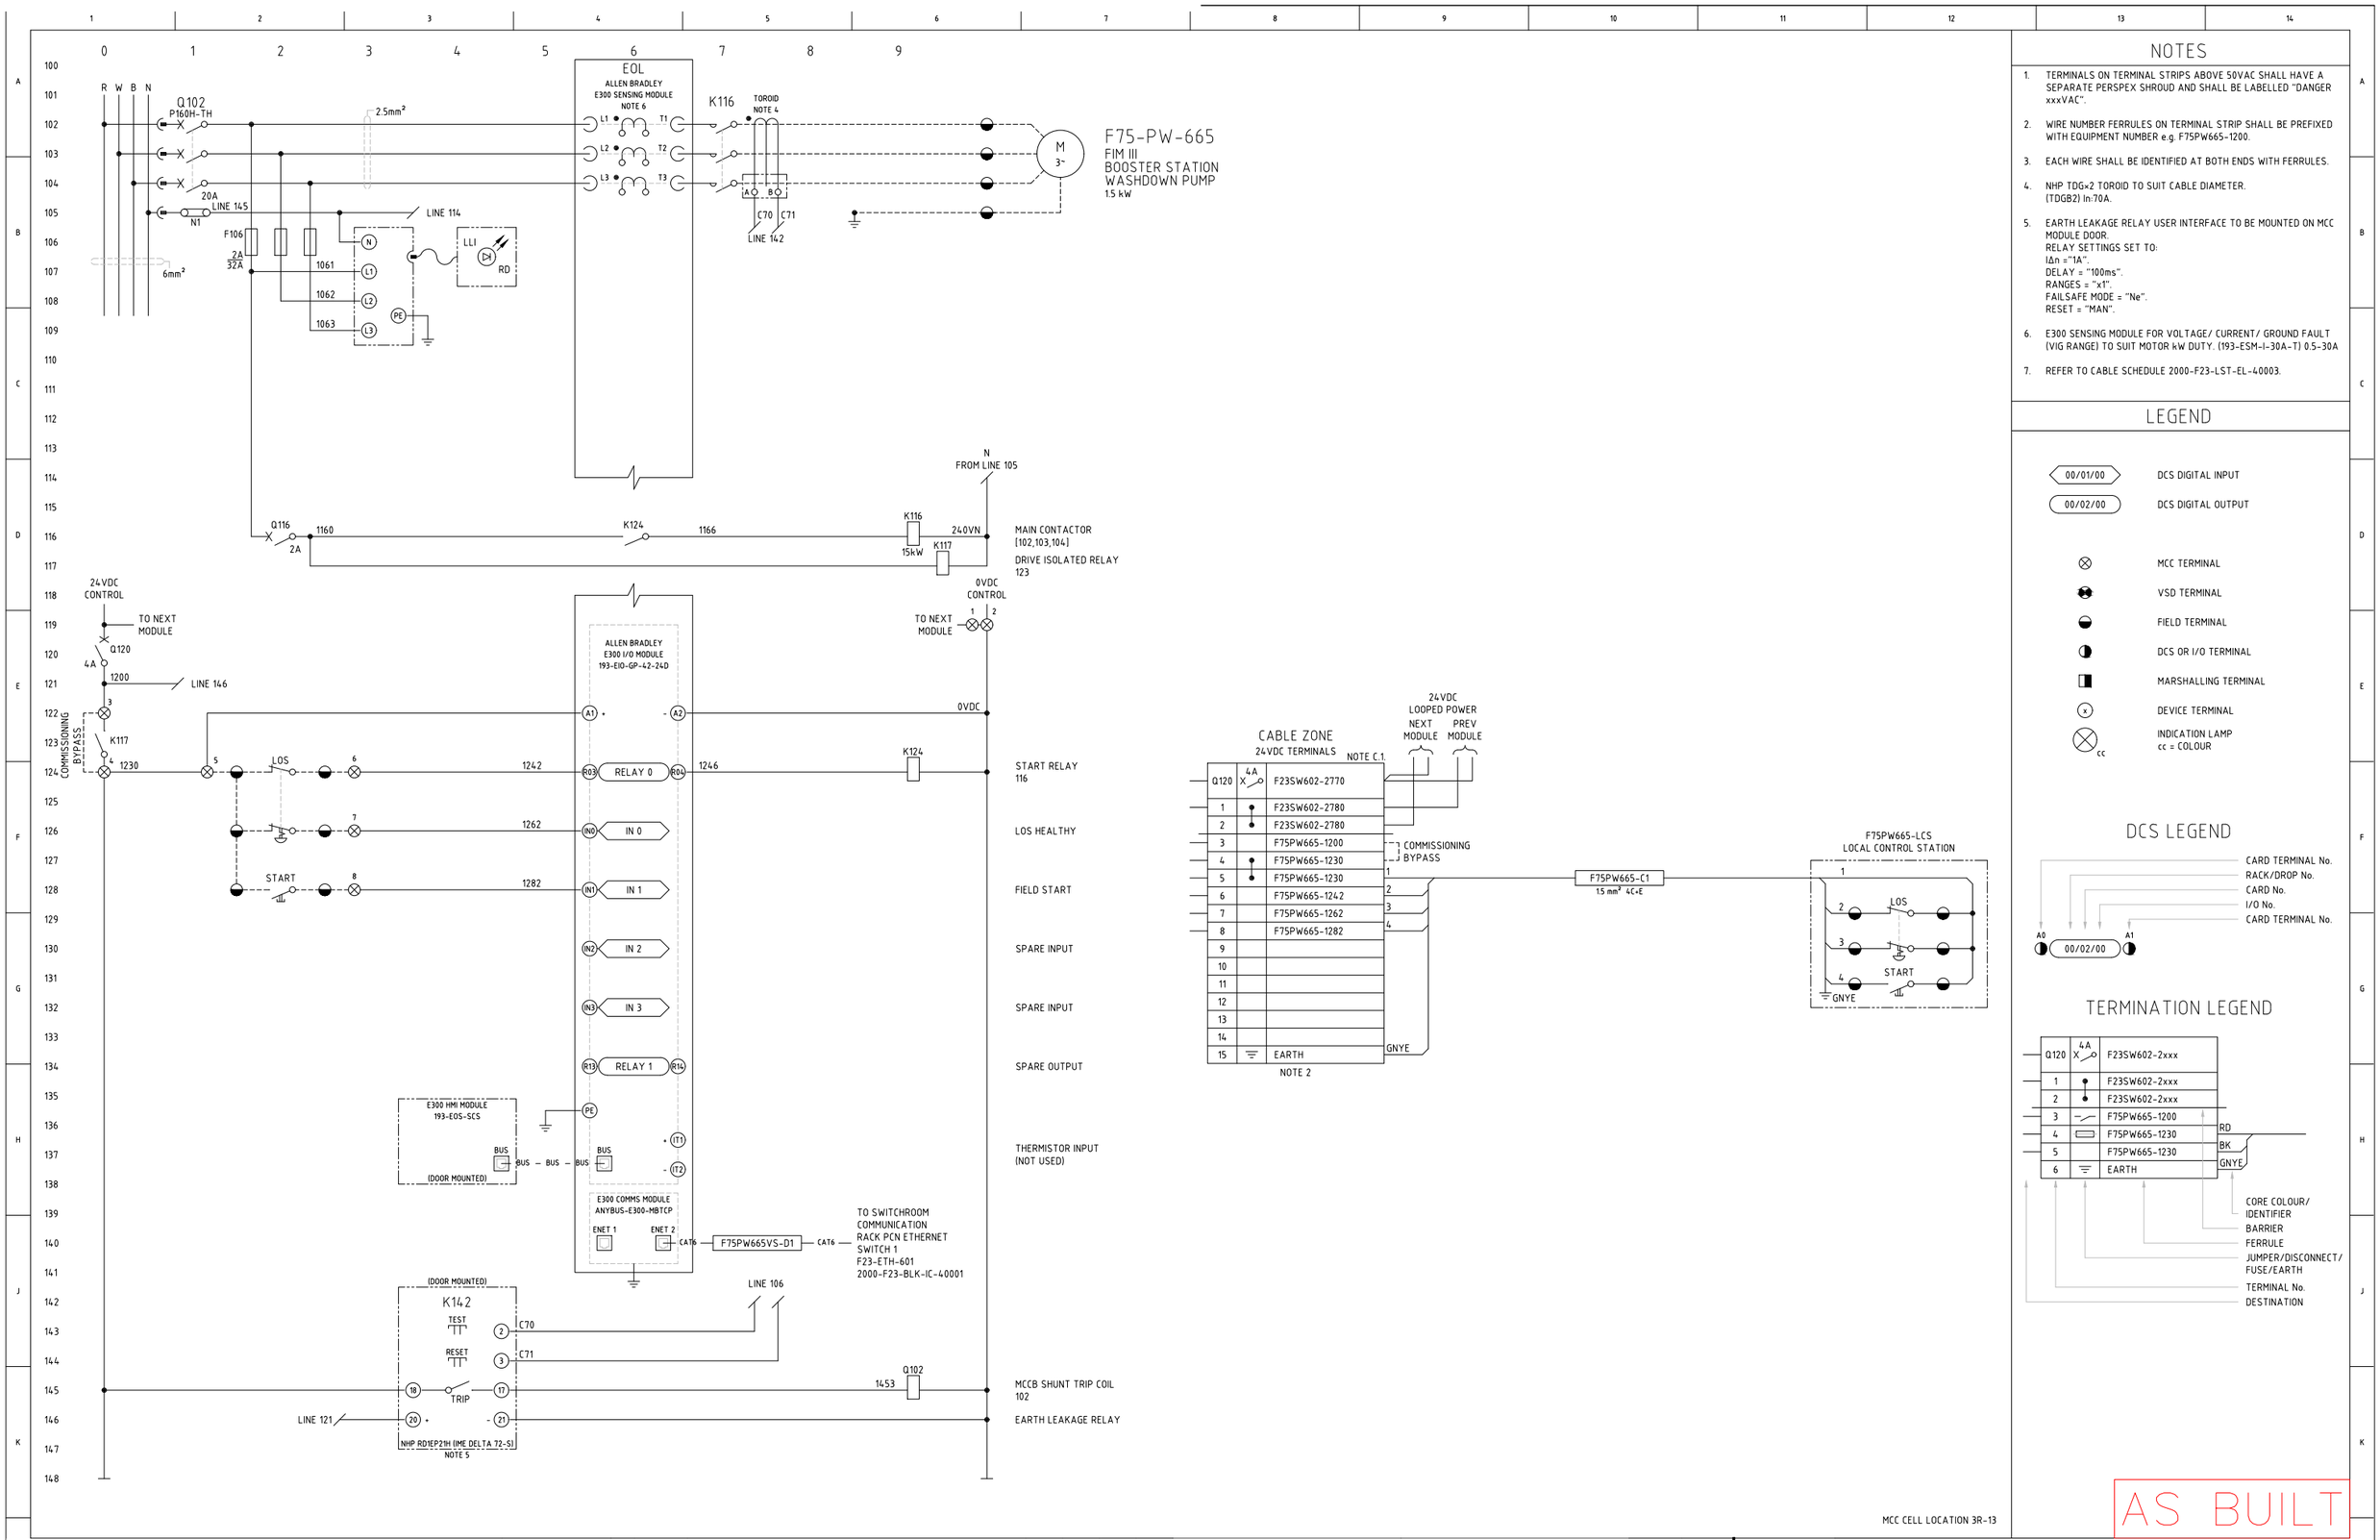


NOTES

1. TERMINALS ON TERMINAL STRIPS ABOVE 50VAC SHALL HAVE A SEPARATE PERSPEX SHROUD AND SHALL BE LABELLED "DANGER xxxVAC".
2. WIRE NUMBER FERRULES ON TERMINAL STRIP SHALL BE PREFIXED WITH EQUIPMENT NUMBER e.g. F75PW665-1200.
3. EACH WIRE SHALL BE IDENTIFIED AT BOTH ENDS WITH FERRULES.
4. NHP TDG×2 TOROID TO SUIT CABLE DIAMETER. (TDGB2) In:70A.
5. EARTH LEAKAGE RELAY USER INTERFACE TO BE MOUNTED ON MCC MODULE DOOR.
   RELAY SETTINGS SET TO:
   IΔn ="1A".
   DELAY = "100ms".
   RANGES = "x1".
   FAILSAFE MODE = "Ne".
   RESET = "MAN".
6. E300 SENSING MODULE FOR VOLTAGE/ CURRENT/ GROUND FAULT (VIG RANGE) TO SUIT MOTOR kW DUTY. (193-ESM-I-30A-T) 0.5-30A
7. REFER TO CABLE SCHEDULE 2000-F23-LST-EL-40003.

LEGEND

- 00/01/00 — DCS DIGITAL INPUT
- 00/02/00 — DCS DIGITAL OUTPUT
- ⊗ — MCC TERMINAL
- ◓ — VSD TERMINAL
- ◒ — FIELD TERMINAL
- ◑ — DCS OR I/O TERMINAL
- ◧ — MARSHALLING TERMINAL
- ⓧ — DEVICE TERMINAL
- ⊗cc — INDICATION LAMP, cc = COLOUR

DCS LEGEND

TERMINATION LEGEND

AS BUILT

2000-F75-SCM-EL-40005_Rev2

FIM III booster station F75-PW-665 FIM III booster station washdown pump control schematic diagram