
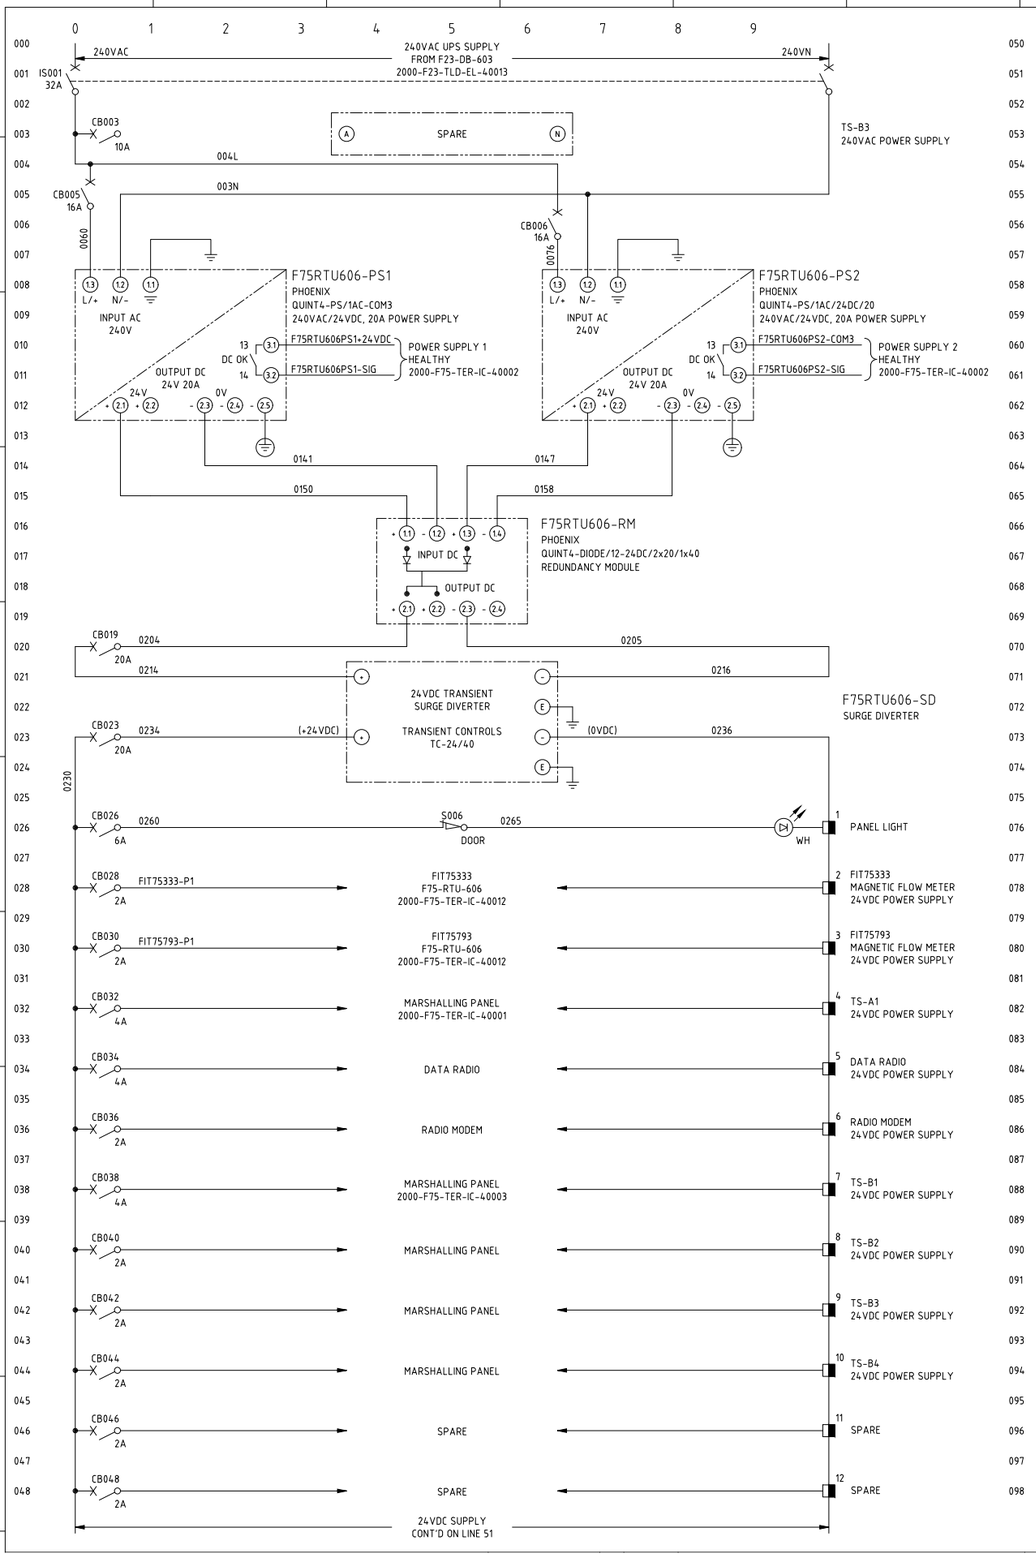


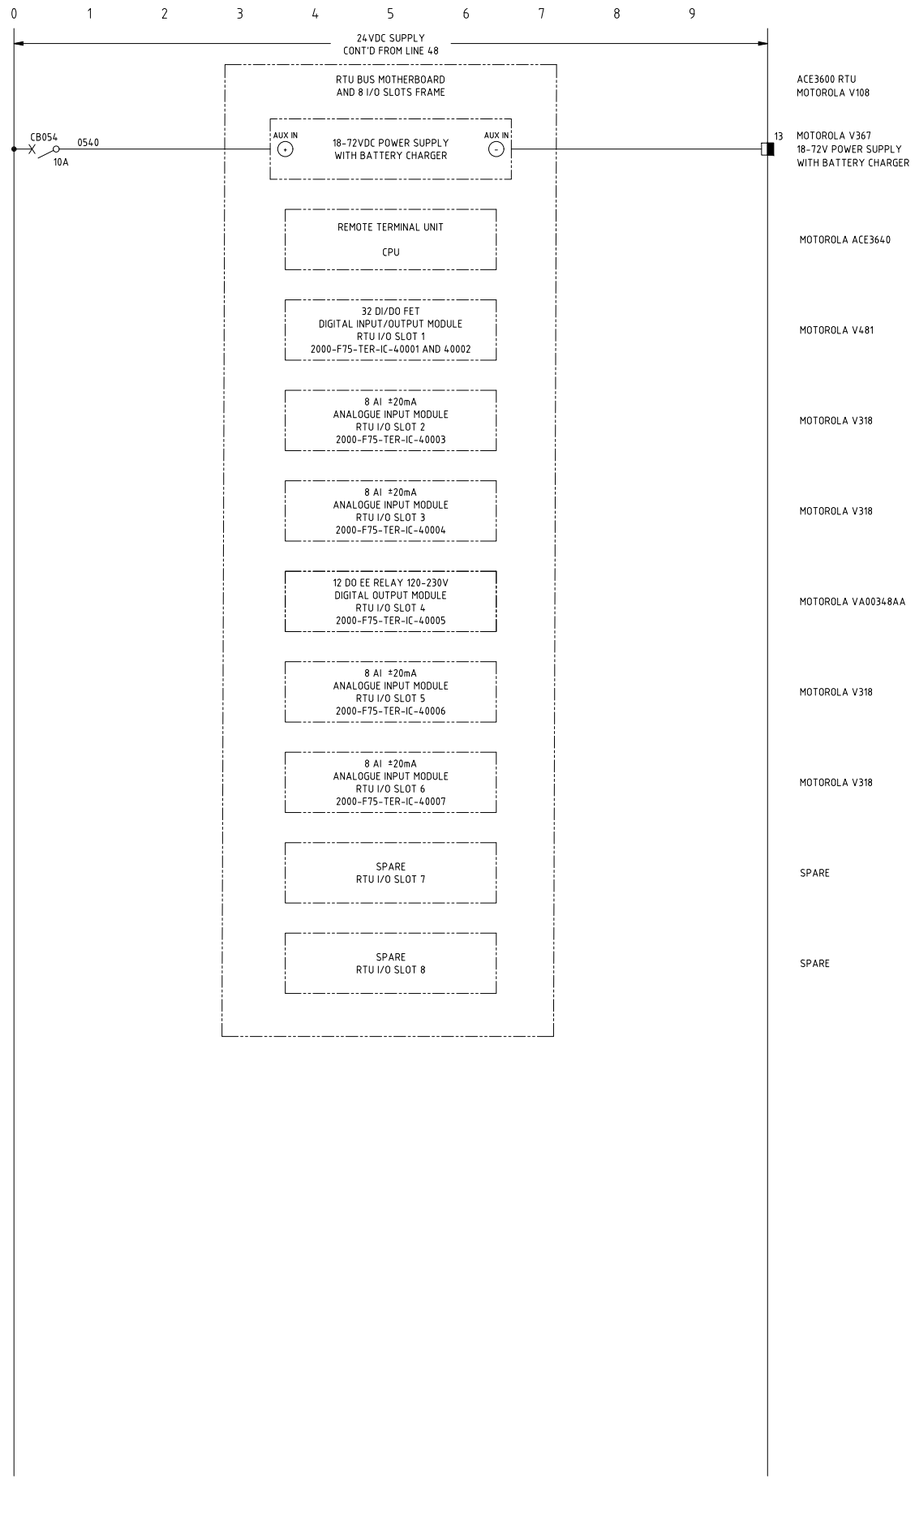

NOTES

1. TERMINALS ON TERMINAL STRIPS ABOVE 50VAC SHALL HAVE A SEPARATE PERSPEX SHROUD AND SHALL BE LABELLED "DANGER xxxVAC".
2. WIRE NUMBER FERRULES ON TERMINAL STRIP SHALL BE PREFIXED WITH EQUIPMENT NUMBER e.g. FxxPPxxx-1200.
3. EACH WIRE SHALL BE IDENTIFIED AT BOTH ENDS WITH FERRULES.
4. FOR NETWORK CONNECTION DETAILS REFER TO:
   F23-SR-601 SWITCHROOM COMMUNICATIONS BLOCK DIAGRAM
   2000-F23-BLK-IC-40001.

LEGEND

- FIELD TERMINAL
- DCS OR I/O TERMINAL
- MARSHALLING TERMINAL
- DEVICE TERMINAL (x)
- INDICATION LAMP (cc = COLOUR)
- EARTH BAR
- INSTRUMENT EARTH BAR (IEB)

AS BUILT

2000-F75-SCM-IC-40002_Rev3

Rtu cabinet schemtatic diagram