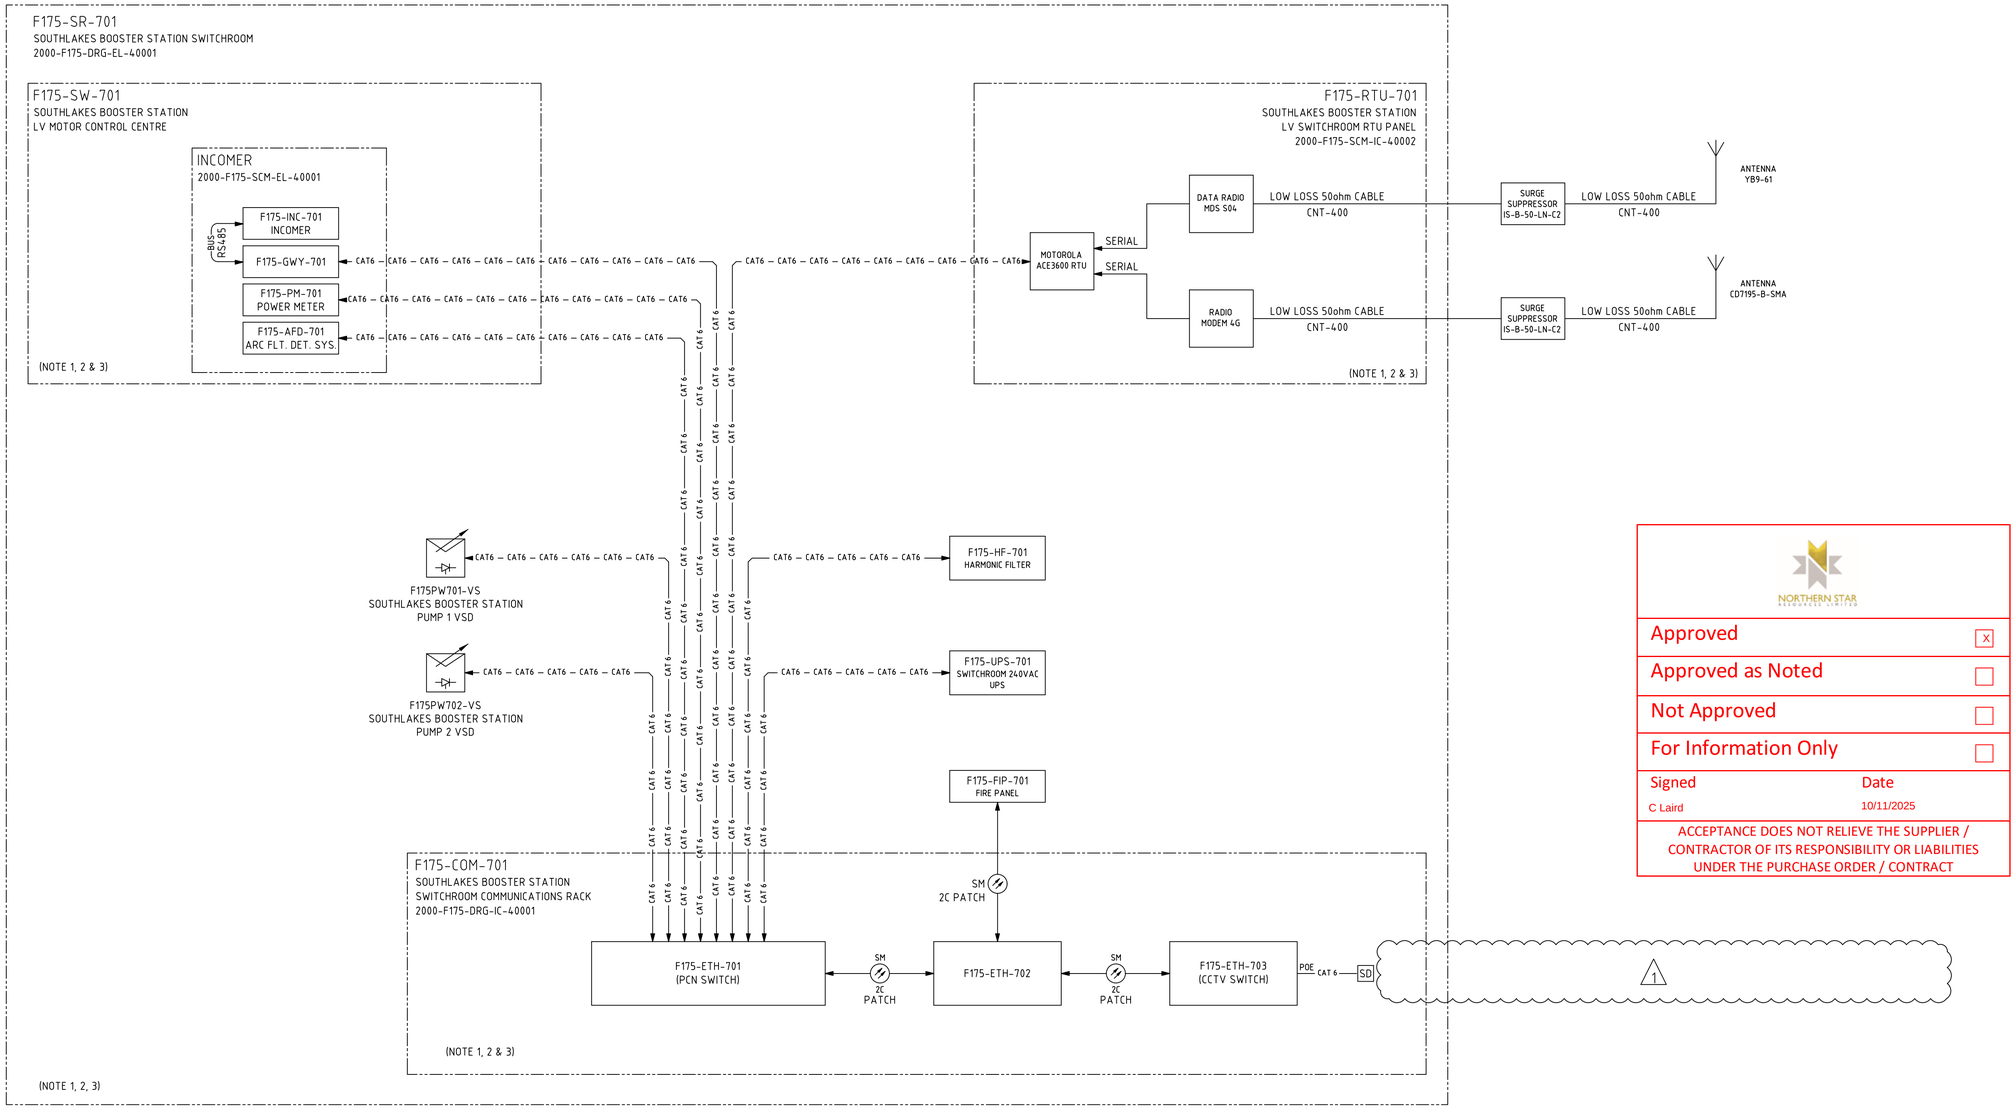


NOTES

1. FOR INTERNAL FIBRE OPTIC, CAT6 PATCH LEAD (& STACK CABLING IN SWITCHROOM COMMS CABINETS) EQUIPMENT CONNECTION DETAILS REFER TO SPECIFIC TERMINATION DIAGRAMS.
2. REFER TO SPECIFIC COMMUNICATIONS TERMINATION DRAWINGS FOR EXTERNAL EQUIPMENT CONNECTION DETAIL.
3. COMMS CABINET, RTU PANEL, MCC & SWITCHBOARD HARDWARE/INTERCONNECTIONS (E.G. NIO NODE) & INTER-FOBOT PATCHING NOT SHOWN FOR CLARITY. REFER TO SPECIFIC COMMUNICATIONS TERMINATION DRGS FOR DETAIL.
4. CABLES RUN INDIVIDUALLY, REFER TO CABLE SCHEDULE 2000-F175-LST-EL-40003.

LEGEND

FOB	FIBRE OPTIC BREAK OUT TRAY
ETH	ETHERNET SWITCH HIRSCHMANN = DCS NETWORKS CISCO = ALL OTHER NETWORKS
FCS	YOKOGAWA FIELD CONTROL UNIT
xxxFCS4xx-NJxx U/D	YOKOGAWA NODE INTERFACE UNIT (DUAL OPTICAL ESB PORTS: U = UPLINK, D = DOWNLINK) TAG RELATED TO PARENT FCS
GWY	COMMUNICATIONS GATEWAY ANYBUS ABC3028
MC	FIBRE TO CAT6 MEDIA CONVERTER
xxx	EQUIPMENT OR VENDOR PACKAGE PANELS AS NOTED WITHIN BLOCK.
EOL	MCC MODULE DOL INTELLIGENT ELECTRONIC DEVICE/OVERLOAD
UPS	UNINTERRUPTIBLE POWER SUPPLY
	VSD - VARIABLE SPEED DRIVE
	MULTI CORE FIBRE OPTIC CABLE OR DUPLEX PATCH LEAD
— CAT6 — CAT6 —	CAT6 ETHERNET CABLE CONNECTION
xxx-CAM-xxx PTZ	CCTV CAMERA Z = FIXED (ZOOM ONLY) PTZ = PAN/TILT/ZOOM
SD	COMMS SURGE DIVERTER DEVICE
POE	POWER OVER ETHERNET PORT

NORTHERN STAR RESOURCES LIMITED

Approved	X
Approved as Noted	
Not Approved	
For Information Only	

Signed: C Laird — Date: 10/11/2025

ACCEPTANCE DOES NOT RELIEVE THE SUPPLIER / CONTRACTOR OF ITS RESPONSIBILITY OR LIABILITIES UNDER THE PURCHASE ORDER / CONTRACT

APPROVED FOR CONSTRUCTION

REFERENCES	DWG No	REV	DATE	REVISION	DRN	CHK	TECH APP	APP
GENERAL NOTES AND STANDARD DRAWINGS INDEX	2000-F00-STD-EL-10001	1	22.OCT.25	RE-APPROVED FOR CONSTRUCTION	TG	DS	DS	DS
		0	15.MAY.25	APPROVED FOR CONSTRUCTION				

NORTHERN STAR RESOURCES LIMITED

DRA PACIFIC (PTY) LIMITED

	T.GROOM	13.MAR.2025
CHECKED	C. BUBB	14.APR.2025
DESIGNED	C. BUBB	14.APR.2025
TECH APP	K. VAN NAMEN	14.APR.2025
APP	T HAMDORF	15.MAY.2025
CLIENT APP		

PROJECT: KCGM FIM TSF PROJECT

TITLE: SOUTHLAKES BOOSTER STATION F175-SR-701 LV SWITCHROOM COMMUNICATIONS BLOCK DIAGRAM

A1 | SCALE NTS | DRG No. 2000-F175-BLK-IC-40001 | REV 1