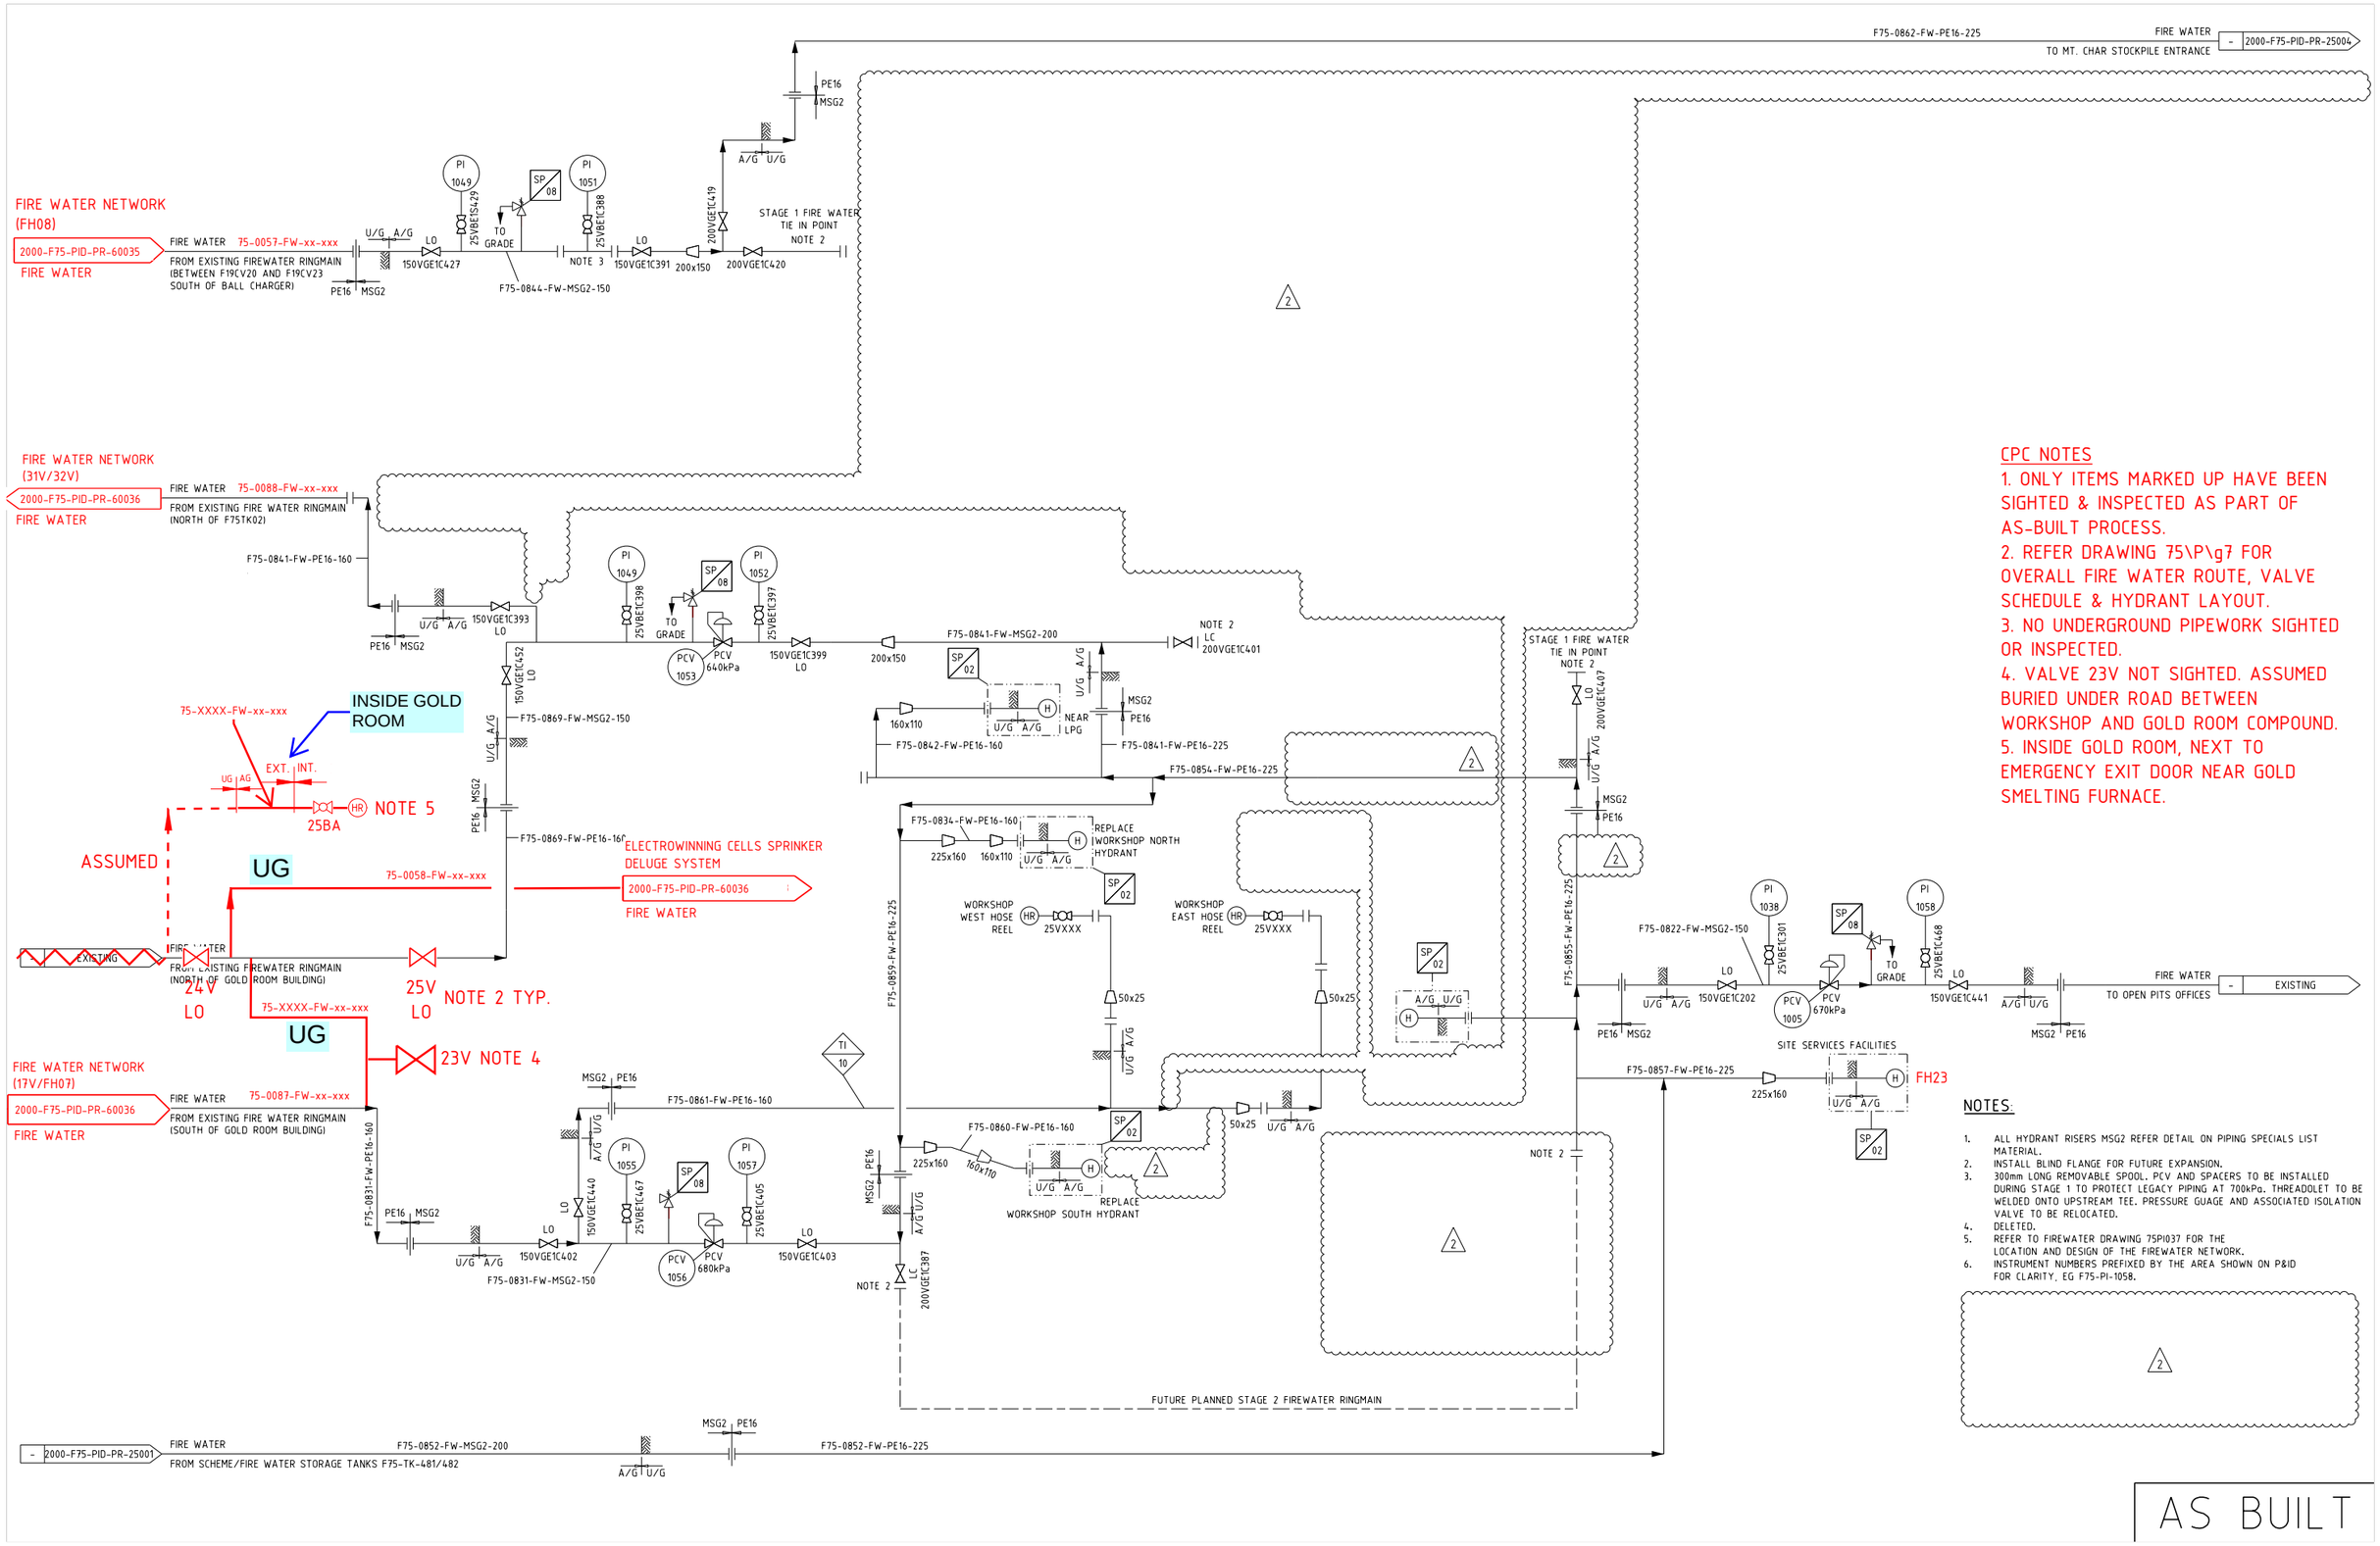


CPC NOTES

1. ONLY ITEMS MARKED UP HAVE BEEN SIGHTED & INSPECTED AS PART OF AS-BUILT PROCESS.
2. REFER DRAWING 75\P\g7 FOR OVERALL FIRE WATER ROUTE, VALVE SCHEDULE & HYDRANT LAYOUT.
3. NO UNDERGROUND PIPEWORK SIGHTED OR INSPECTED.
4. VALVE 23V NOT SIGHTED. ASSUMED BURIED UNDER ROAD BETWEEN WORKSHOP AND GOLD ROOM COMPOUND.
5. INSIDE GOLD ROOM, NEXT TO EMERGENCY EXIT DOOR NEAR GOLD SMELTING FURNACE.

NOTES:

1. ALL HYDRANT RISERS MSG2 REFER DETAIL ON PIPING SPECIALS LIST MATERIAL.
2. INSTALL BLIND FLANGE FOR FUTURE EXPANSION.
3. 300mm LONG REMOVABLE SPOOL. PCV AND SPACERS TO BE INSTALLED DURING STAGE 1 TO PROTECT LEGACY PIPING AT 700kPa. THREADOLET TO BE WELDED ONTO UPSTREAM TEE. PRESSURE GUAGE AND ASSOCIATED ISOLATION VALVE TO BE RELOCATED.
4. DELETED.
5. REFER TO FIREWATER DRAWING 75PI037 FOR THE LOCATION AND DESIGN OF THE FIREWATER NETWORK.
6. INSTRUMENT NUMBERS PREFIXED BY THE AREA SHOWN ON P&ID FOR CLARITY. EG F75-PI-1058.

AS BUILT