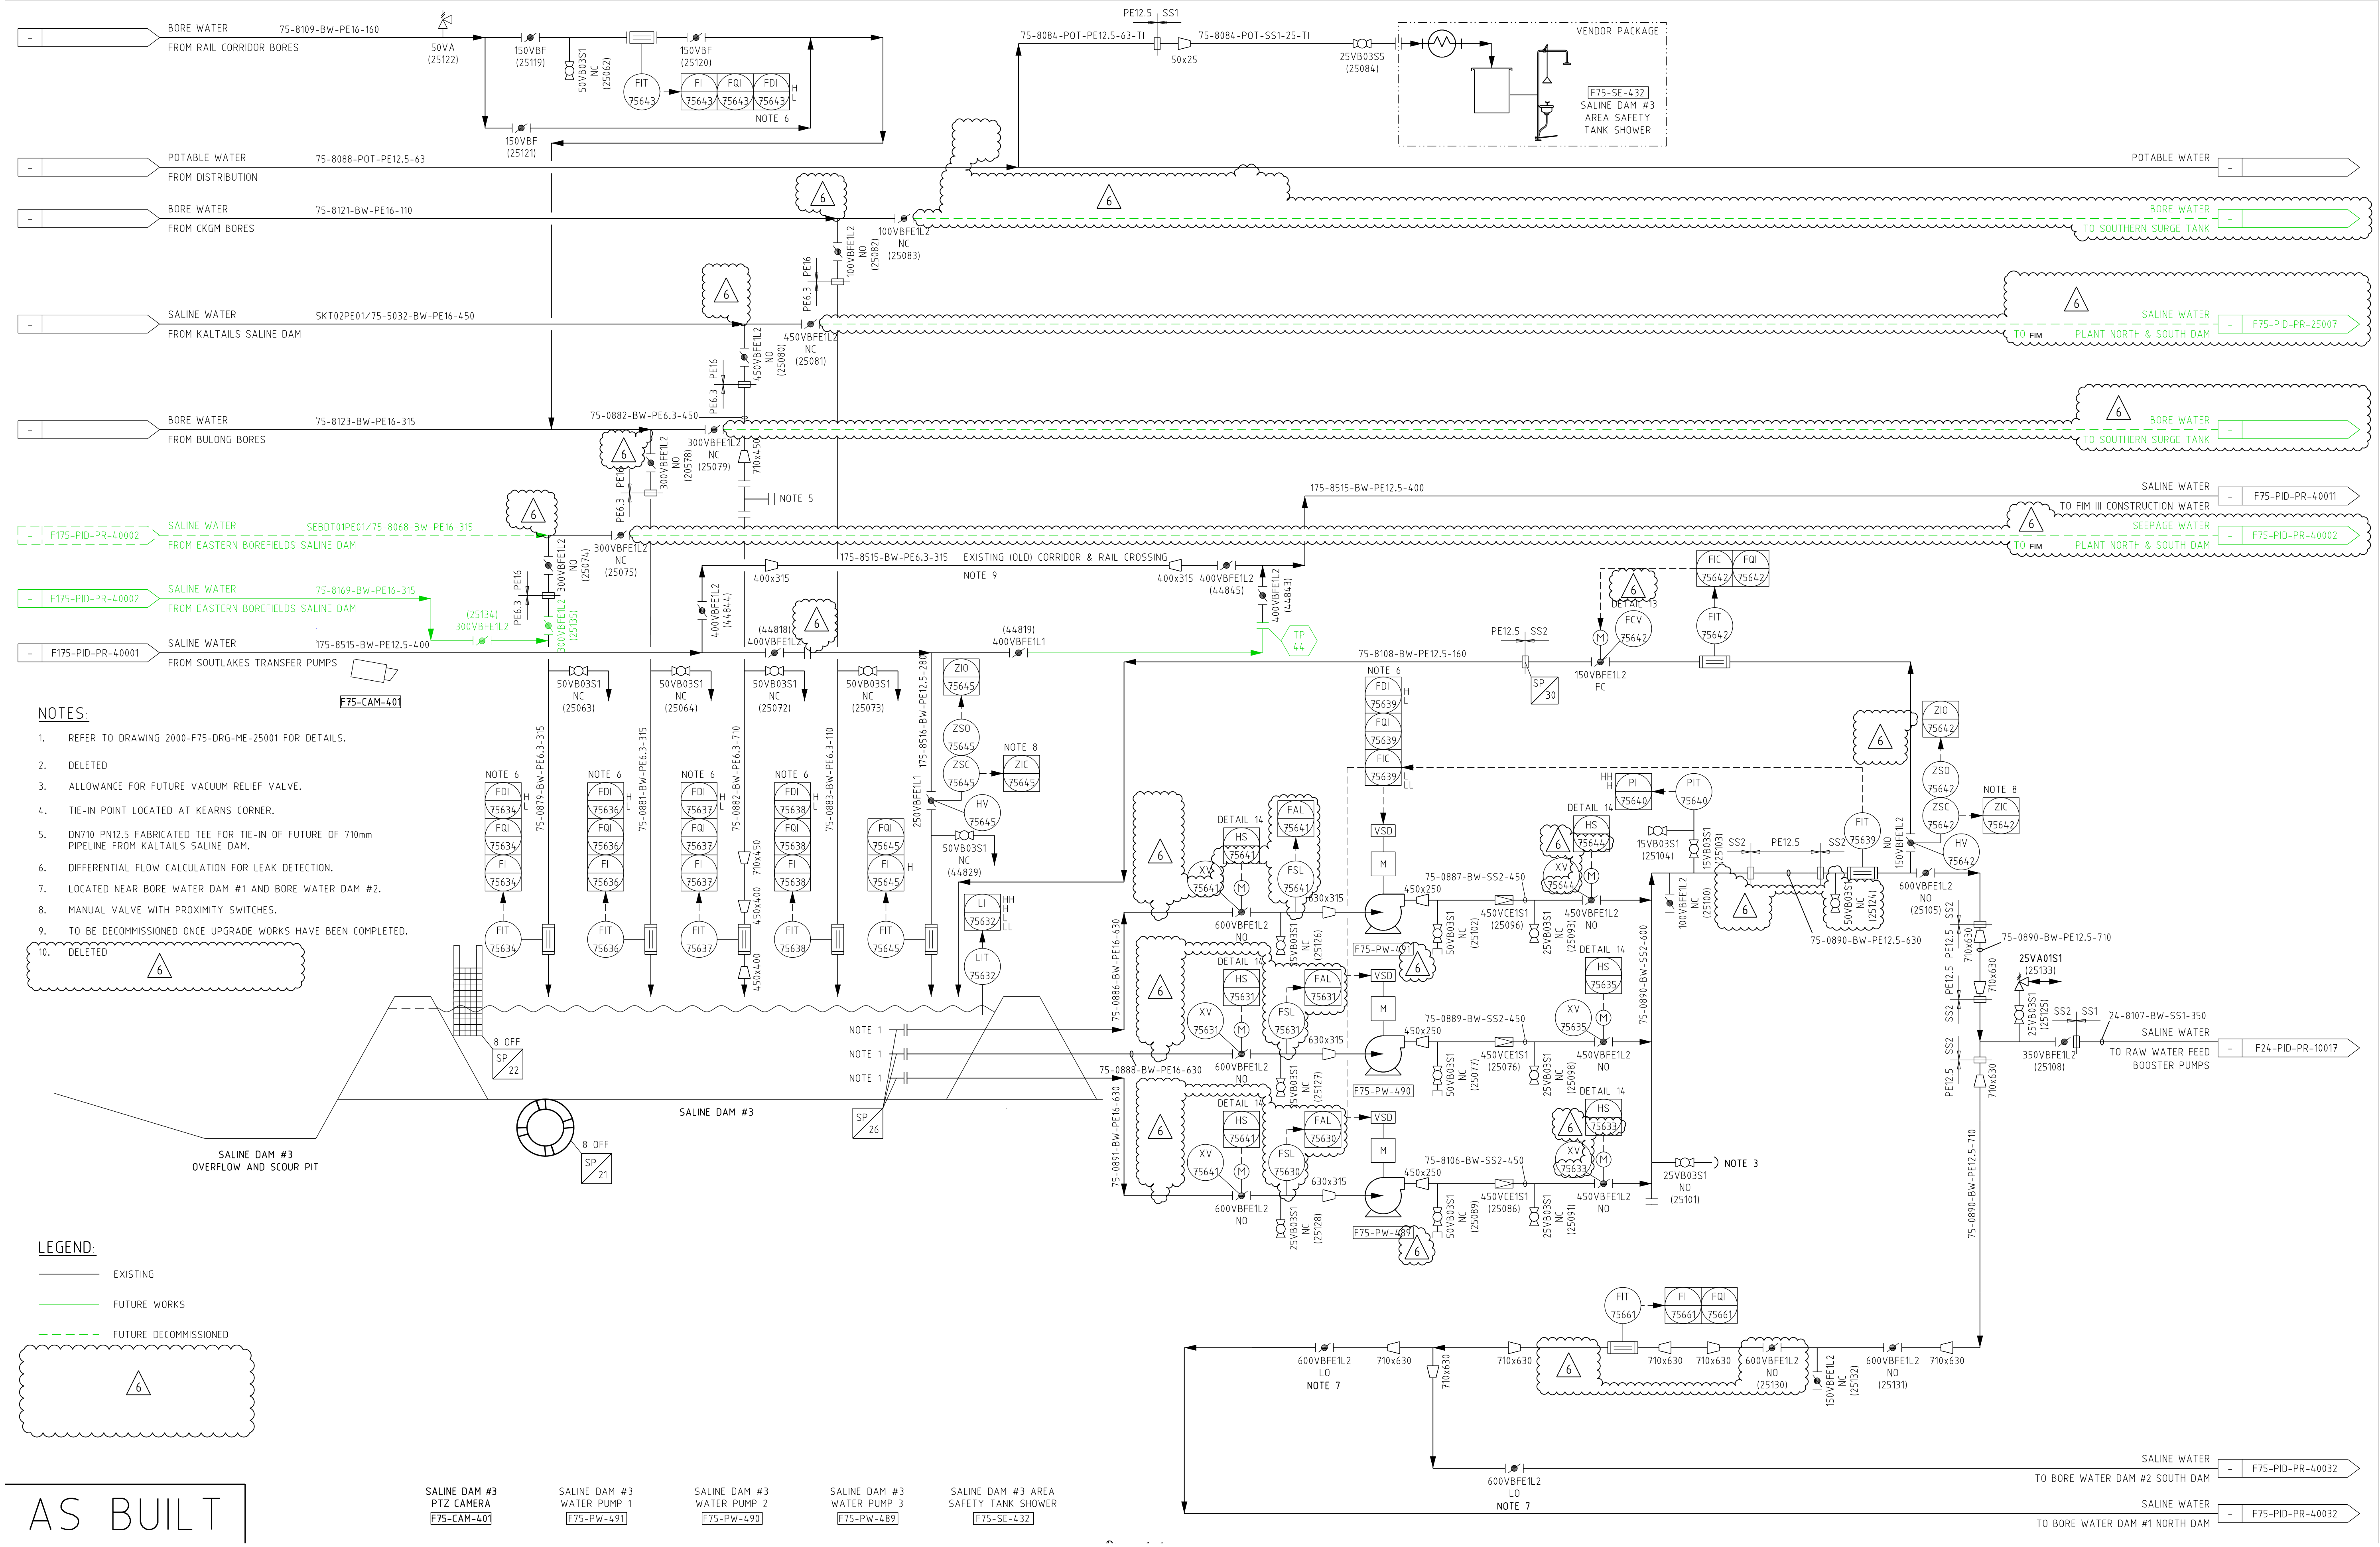

NOTES:

1. REFER TO DRAWING 2000-F75-DRG-ME-25001 FOR DETAILS.
2. DELETED
3. ALLOWANCE FOR FUTURE VACUUM RELIEF VALVE.
4. TIE-IN POINT LOCATED AT KEARNS CORNER.
5. DN710 PN12.5 FABRICATED TEE FOR TIE-IN OF FUTURE OF 710mm PIPELINE FROM KALTAILS SALINE DAM.
6. DIFFERENTIAL FLOW CALCULATION FOR LEAK DETECTION.
7. LOCATED NEAR BORE WATER DAM #1 AND BORE WATER DAM #2.
8. MANUAL VALVE WITH PROXIMITY SWITCHES.
9. TO BE DECOMMISSIONED ONCE UPGRADE WORKS HAVE BEEN COMPLETED.
10. DELETED 6

LEGEND:

EXISTING

FUTURE WORKS

FUTURE DECOMMISSIONED

6

AS BUILT

SALINE DAM #3
PTZ CAMERA
F75-CAM-401

SALINE DAM #3
WATER PUMP 1
F75-PW-491

SALINE DAM #3
WATER PUMP 2
F75-PW-490

SALINE DAM #3
WATER PUMP 3
F75-PW-489

SALINE DAM #3 AREA
SAFETY TANK SHOWER
F75-SE-432