
240VAC UPS SUPPLY
FROM F175-DB-702
2000-F175-TLD-EL-40002

240VAC UPS SUPPLY
FROM F175-DB-702
2000-F175-TLD-EL-40002

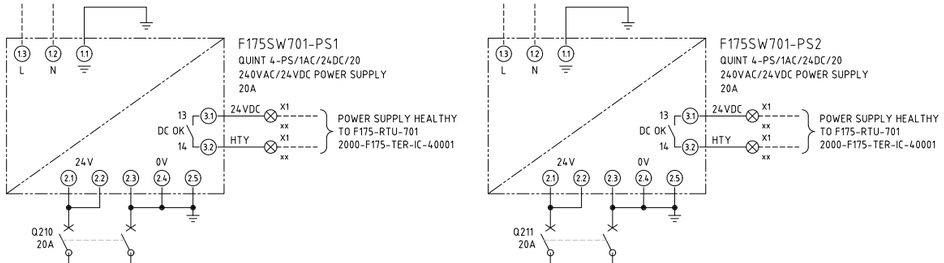

2121

2130

24VDC

0VDC

Q224 2240
2250
10A
TIER 02F-01
24VDC CONTROL SUPPLY

TIER 02F-01

TO LINE 274

TO LINE 275

INCOMER TIER 00F
(FRONT)

Q229 2290
2300
10A
INCOMER TIER 00F
24VDC CONTROL SUPPLY

TO LINE 272

TO LINE 235

TO LINE 228

TO LINE 229

Q274 2740
2750
10A
TIER 02R-01
24VDC CONTROL SUPPLY

TIER 02R-01

Q276 2760
2770
10A
TIER 01R-01
24VDC CONTROL SUPPLY

TIER 01R-01

1

NOTES

1. TERMINALS ON TERMINAL STRIPS ABOVE 50VAC SHALL HAVE A SEPARATE PERSPEX SHROUD AND SHALL BE LABELLED "DANGER xxxVAC".
2. WIRE NUMBER FERRULES ON TERMINAL STRIP SHALL BE PREFIXED WITH EQUIPMENT NUMBER e.g. F175SW701-1200.
3. EACH WIRE SHALL BE IDENTIFIED AT BOTH ENDS WITH FERRULES.

LEGEND

- 00/01/00 — DCS DIGITAL INPUT
- 00/02/00 — DCS DIGITAL OUTPUT
- MCC TERMINAL
- VSD TERMINAL
- FIELD TERMINAL
- DCS OR I/O TERMINAL
- MARSHALLING TERMINAL
- DEVICE TERMINAL
- INDICATION LAMP (cc = COLOUR)

TERMINATION LEGEND

1	•	F175SW701-24VDC
2	•	F175SW701-24VDC
3	•	F175SW701-0VDC
4	•	F175SW701-0VDC
5	–/–	FxxCVxxx-1096
6	▭	FxxCVxxx-1106
7		FxxCVxxx-1116
8	⏚	EARTH

RD
BK
GNYE

CORE COLOUR/ IDENTIFIER
BARRIER
FERRULE
JUMPER/DISCONNECT/ FUSE/EARTH
TERMINAL No.
DESTINATION

NORTHERN STAR RESOURCES LIMITED

Approved [X]
Approved as Noted [ ]
[redacted] Approved [ ]
For Information Only [ ]
Sign C[redacted] 2[redacted]1/26

A[redacted] NOT RELIEVE THE SUPPLIER / CONTRACTOR OF ITS RESPONSIBILITY OR LIABILITIES UNDER THE PURCHASE ORDER / CONTRACT

APPROVED FOR CONSTRUCTION

REFERENCES	DWG No	REV	DATE	REVISION	DRN	CHK	TECH APP	PROJ APP
F175-DB-702 LV SWITCHROOM 240VAC UPS DB THREE LINE DIAGRAM	2000-F175-TLD-EL-40002							
F175-SW-701 LV MOTOR CONTROL CENTRE INCOMER SCHEMATIC DIAGRAM SHEET 2	2000-F175-SCM-EL-40002	1	07.JAN.26	RE-ISSUED FOR CONSTRUCTION	ET	MC	KV	TH
F175-SW-701 LV MOTOR CONTROL CENTRE SINGLE LINE DIAGRAM	2000-F175-SLD-EL-40001	0	21.MAY.25	APPROVED FOR CONSTRUCTION	TG	JYW	KVN	TH

DRA PACIFIC (PTY) LIMITED

DRAWN	T. GROOM	13.MAR.2025
CHECKED	J.Y. WEE	10.APR.2025
DESIGNED	J.Y. WEE	10.APR.2025
TECH APP	K. VAN NAMEN	10.APR.2025
PROJ APP	T. HAMDORF	21.MAY.2025
CLIENT APP		

PROJECT: KCGM
FIM TSF PROJECT

TITLE: SOUTHLAKES BOOSTER STATION
F175-SW-701 LV MCC 24VDC DISTRIBUTION
SCHEMATIC DIAGRAM

A1 | SCALE NTS | DRG No. 2000-F175-SCM-EL-40004 | REV 1