
Docusign Envelope ID: D3EAC8FF-146A-4610-AFF4-26203B4BB02C

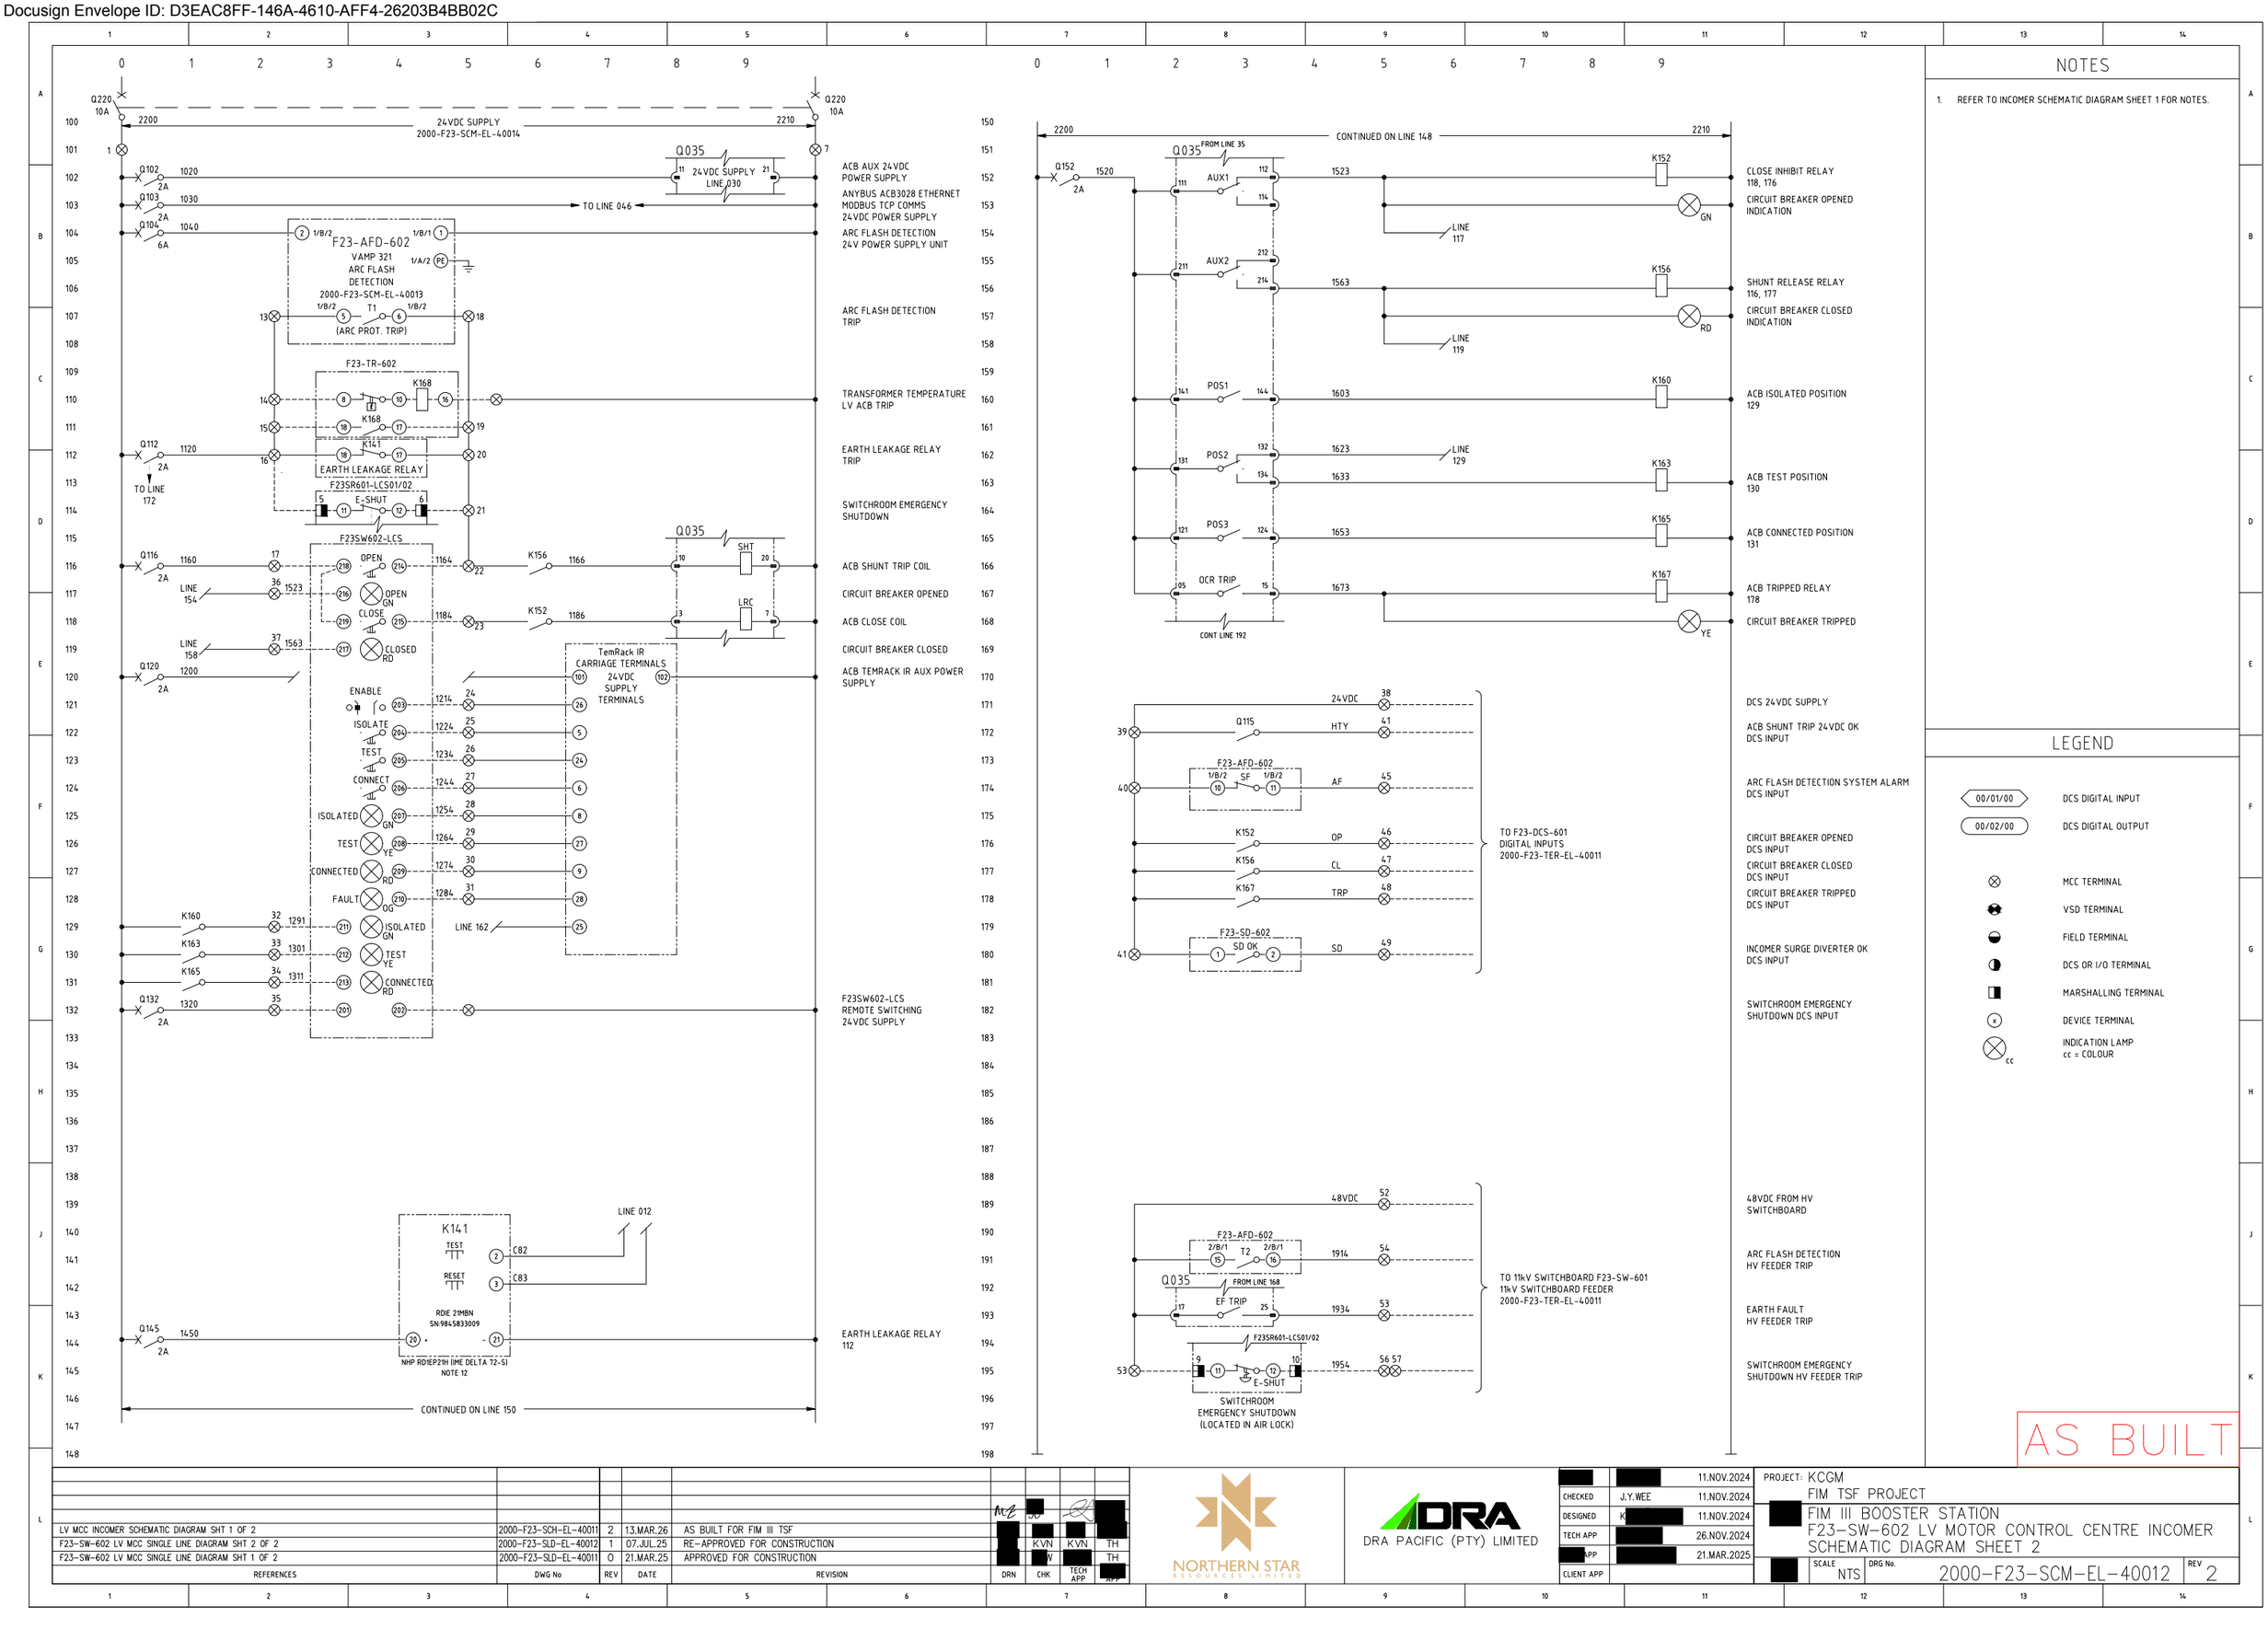

NOTES

1. REFER TO INCOMER SCHEMATIC DIAGRAM SHEET 1 FOR NOTES.

LEGEND

- 00/01/00 — DCS DIGITAL INPUT
- 00/02/00 — DCS DIGITAL OUTPUT
- MCC TERMINAL
- VSD TERMINAL
- FIELD TERMINAL
- DCS OR I/O TERMINAL
- MARSHALLING TERMINAL
- DEVICE TERMINAL
- INDICATION LAMP (cc = COLOUR)

AS BUILT

REFERENCES	DWG No	REV	DATE	REVISION	DRN	CHK	TECH APP	APP
LV MCC INCOMER SCHEMATIC DIAGRAM SHT 1 OF 2	2000-F23-SCH-EL-40011	2	13.MAR.26	AS BUILT FOR FIM III TSF	[redacted]	[redacted]	[redacted]	[redacted]
F23-SW-602 LV MCC SINGLE LINE DIAGRAM SHT 2 OF 2	2000-F23-SLD-EL-40012	1	07.JUL.25	RE-APPROVED FOR CONSTRUCTION		KVN	KVN	TH
F23-SW-602 LV MCC SINGLE LINE DIAGRAM SHT 1 OF 2	2000-F23-SLD-EL-40011	0	21.MAR.25	APPROVED FOR CONSTRUCTION		[redacted]	[redacted]	TH

NORTHERN STAR RESOURCES LIMITED

DRA PACIFIC (PTY) LIMITED

[redacted]	[redacted]	11.NOV.2024
CHECKED	J.Y.WEE	11.NOV.2024
DESIGNED	K[redacted]	11.NOV.2024
TECH APP	[redacted]	26.NOV.2024
[redacted] APP	[redacted]	21.MAR.2025
CLIENT APP		

PROJECT: KCGM
FIM TSF PROJECT
[redacted]
FIM III BOOSTER STATION
F23-SW-602 LV MOTOR CONTROL CENTRE INCOMER SCHEMATIC DIAGRAM SHEET 2

SCALE NTS | DRG No. 2000-F23-SCM-EL-40012 | REV 2