
Docusign Envelope ID: D3EAC8FF-146A-4610-AFF4-26203B4BB02C

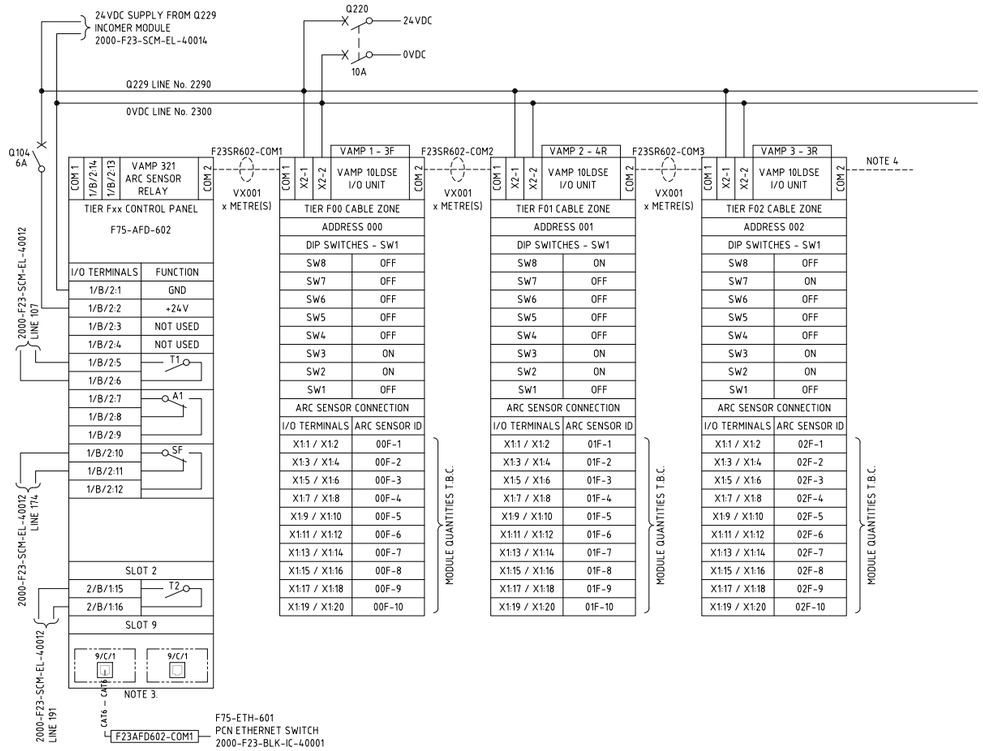

NOTES

1. CABLE NUMBER FOR ARC FLASH SENSOR VA1DA SHALL BE THE EQUIPMENT NUMBER FOLLOWED BY C FOR CONTROL AND A SEQUENTIAL NUMBER e.g. F23SW602-COMx.
2. EACH CABLE SHALL BE IDENTIFIED AT BOTH ENDS WITH CABLE NUMBER.
3. VAMP 321 ARC FAULT PROTECTION RELAY SHALL BE MOUNTED TO THE DOOR OF THE PANEL INCOMER CONTROL CUBICLE.
4. VAM 10LDSE INTERFACE SHALL BE MOUNTED ON THE CABLE ZONE DOOR.
5. MAXIMUM 16 VAM10LDSE I/O UNITS IN SERIES.
6. MAXIMUM LENGTH OF VX001 CABLE BETWEEN 2 UNITS (I/O UNITS OR VAMP321 UNIT) IS 30m & TOTAL LENGTH OF THE BUS CABLE FROM THE START TO THE END OF 100m SHALL NOT BE EXCEEDED.

LEGEND

FxxSRxxx-COMx — CABLE MARKER LABEL

24VDC SUPPLY CABLE

COMMUNICATION CABLE

DIP SWITCHES KEY VAMP 10LDSE		
	ON	OFF
SW8	1	0
SW7	2	0
SW6	4	0
SW5	8	0
SW4	16	0
SW3	L>	L> + I>
SW2	LATCH	NON LATCHING
SW1	L> INT	L> EXT

L = LIGHT / I = CURRENT

AS BUILT

REFERENCES	DWG No	REV	DATE	REVISION	DRN	CHK	TECH APP	PROJ APP
FIM III BOOSTER STATION CONTROL SYSTEM & COMMUNICATIONS BLOCK DIAGRAM	2000-F23-BLK-IC-40001				MZ	JC		MB
F23-SW-602 LV MOTOR CONTROL CENTRE 24VDC DISTRIBUTION SCHEMATIC DIAGRAM	2000-F23-SCM-EL-40014	1	13.MAR.26	AS BUILT FOR FIM III TSF	MZ	EA	MC	MBB
F23-SW-602 LV MOTOR CONTROL CENTRE INCOMER SCHEMATIC DIAGRAM SHEET 2	2000-F23-SCM-EL-40012	0	24.MAR.25	APPROVED FOR CONSTRUCTION	PM	KVN	DK	TH

NORTHERN STAR RESOURCES LIMITED

DRA PACIFIC (PTY) LIMITED

DRAWN	[redacted]	11.NOV.2024
CHECKED	J.Y.WEE	11.[redacted].2024
DESIGNED	[redacted]	11.NOV.2024
TECH APP	[redacted]	09.DEC.2024
PROJ APP	[redacted]	21.MAR.2025
CLIENT APP		

PROJECT: KCGM
FIM TSF PROJECT
[redacted] FIM III BOOSTER STATION
F23-SW-602 LV MOTOR CONTROL CENTRE
ARC FLASH CONNECTION DIAGRAM

[redacted]1 | SCALE NTS | DRG No. 2000-F23-SCM-EL-40013 | REV 1