
Docusign Envelope ID: D3EAC8FF-146A-4610-AFF4-26203B4BB02C

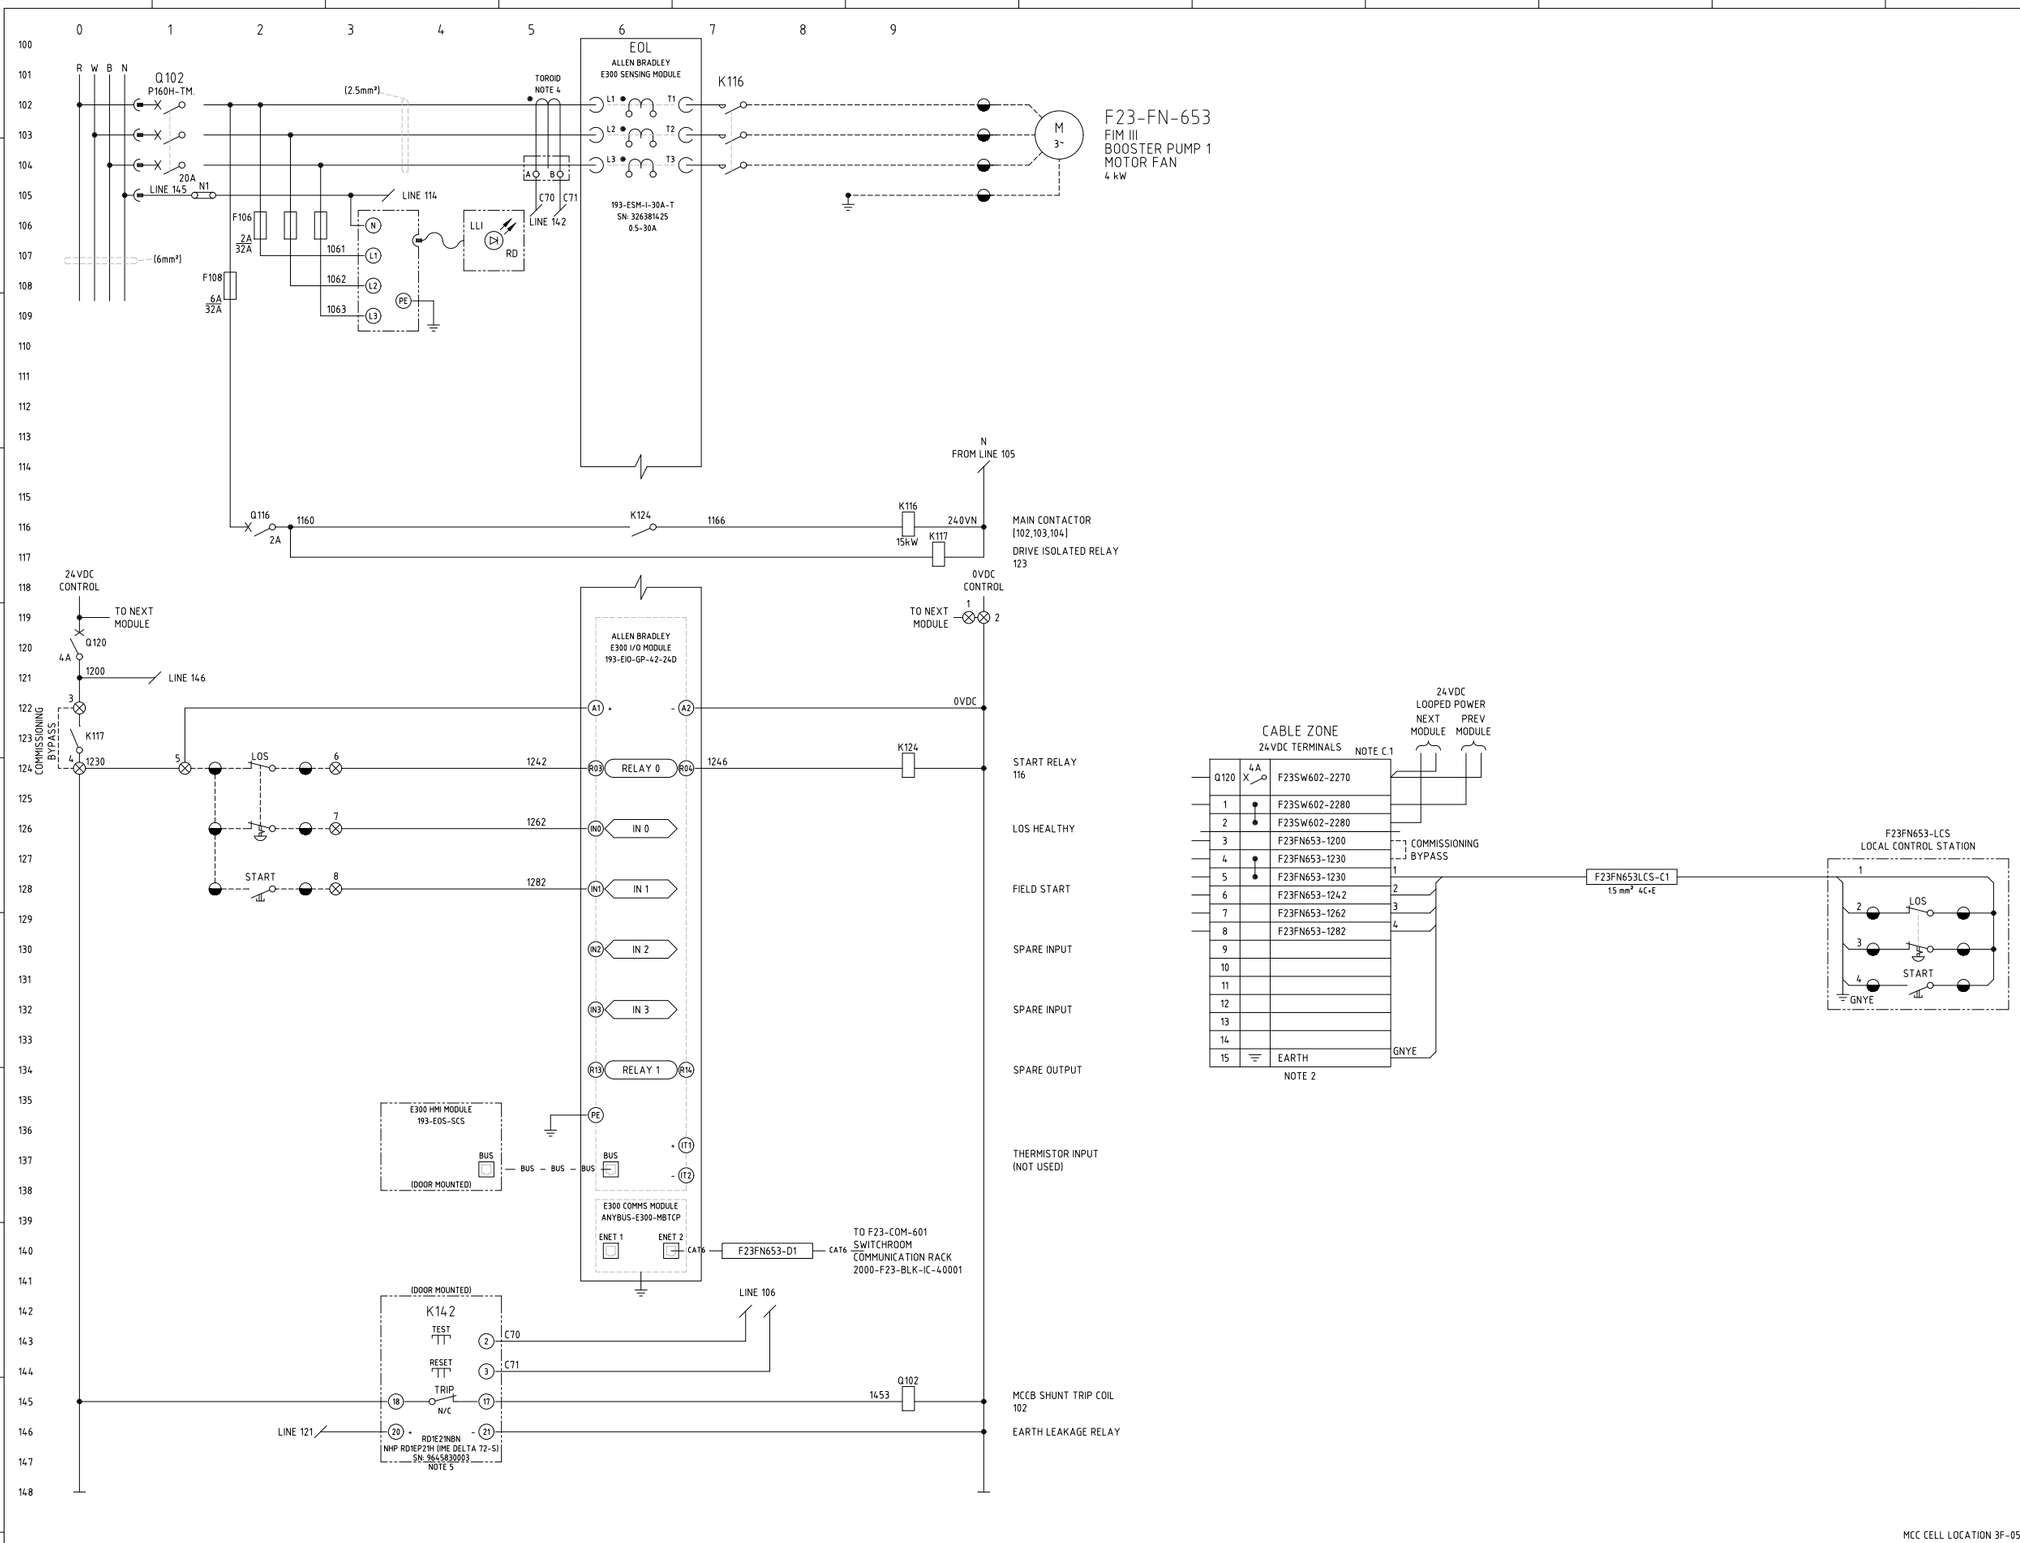


NOTES

1. TERMINALS ON TERMINAL STRIPS ABOVE 50VAC SHALL HAVE A SEPARATE PERSPEX SHROUD AND SHALL BE LABELLED "DANGER xxxVAC".
2. WIRE NUMBER FERRULES ON TERMINAL STRIP SHALL BE PREFIXED WITH EQUIPMENT NUMBER e.g. F23FN653-1200.
3. EACH WIRE SHALL BE IDENTIFIED AT BOTH ENDS WITH FERRULES.
4. NHP TDG×2 TOROID TO SUIT CABLE DIAMETER.
   TOROID DETAILS
   TDGB2
   SN: 0461520095
   IN: 70A
5. EARTH LEAKAGE RELAY USER INTERFACE TO BE MOUNTED ON MCC MODULE DOOR.
   RELAY SETTINGS SET TO:
   IΔn ="1A".
   DELAY = "100ms".
   RANGES = "x1".
   FAILSAFE MODE = "Ne".
   RESET = "MAN".
6. REFER TO CABLE SCHEDULE 2000-F23-LST-EL-40003.

LEGEND

- 00/01/00 — DCS DIGITAL INPUT
- 00/02/00 — DCS DIGITAL OUTPUT
- ⊗ — MCC TERMINAL
- ◒ — VSD TERMINAL
- ◒ — FIELD TERMINAL
- ◑ — DCS OR I/O TERMINAL
- ◧ — MARSHALLING TERMINAL
- ⊗ — DEVICE TERMINAL
- ⊗ cc — INDICATION LAMP, cc = COLOUR

TERMINATION LEGEND

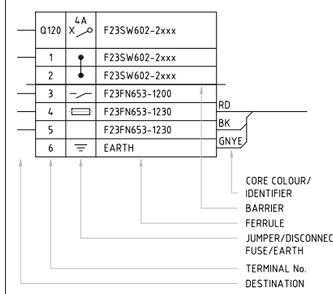

CONSTRUCTION NOTES

C.1 TO BE DETERMINED BY MCC VENDOR

AS BUILT

MCC CELL LOCATION 3F-05

REFERENCES	DWG No	REV	DATE	REVISION	DRN	CHK	TECH APP	APP
		3	13.MAR.26	AS BUILT FOR FIM III TSF	[redacted]	EA	MC	[redacted]
		2	07.JUL.25	RE-APPROVED FOR CONSTRUCTION	TG	KVN	[redacted]	
F23-SW-602 LV MOTOR CONTROL CENTRE SINGLE LINE DIAGRAM SHT 2 OF 2	2000-F23-SLD-EL-40012	1	17.MAR.25	RE-APPROVED FOR CONSTRUCTION	[redacted]	KVN		
GENERAL NOTES AND STANDARD DRAWINGS INDEX	2000-F00-STD-EL-10001	0	17.JAN.25	APPROVED FOR CONSTRUCTION		KVN		

NORTHERN STAR RESOURCES LIMITED

DRA PACIFIC (PTY) LIMITED

[redacted]	[redacted]	02.DEC.2024
CHECKED	[redacted]	19.DEC.2024
DESIGNED	[redacted]	20.NOV.2024
TECH APP	K[redacted]	20.DEC.2024
[redacted] APP	[redacted]	17.[redacted].2025
CLIENT APP		

PROJECT: KCGM
FIM TSF PROJECT

TITLE: FIM III BOOSTER STATION
F23-FN-653 FIM III BOOSTER PUMP 1 MOTOR FAN
CONTROL SCHEMATIC DIAGRAM

[redacted] SCALE NTS DRG No. 2000-F23-SCM-EL-40026 REV 3