

Docusign Envelope ID: D3EAC8FF-146A-4610-AFF4-26203B4BB02C

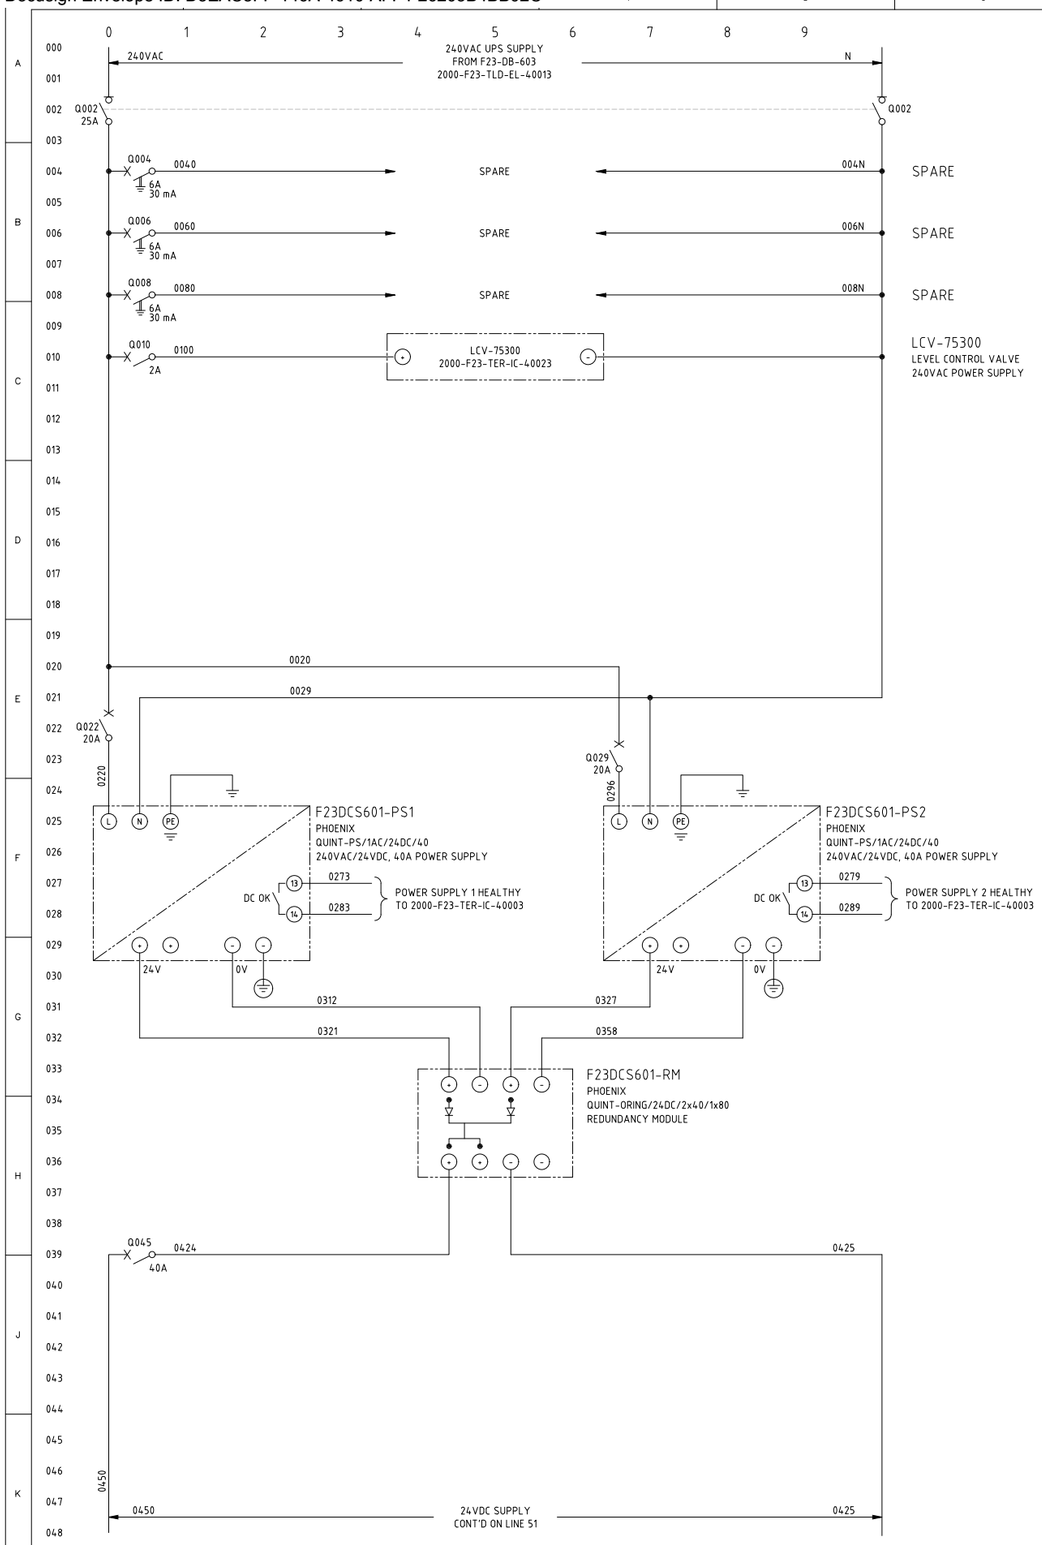

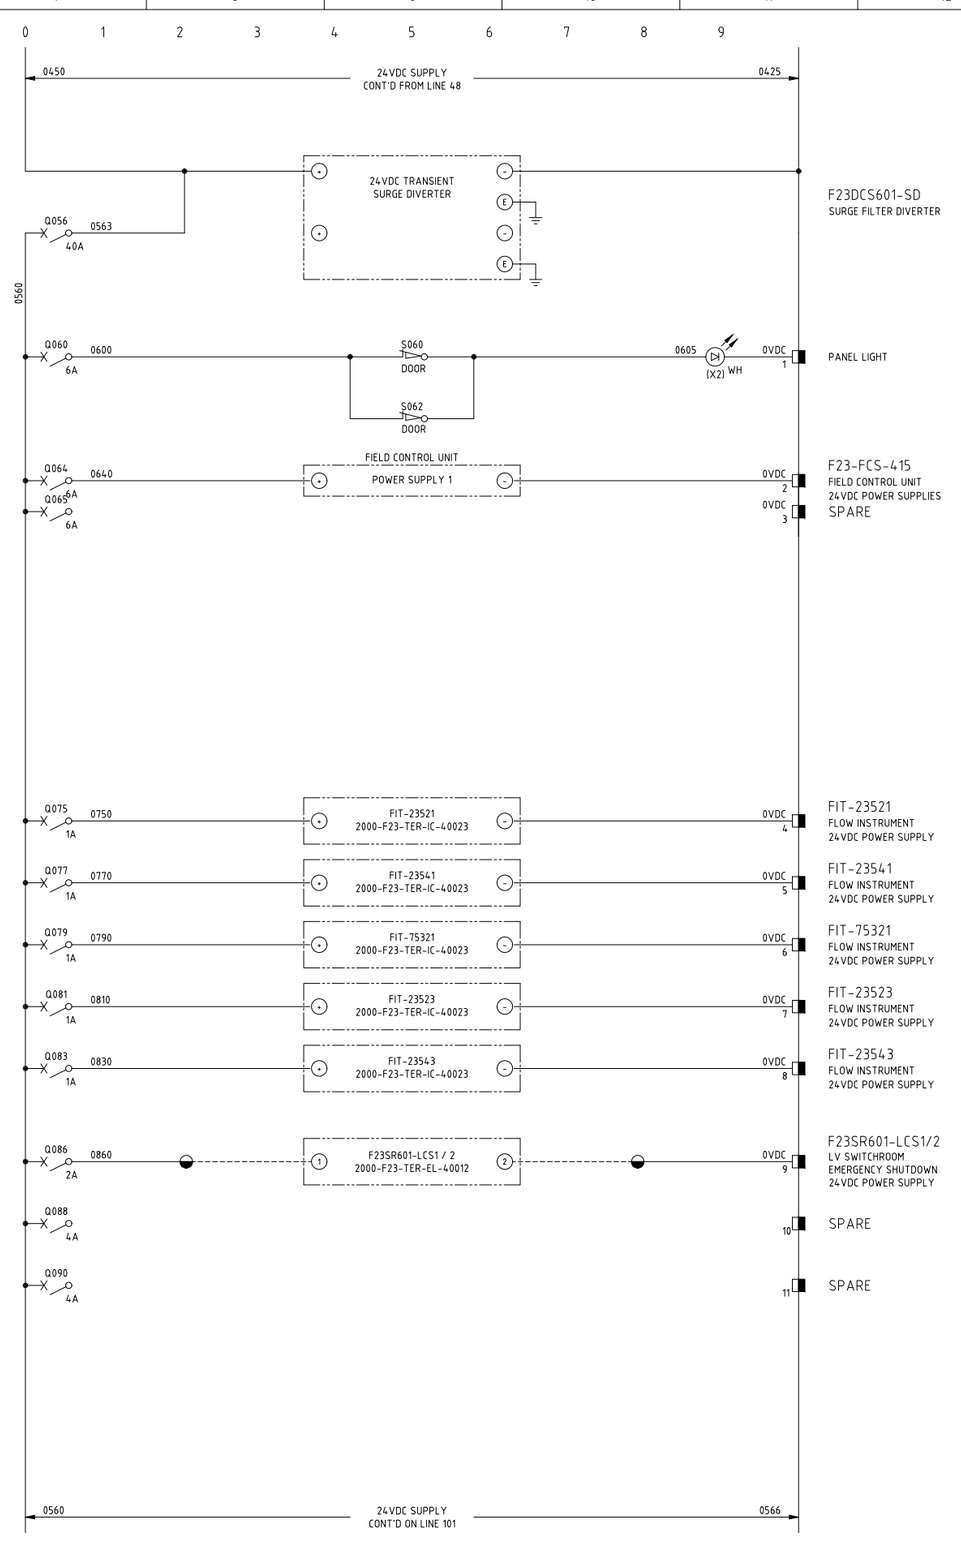

NOTES

1. TERMINALS ON TERMINAL STRIPS ABOVE 50VAC SHALL HAVE A SEPARATE PERSPEX SHROUD AND SHALL BE LABELLED "DANGER xxxVAC".
2. WIRE NUMBER FERRULES ON TERMINAL STRIP SHALL BE PREFIXED WITH EQUIPMENT NUMBER e.g. FxxPPxxx-1200.
3. EACH WIRE SHALL BE IDENTIFIED AT BOTH ENDS WITH FERRULES.
4. FOR NETWORK CONNECTION & BUS CABLING DETAILS REFER TO: DCS OR RIO PANEL COMMUNICATIONS TERMINATION DIAGRAMS.

LEGEND

- FIELD TERMINAL
- DCS OR I/O TERMINAL
- MARSHALLING TERMINAL
- DEVICE TERMINAL
- INDICATION LAMP (cc = COLOUR)
- EARTH BAR
- INSTRUMENT EARTH BAR

AS BUILT

REFERENCES	DWG No	REV	DATE	REVISION	DRN	CHK	TECH APP	PROJ APP
FIM III BOOSTER STATION – F23-SR-601 – HV/LV SWITCHROOM COMMUNICATIONS BLOCK DIAGRAM	2000-F23-BLK-IC-40001	3	13.MAR.26	AS BUILT FOR FIM III TSF	[redacted]	[redacted]	[redacted]	MBB
FIM III BOOSTER STATION – F23-DCS-601 – DCS CABINET SCHEMATIC DIAGRAM SHEET 2	2000-F23-SCM-IC-40003	2	20.NOV.25	RE-APPROVED FOR CONSTRUCTION				TH
FIM III BOOSTER STATION – F23-DCS-601 – DCS CABINET GENERAL ARRANGEMENT	2000-F23-DRG-IC-40002	1	10.JUL.25	RE-APPROVED FOR CONSTRUCTION				TH
FIM III BOOSTER STATION – F23-DB-603 – HV/LV SWITCHROOM 240VAC UPS DB THREE LINE DIAGRAM	2000-F23-TLD-EL-40013	0	14.APR.25	APPROVED FOR CONSTRUCTION				TH

NORTHERN STAR RESOURCES LIMITED

DRA PACIFIC (PTY) LIMITED

[redacted]	[redacted]	28.JAN.2025
CHECKED	[redacted]	05.FEB.2025
DESIGNED	[redacted]	05.FEB.2025
TECH APP	[redacted]	10.MAR.2025
[redacted] APP	T. HAMDORF	14.APR.2025
CLIENT APP		

PROJECT: KCGM
FIM – TSF PROJECT

TITLE: FIM III BOOSTER STATION
F23-DCS-601 – DCS CABINET
SCHEMATIC DIAGRAM – SHEET 1

A1 | SCALE NTS | DRG No. 2000-F23-SCM-IC-40002 | REV 3