

Docusign Envelope ID: D3EAC8FF-146A-4610-AFF4-26203B4BB02C

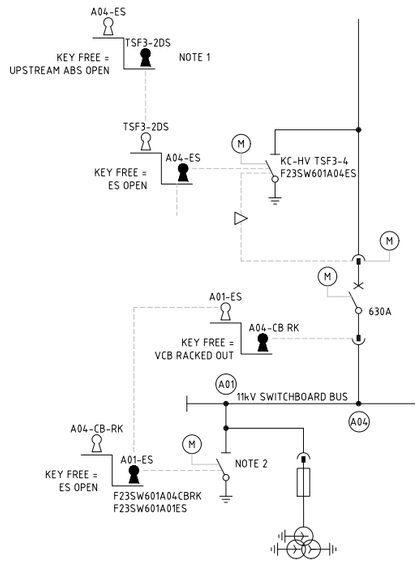


F23-SW-601 11kV INCOMER & BUS
EARTH SWITCH KEY
INTERLOCKING SCHEME
ALL INTERLOCKING IS SINGLE KEY
1 OUT OF 2 INTERLOCKING

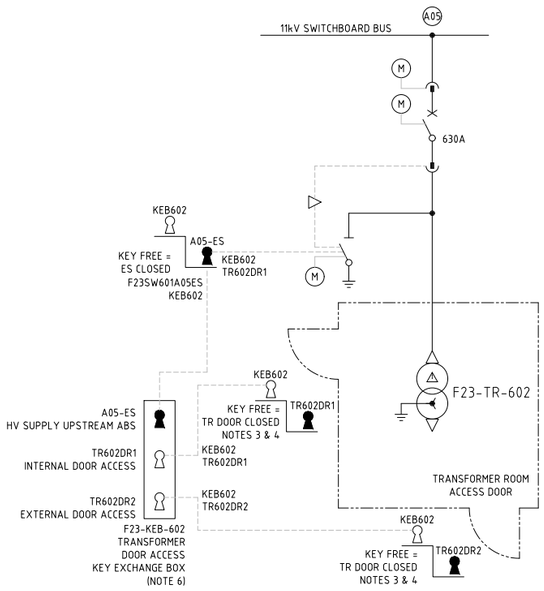

F23-SR-601
FIM III BOOSTER STATION HV /LV SWITCHROOM

11kV FEEDER TO 415V SWITCHROOM
TRANSFORMER ACCESS DOOR
KEY INTERLOCKING SCHEME

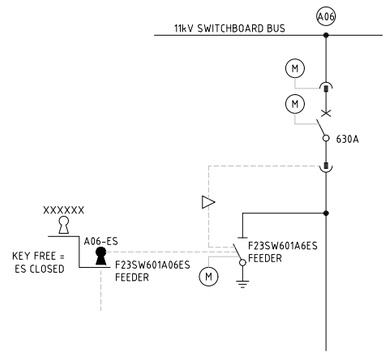

F23-SR-601
FIM III BOOSTER STATION HV /LV SWITCHROOM

11kV FEEDER SPARE


NOTES

1. UPSTREAM OVERHEAD LINE POLE ,MOUNTED DISCONNECTOR SWITCH KEY INTERLOCKED WITH THE 11kV SWITCHBOARD INCOMER EARTH SWITCH SUCH THAT THE UPSTREAM 33kV DISCONNECTOR SWITCH CAN ONLY BE CLOSED WHEN THE INCOMER EARTH SWITCH IS OPEN.
2. 11kV BUS EARTH SWITCH AND INCOMER CIRCUIT BREAKER SHALL BE KEY INTERLOCKED SUCH THAT BUS EARTH SWITCH CANNOT BE CLOSED WHILE INCOMER CIRCUIT BREAKER IS RACKED IN.
3. 415V MCC TRANSFORMER ROOM ACCESS DOORS SHALL BE FORTRESS KEY INTERLOCKED WITH THE UPSTREAM 11kV FEEDER EARTH SWITCH.
4. TRANSFORMER ENCLOSURE DOOR STATUS SHALL BE MONITORED BY THE DCS. OPENING THE DOOR SHALL RAMP STOP THE RELEVANT SWITCHROOM AREA AND OPEN THE UPSTREAM CIRCUIT BREAKERS.
5. HV VSD ACCESS DOORS SHALL BE FORTRESS KEY INTERLOCKED WITH THE UPSTREAM FEEDER EARTH SWITCH.
6. LOCATE KEY EXCHANGE BOX INSIDE SWITCHROOM ADJACENT TO TRANSFORMER INTERNAL ACCESS DOOR.

LEGEND


- MECHANICAL OR ELECTRICAL INTERLOCK DEVICE
- KEY FREE
- KEY CAPTIVE
- KEY EXCHANGE BOX

F23-PP-651
FIM III BOOSTER PUMP 1

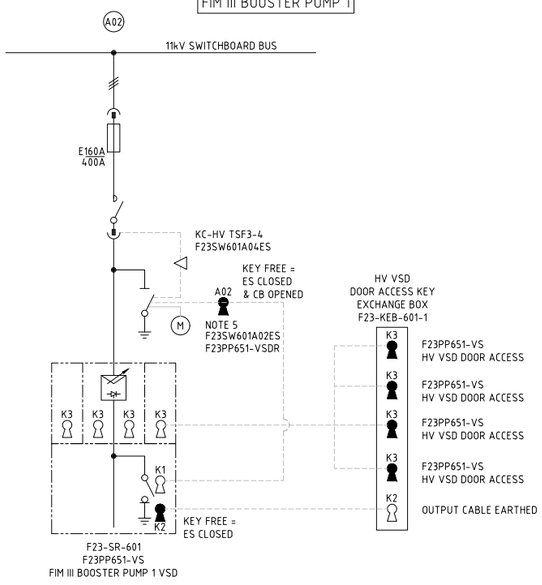

11kV FEEDER TO HV VSD
MAIN PANEL ACCESS DOOR
KEY INTERLOCKING SCHEME

F23-PP-652
FIM III BOOSTER PUMP 2

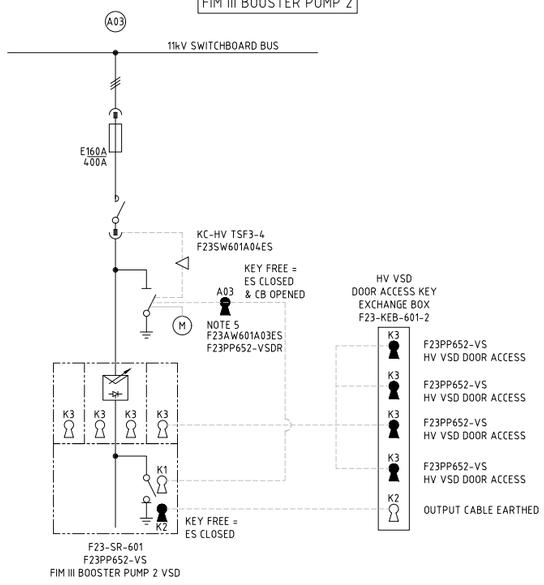

11kV FEEDER TO HV VSD
MAIN PANEL ACCESS DOOR
KEY INTERLOCKING SCHEME

AS BUILT

REFERENCES	DWG No	REV	DATE	REVISION	DRN	CHK	TECH APP	PROJ APP
		2	16.MAR.26	AS-BUILT FOR FIM III TSF	ET	[redacted]	[redacted]	MBB
F23-SW-601 HV SWITCHBOARD SINGLE LINE DIAGRAM	2000-F23-SLD-EL-40001	1	22.JUL.25	RE-ISSUED FOR CONSTRUCTION	MT	[redacted]		TH
F23-SW-602 LV MOTOR CONTROL CENTRE SINGLE LINE DIAGRAM SHT 1 OF 2	2000-F23-SLD-EL-40011	0	17.JAN.25	ISSUED FOR CONSTRUCTION	TG	KVN	KVN	TH

NORTHERN STAR RESOURCES LIMITED

DRA PACIFIC (PTY) LIMITED

[redacted]	[redacted]	11.NOV.2024
CHECKED	[redacted]	11.NOV.2024
DESIGNED	[redacted]	11.NOV.2024
TECH APP	P.[redacted]	26.NOV.2024
[redacted]APP		
CLIENT APP		

PROJECT: KCGM
FIM TSF PROJECT

TITLE: FIM III BOOSTER STATION
F23-SW-601 HV SWITCHBOARD
KEY INTERLOCKING SINGLE LINE DIAGRAM

A1 | SCALE NTS | DRG No. 2000-F23-SLD-EL-40002 | REV 2