
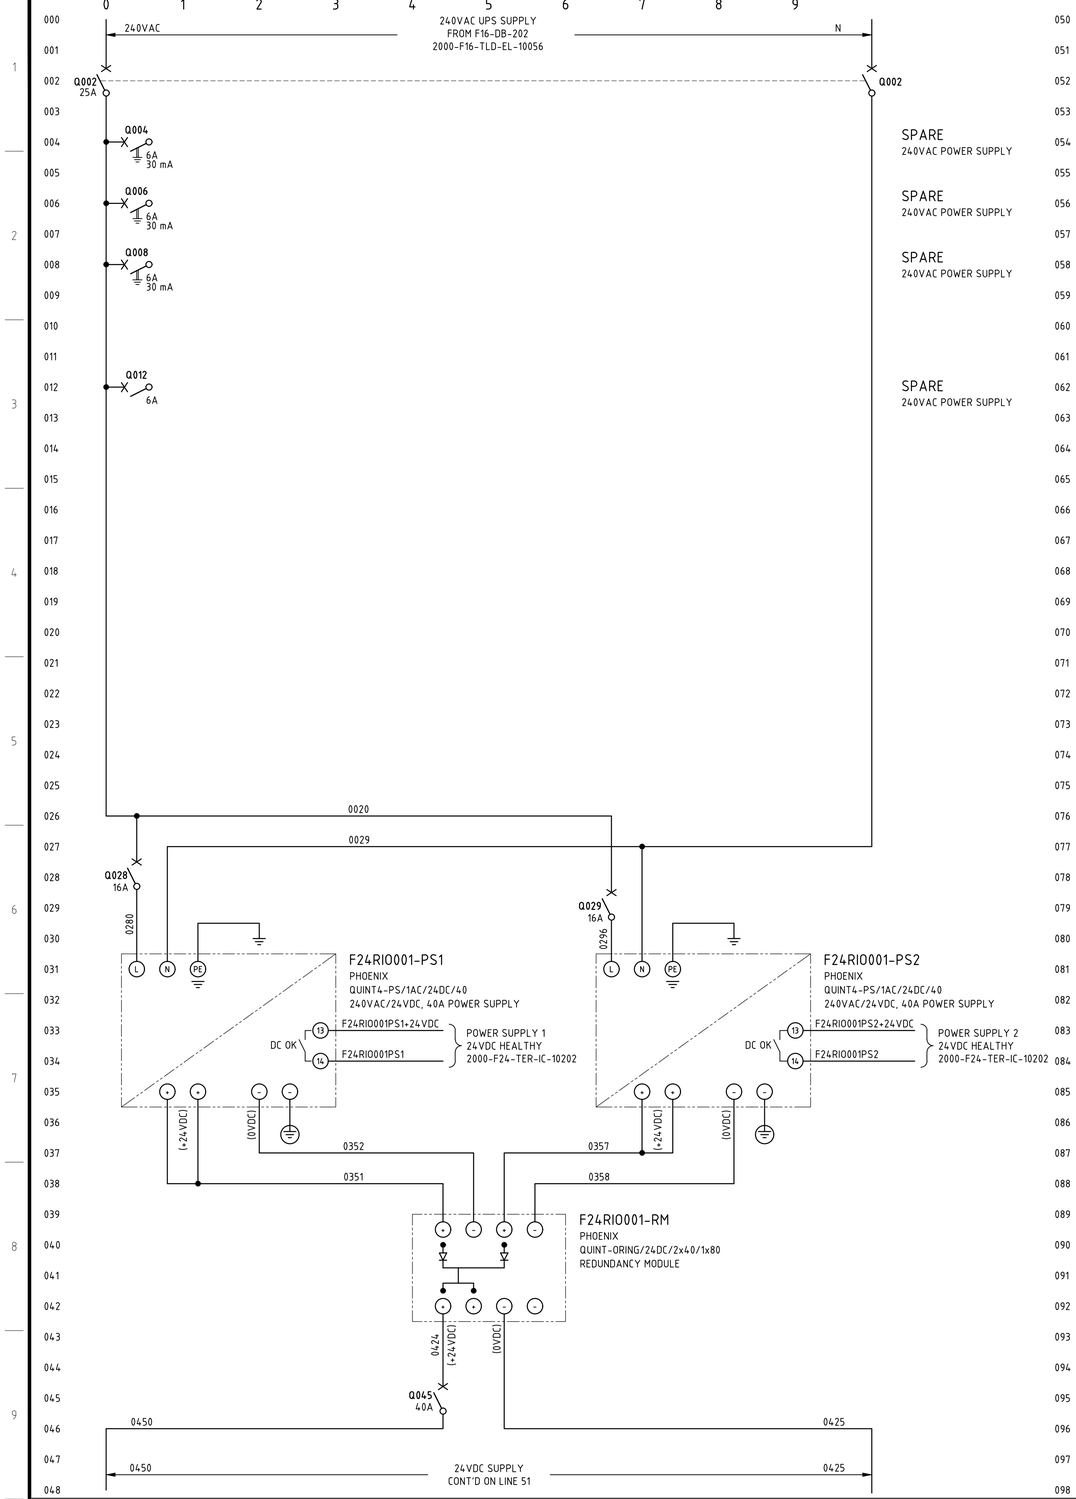


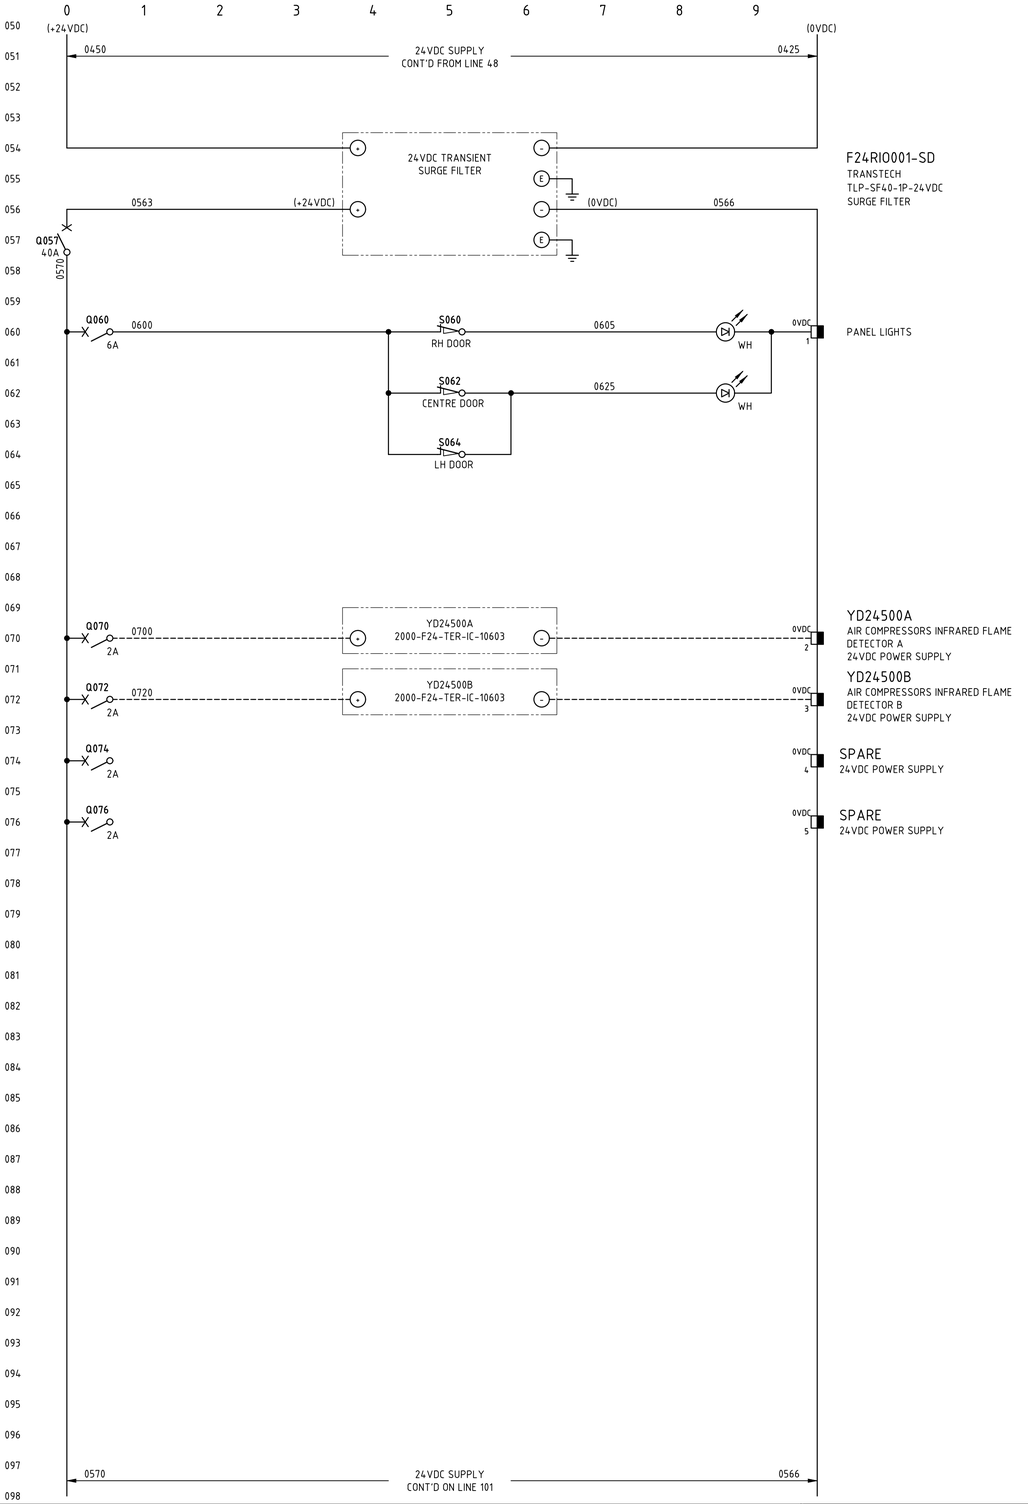

NOTES

1. TERMINALS ON TERMINAL STRIPS ABOVE 50VAC SHALL HAVE A SEPARATE PERSPEX SHROUD AND SHALL BE LABELLED "DANGER xxxVAC".
2. WIRE NUMBER FERRULES ON TERMINAL STRIP SHALL BE PREFIXED WITH EQUIPMENT NUMBER e.g. F24RIO001-xxxx.
3. EACH WIRE SHALL BE IDENTIFIED AT BOTH ENDS WITH FERRULES.
4. FOR NETWORK CONNECTION & BUS CABLING DETAILS REFER TO RIO PANEL COMMUNICATIONS TERMINATION DIAGRAMS.
5. INSTRUMENT EARTH BAR TO BE BONDED TO MAIN EARTH BAR WITH SOLID COPPER LINK.

LEGEND

- FIELD TERMINAL
- DCS OR I/O TERMINAL
- MARSHALLING TERMINAL
- DEVICE TERMINAL
- INDICATION LAMP (cc = COLOUR)
- EARTH BAR
- INSTRUMENT EARTH BAR

AS CONSTRUCTED

CHANGE: ☐ NO CHANGE: ☒

SIGNATURE: J. Hamilton
NAME: J. Hamilton
DATE: 29/01/2026

ENGINEER SIGN OFF

SIGNATURE: Akmal
NAME: Mohd Akmal Bin Ismail
DATE: 05/02/2026

2000-F24-SCM-IC-10601_Rev0A

Plant air F24-RIO-001 air services field n-IO panel schematic diagram sheet 1

O:\CAD PROJECTS\235 NORTHERN STAR RESOURCES LTD\235I7 KCGM GROWTH PROJECT\03 DELIVERABLES\IC\F24 - AIR & WATER SERVICES\2000-F24-SCM-IC-10601.DWG 04MAR25 2:13PM SANDRA CULL