
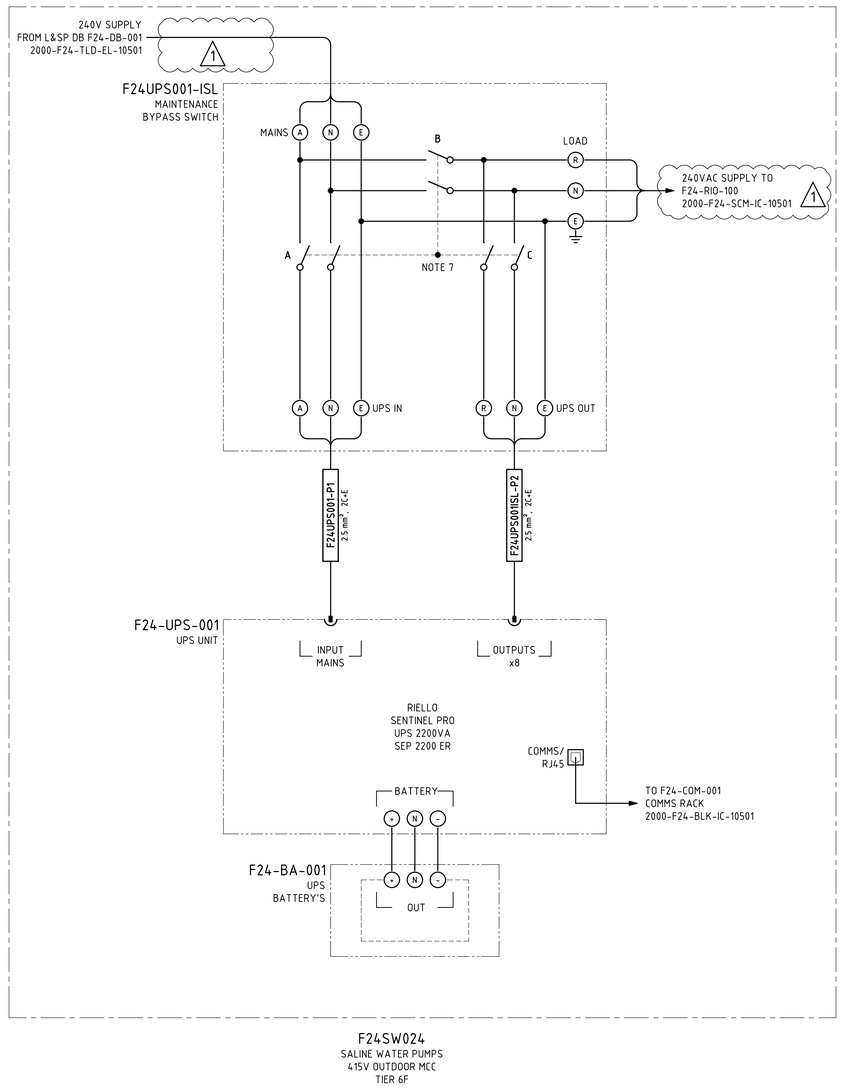


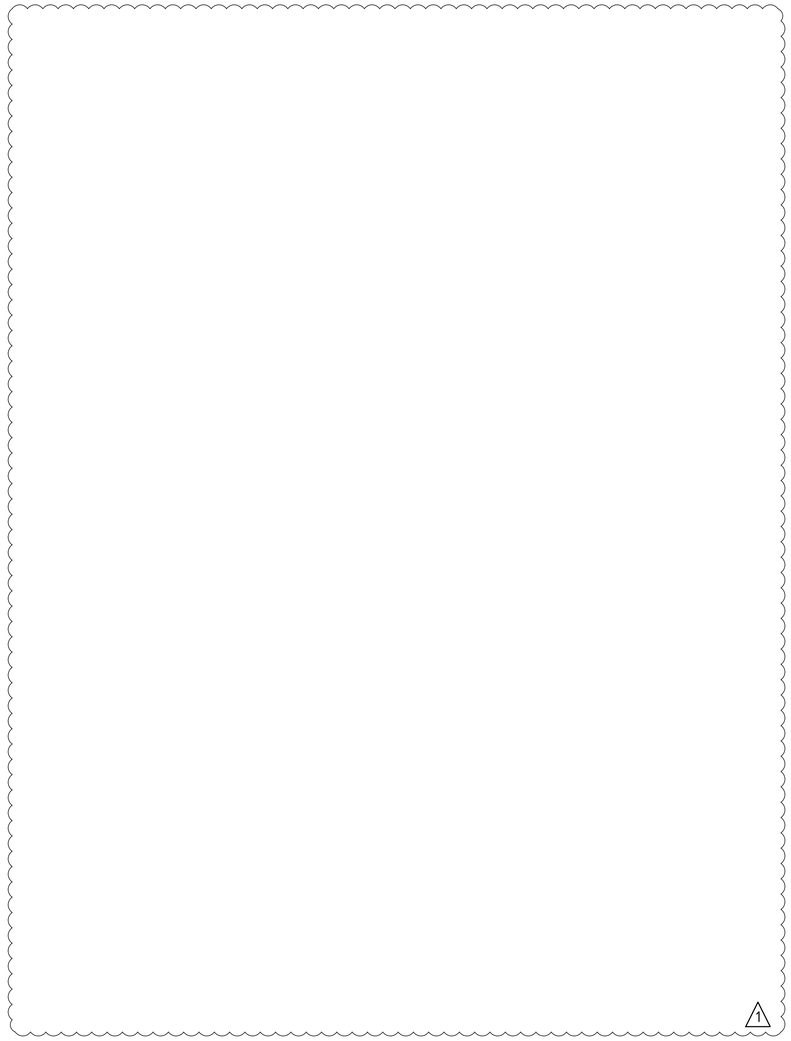

NOTES

1. CIRCUIT BREAKERS SHALL BE PAD-LOCKABLE IN THE 'OFF' POSITION ONLY, VIA LOCK-DOGS OR SIMILAR, LOCKING TO ESCUTCHEON SHALL NOT BE ACCEPTABLE.
2. ALL SPARE SPACE SHALL BE FILLED WITH DUMMY CIRCUIT BREAKERS, ESCUTCHEON POLE FILLERS SHALL NOT BE ACCEPTABLE.
3. EQUIPOTENTIAL BONDING CONDUCTOR SHALL BE INSTALLED FROM DB EARTH BAR TO SWITCHROOM EARTH BAR OR NEAREST EARTHED STRUCTURE VIA 35mm² Cu GNYE/PVC OR AS PER CABLE SCHEDULE.
4. AS-BUILT CIRCUIT SCHEDULE SHALL BE KEPT INTERNAL TO DISTRIBUTION BOARD AT ALL TIMES.
5. MINIMUM 20% SPARE CIRCUIT BREAKERS AND ADDITIONAL 20% SPARE SPACE SHALL BE PROVIDED FOR FUTURE LOADS.
6. DISTRIBUTION BOARD SHALL BE CONSTRUCTED IN ACCORDANCE WITH STANDARD - 2000-F00-STS-EL-10007. LOW VOLTAGE DISTRIBUTION BOARDS SPECIFICATION.
7. UPS MAINTENANCE BYPASS SWITCH SHALL BE OF THE ROTARY 3-POSITION TYPE. POSITIONS AS FOLLOWS:
   NORMAL MODE: SWITCH A & C CLOSED
   BYPASS MODE: SWITCH A & B CLOSED
   BYPASS & ISOLATE MODE: SWITCH B CLOSED.

LEGEND

- ⊗ MCC TERMINAL
- ⊗ VSD TERMINAL
- ◒ FIELD TERMINAL
- ◑ PLC OR I/O TERMINAL
- ◧ MARSHALLING TERMINAL
- ◨ DISTRIBUTION BOARD TERMINAL
- ⓧ DEVICE TERMINAL
- ⊗cc INDICATION LAMP, cc = COLOUR
- ▭ DUMMY CIRCUIT BREAKER, NOTE 2

CONSTRUCTION DETAILS

No. OF POLES	12
MOUNTING	MOUNTING WITHIN F24-SW-024
MAIN SWITCH	160A SINGLE POLE
INTERNAL COLOUR	ESCUTCHEON GLOSS WHITE
EXTERNAL COLOUR	X15 ORANGE
LOCATION	LOCATED WITHIN F24-SW-024
IP RATING	IP4x MIN.
PANEL THICKNESS	N/A
MCB FAULT RATING	10kA
DOOR	N/A
MATERIAL	N/A
DOOR SEAL	N/A
GLAND PLATE SEAL	N/A

NORTHERN STAR RESOURCES LIMITED

Comments ☐

No Comments ☒

Signed	Date
C Laird	30/09/2025

ACCEPTANCE DOES NOT RELIEVE THE SUPPLIER / CONTRACTOR OF ITS RESPONSIBILITY OR LIABILITIES UNDER THE PURCHASE ORDER / CONTRACT

2000-F24-TLD-EL-10502_Rev1

F24-SW-024 - F24-DB-201 outdoor MCC 240VAC
UPS DB - three line diagram

O:\CAD PROJECTS\235 NORTHERN STAR RESOURCES LTD\23517 KCGM GROWTH PROJECT\03 DELIVERABLES\ELF24 - AIR & WATER SERVICES\2000-F24-TLD-EL-10502.DWG 16SEP25 4:05PM HOTSEAT04